



J. M. Allan
20/3/88
H/2

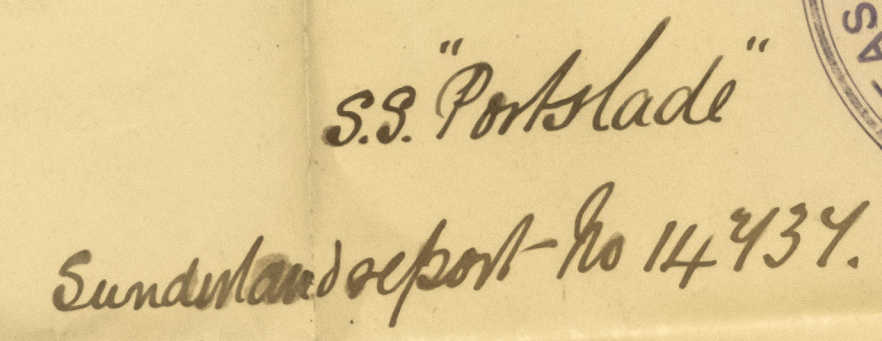

CONTRACT 378

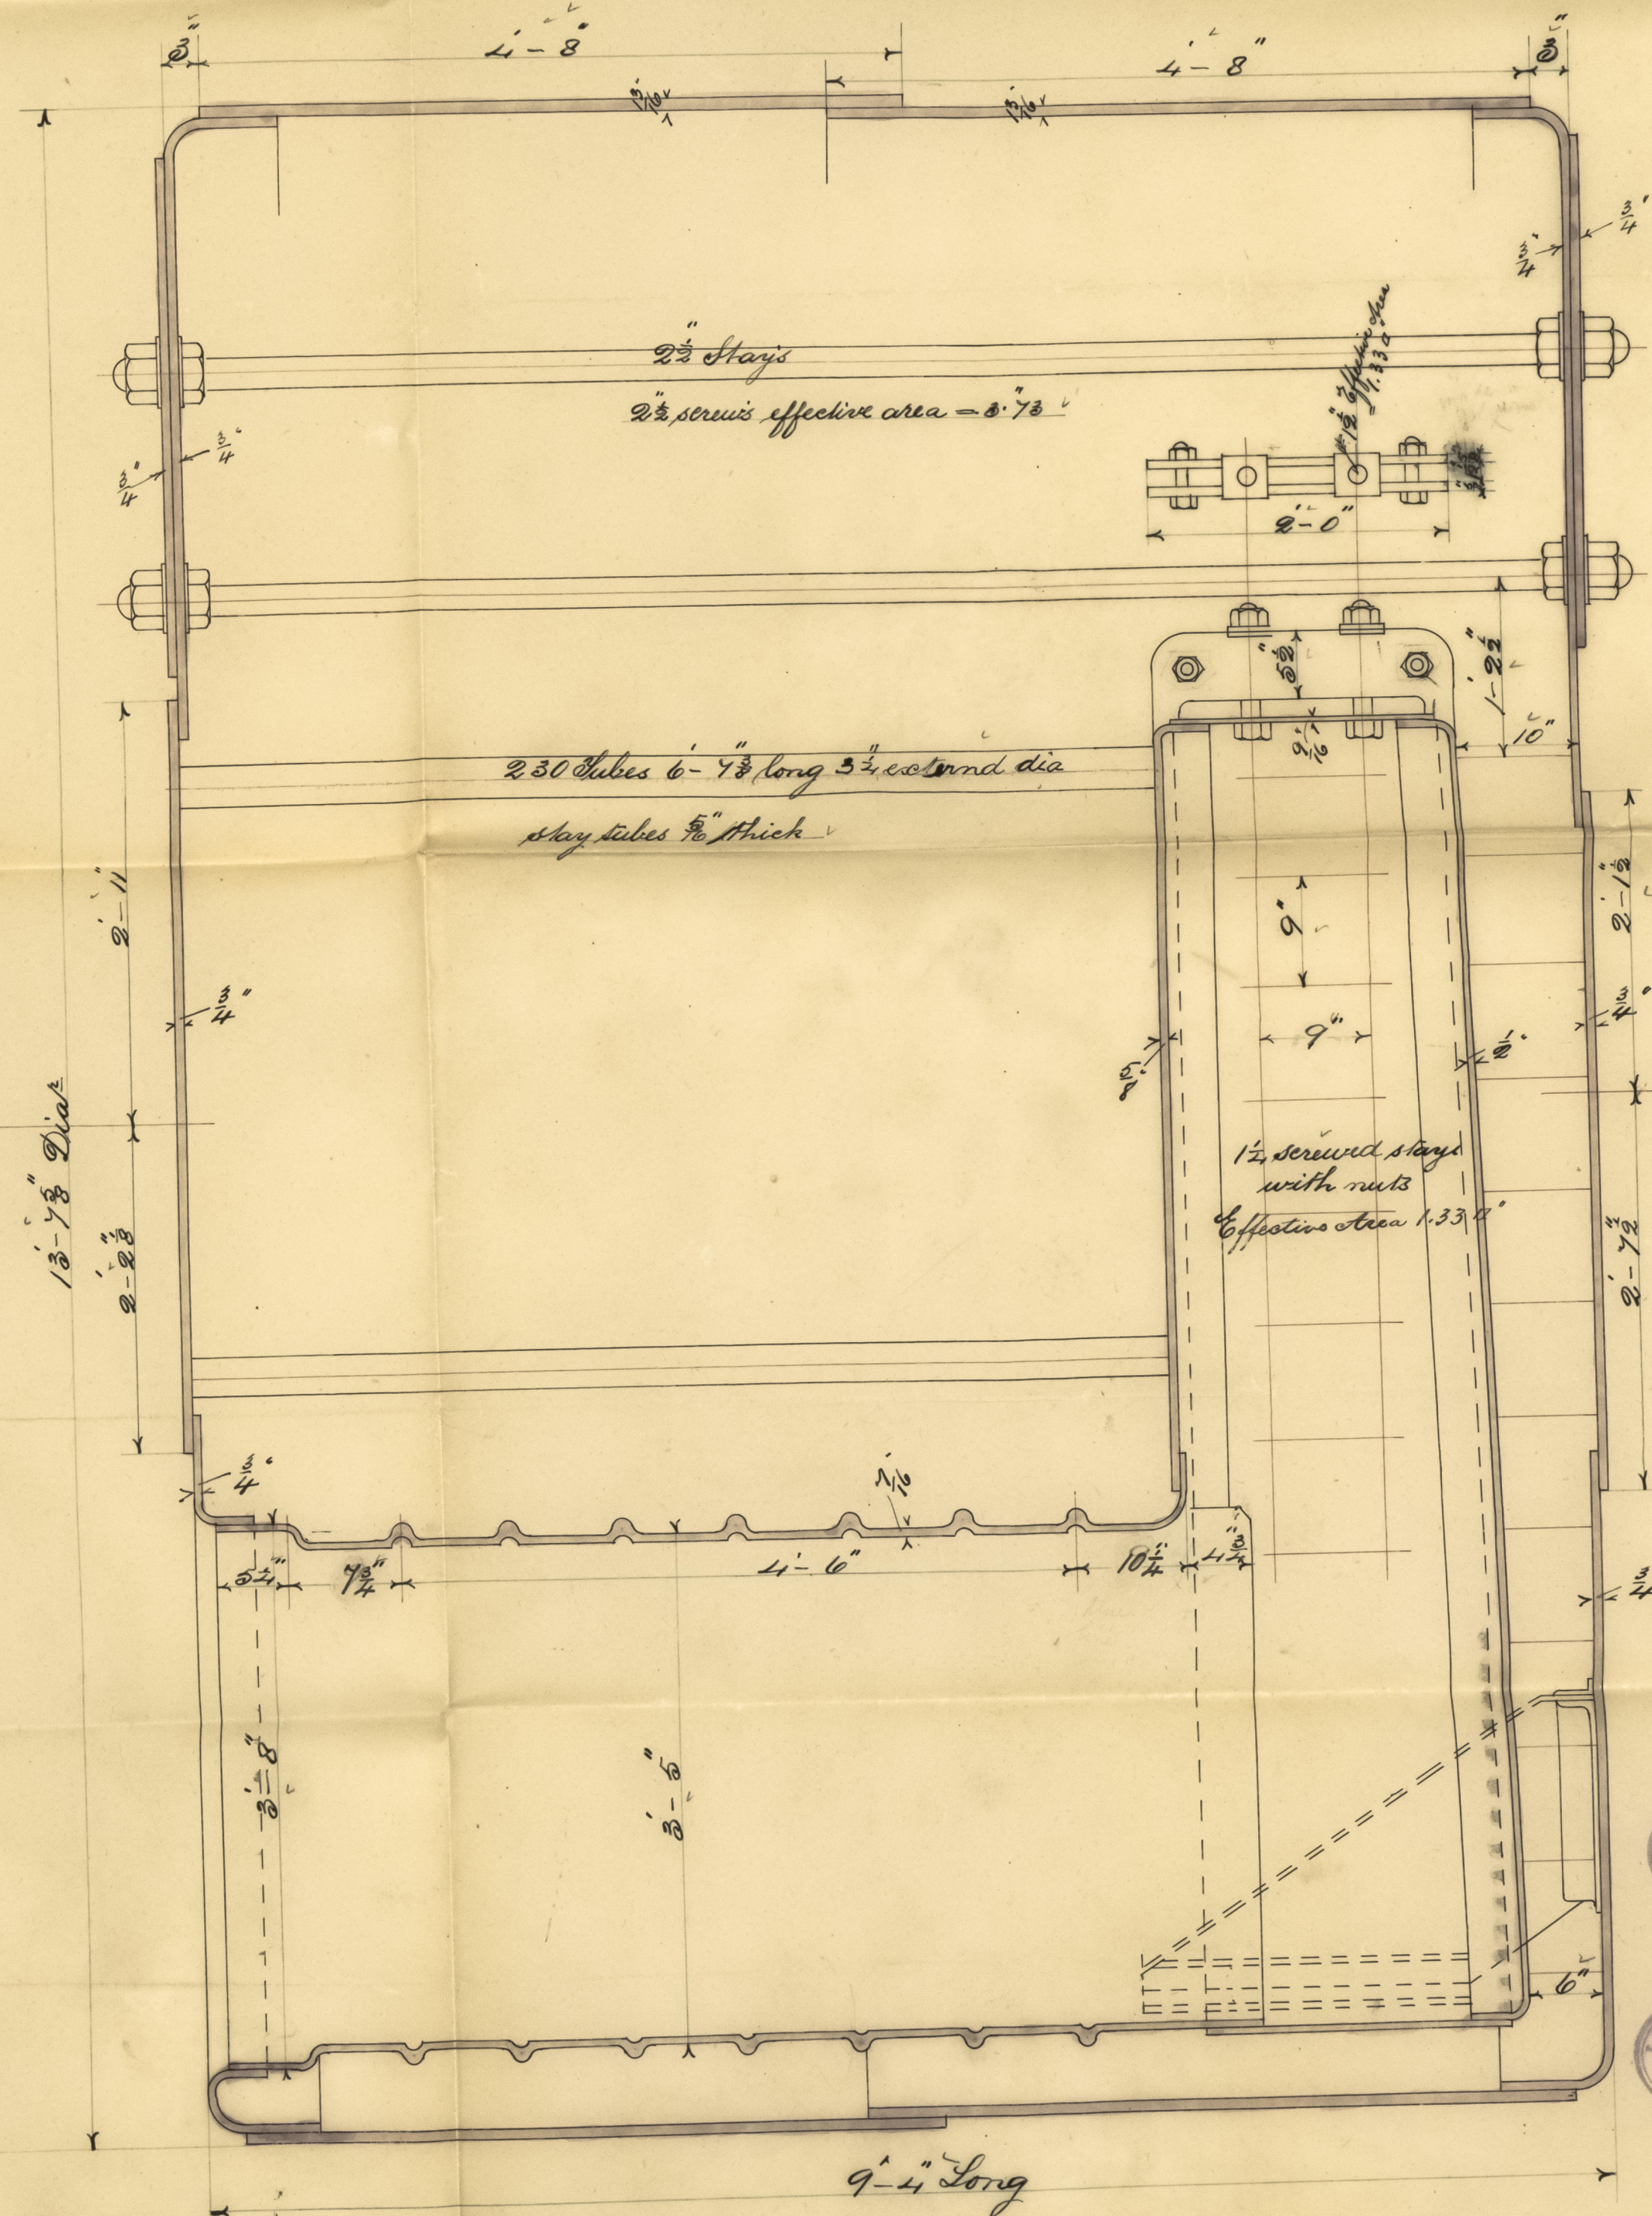


"
Mather
of Appleton about
1844

[illegible]

SLD958-0331

14434

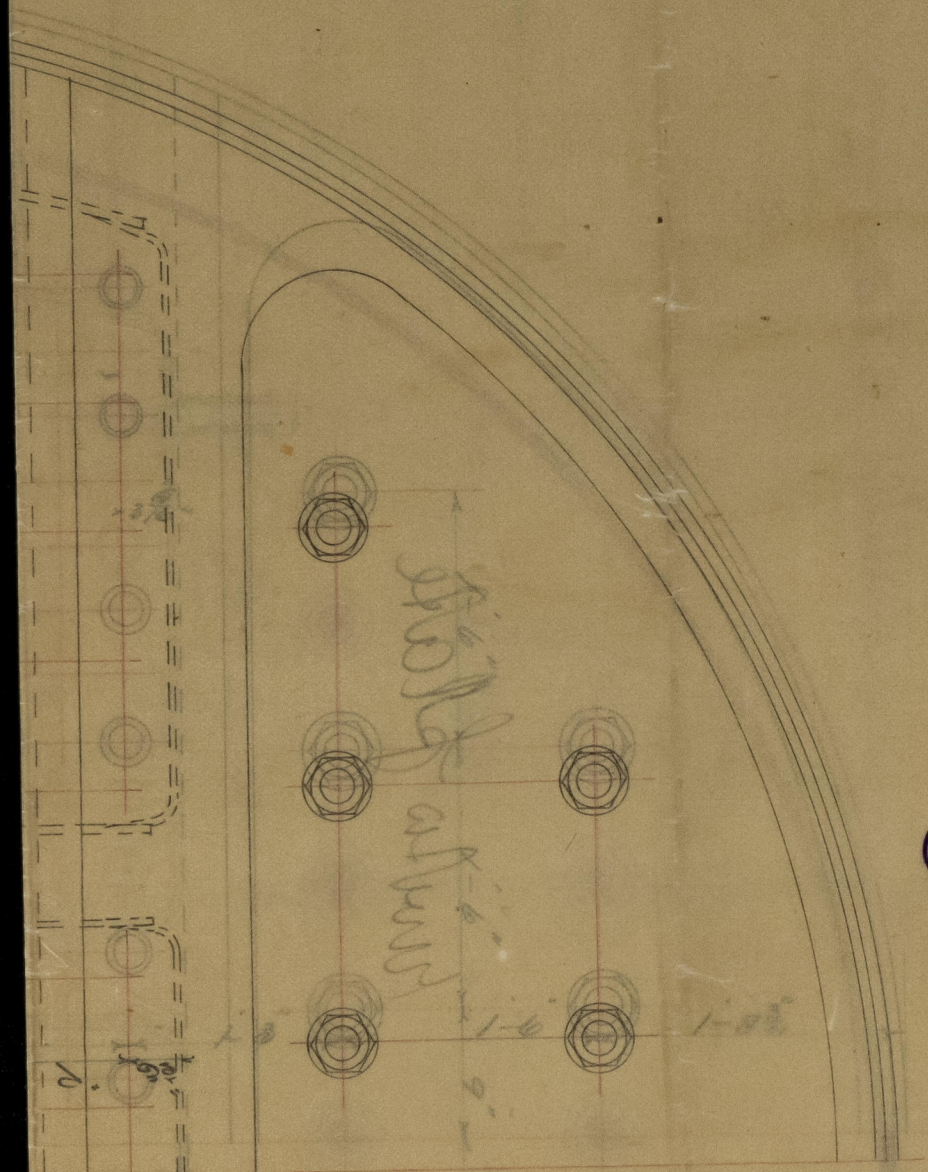

22 MAR 88
LONDON


10/11/88
10/11/88

© 2021

Lloyd's Register
Foundation