


2/2/88

JOHN BLUMER & CO
SHIPBUILDERS,
(NORTH DOCK)
SUNDERLAND
30 JANUARY 1888

G. B. Eneaton 14791.

— Arrangement of Beams, Bulkheads &c —

— S.S. 91. —



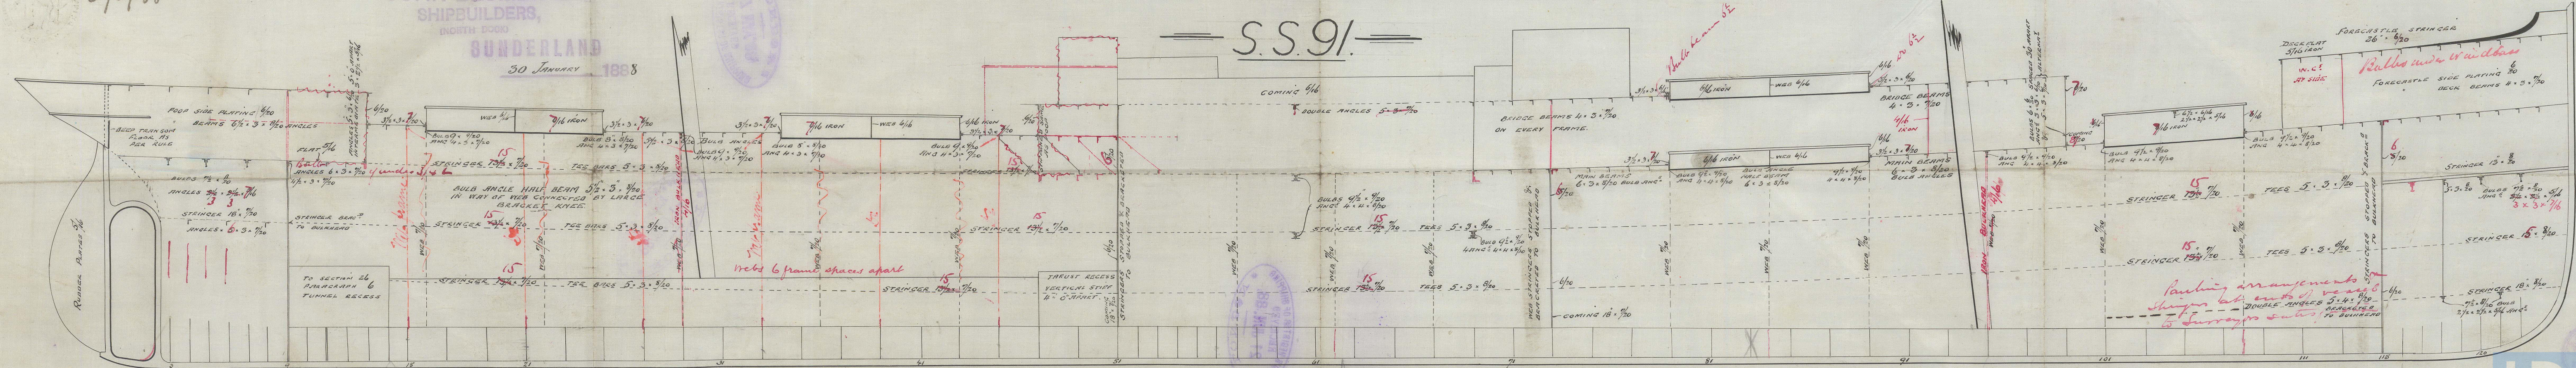


© 2021

Lloyd's Register
Foundation

SL0959-0197


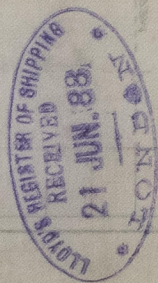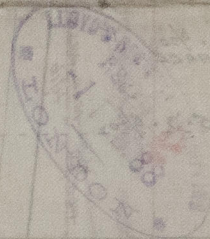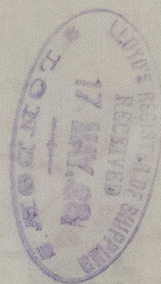

© 2021

Lloyd's Register
Foundation