

5050-0202

Let 22/5/88



# TANK SUCTION. S. S. N.º 91

1/5 Smeaton's Id. report No. 14, 1/91

JOHN BLUMER & CO  
SHIPBUILDERS,  
NORTH DOCK  
SUNDERLAND

MAY 14<sup>TH</sup> 1888  
18.5.88

RECEIVED  
17 MAY 88  
LLOYD'S REGISTER OF SHIPBUILDERS

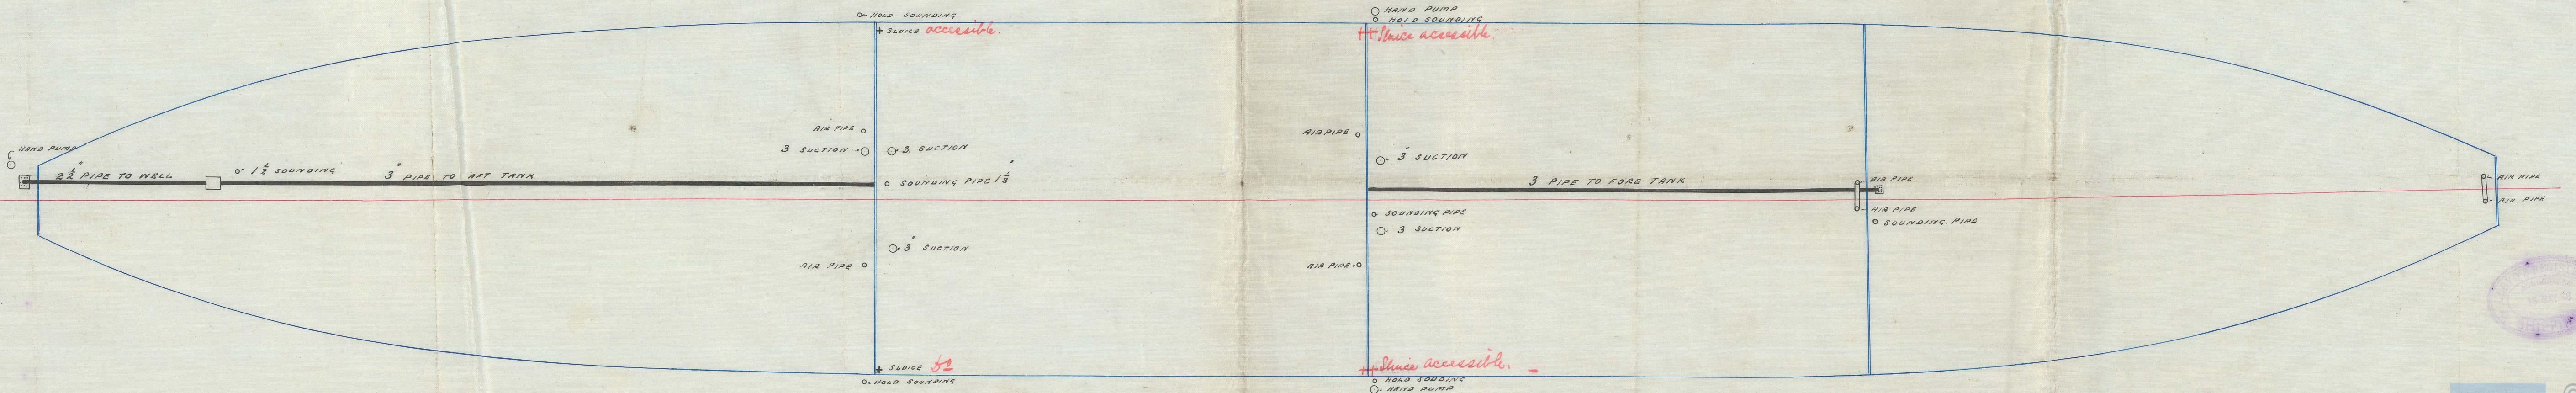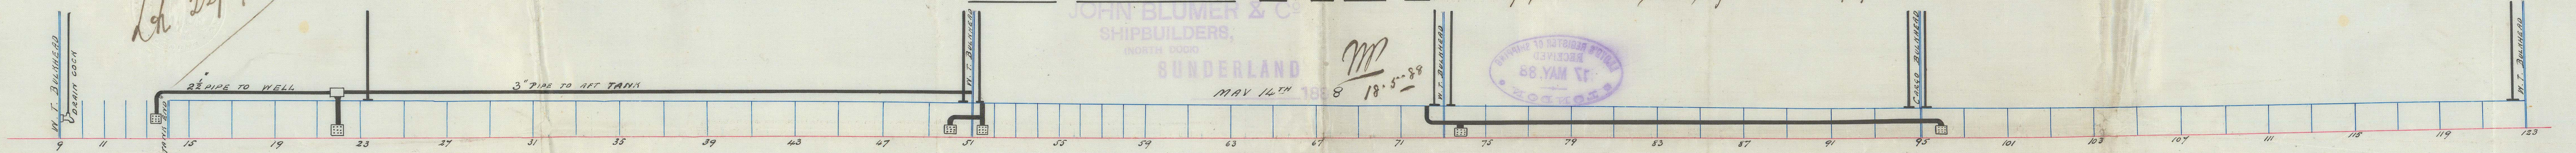

50959-0202



© 2021

Lloyd's Register  
Foundation



SL0959 - 0202

1/2/21 2021

© 2021



Lloyd's Register  
Foundation