

Lloyd's Register of British and Foreign Shipping.

(Report on Vessel No. 14491 Port Sunderland)

lund
No. 894a

SHIP FORGINGS OR CASTINGS.

I have to report that the undermentioned Iron or Steel Forgings or Castings, manufactured by

Messrs R S Bagnall Sons of Wylton
for the Vessel No. 91, being built by Messrs Blunell & Co
of Sunderland have been inspected by me as set forth below, and found
to be, so far as can be seen, sound

The words FORGINGS or CASTINGS, IRON or STEEL, should be struck out as may be required.



Mark on Forgings.

Lloyd's
No. 894a
N.C.

Wm Cameron
Sunderland

	STERN FRAME.	RUDDER FRAME.	STEM.
Material*	<u>Scrap iron</u>	<u>Scrap iron</u>	<u>Scrap iron</u>
How made	<u>Forged</u>	<u>Forged</u>	<u>Forged</u>
Dimensions	<u>8 1/2 x 5'</u>	<u>8 1/2 - 3 1/2</u>	<u>8 1/2 x 2 1/2</u>
Progress on Inspection	<u>Smithed</u>	<u>Forged Smithed</u>	<u>Forged</u>
Dates when Inspected	<u>April 11-14-26/88</u>	<u>July 20-27 Sept 1-3-8/88</u>	<u>May 12/88</u>

SKETCHES OF FRAMES SHEWING POSITION AND DESCRIPTION OF WELDS OF FORGINGS, OR PARTICULARS OF TESTS APPLIED TO CASTINGS.

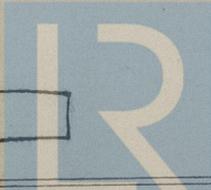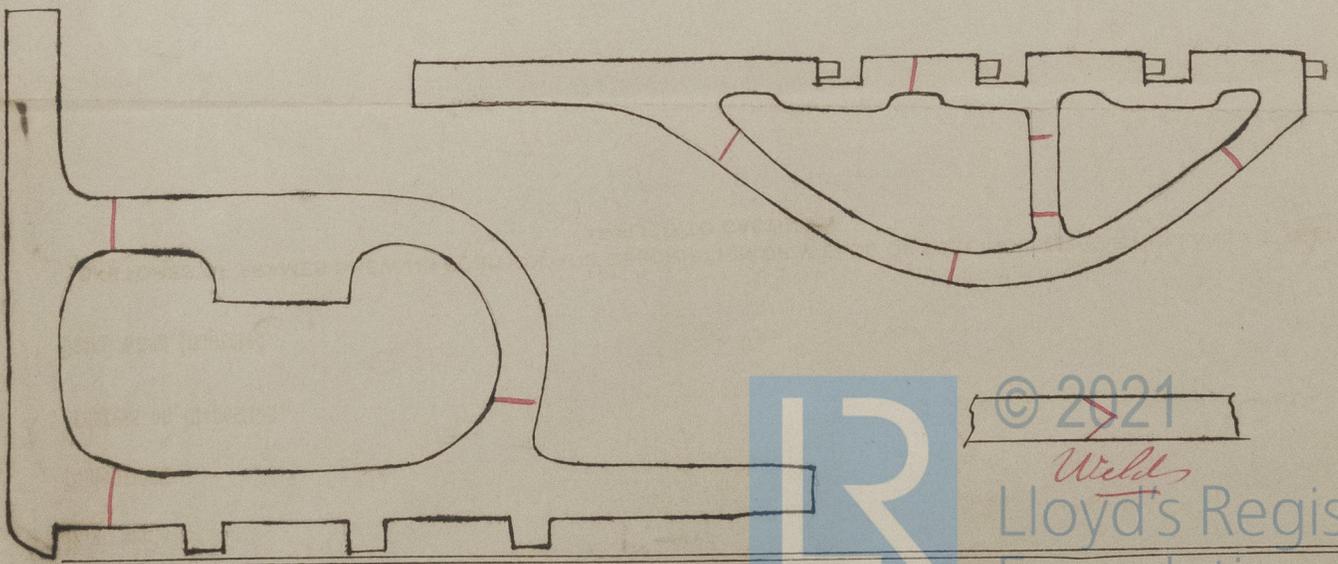

© 2021

Welds

Lloyd's Register
Foundation