


30.8.88
MON 28 JAN 89

Beddington S.S. Rept. 1504

—PROFILE S.S. 19—

Showing arrangement of Hold Beams, Hatches &c.

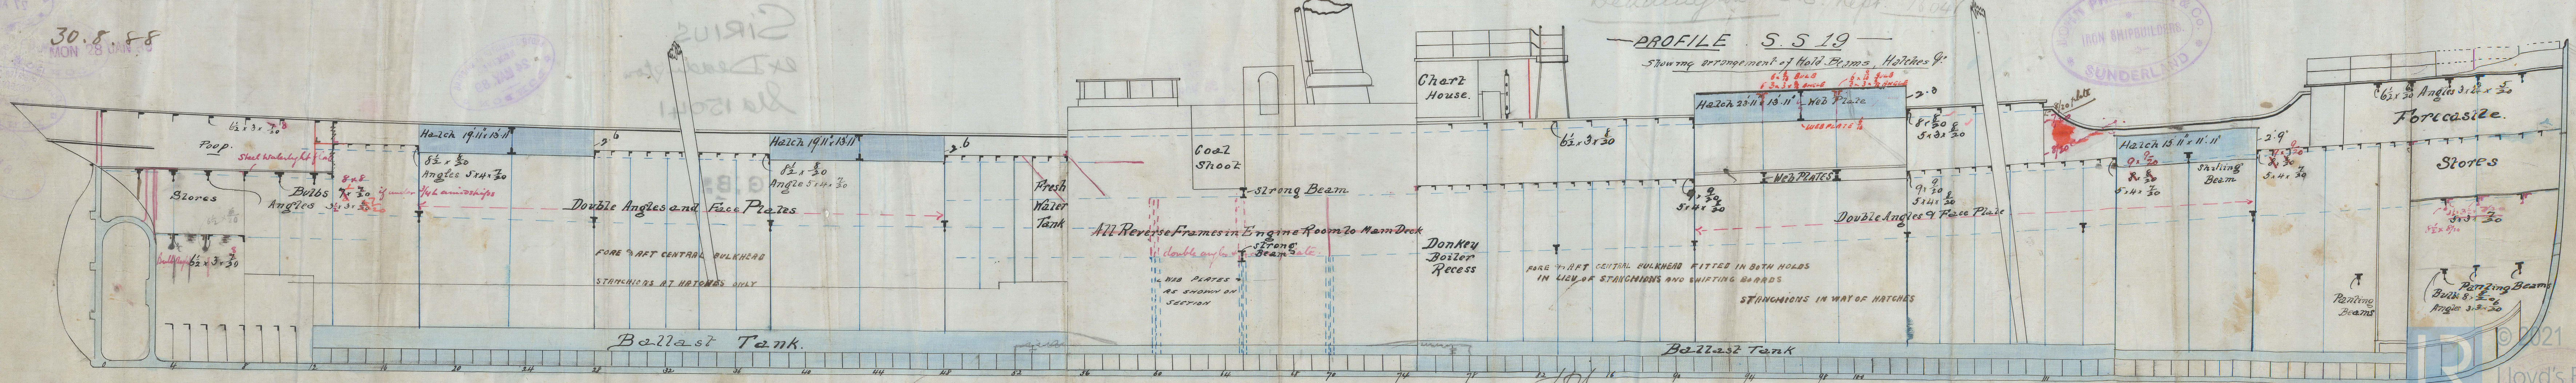

29/8/88

SLD962-0296



SIRIUS
 & Deadweight
 15041

LODD'S REGISTER OF SHIPPING
 RECEIVED
 24 MAR 88
 LONDON

LODD'S REGISTER OF SHIPPING
 RECEIVED
 27 AUG 88
 LONDON

LODD'S REGISTER OF SHIPPING
 RECEIVED
 10 NOV 88
 LONDON

LODD'S REGISTER OF SHIPPING
 RECEIVED
 18 MAR 89
 LONDON



© 2021
 Lloyd's Register
 Foundation

SLD962-0296