

# Lloyd's Register of British and Foreign Shipping.

*Sund*

(Report on Vessel No. \_\_\_\_\_ Port \_\_\_\_\_)

No. 1085A

## SHIP FORGINGS OR CASTINGS.

I have to report that the undermentioned Iron or Steel Forgings or Castings, manufactured by

*Mr Tho Bay*

of *Fallin*

for the Vessel No. *19*, being built by *Aspf / Rustman & Co*

of *Sunduland* have been inspected by me as set forth below, and found to be, so far as can be seen, *sound*

The words FORGINGS or CASTINGS, IRON or STEEL, should be struck out as may be required.

Mark on Forgings.


Lloyd's  
No. 1085A  
*P.B.C.*

*Wm J. Cannon*  
*Sunduland*

*1-14-89*

	STERN FRAME.	RUDDER FRAME.	STEM.
Material* . . . . .	<i>Scrap iron</i>	<i>Scrap iron</i>	<i>Scrap iron</i>
How made . . . . .	<i>Fused</i>	<i>Fused</i>	<i>Fused</i>
Dimensions . . . . .	<i>9' x 5 1/2"</i>	<i>4' - 3 1/2"</i>	<i>9' x 2 1/2"</i>
Progress on Inspection . . . . .	<i>Smithed</i>	<i>Fused Smithed</i>	<i>Fused</i>
Dates when Inspected	<i>Nov 10-15-22-24/88</i>	<i>Jan 5-11-15-18-22-30-31 Feb 6-9-16 March 8-11/89</i>	<i>Nov 22/88</i>

SKETCHES OF FRAMES SHEWING POSITION AND DESCRIPTION OF WELDS OF FORGINGS, OR PARTICULARS OF TESTS APPLIED TO CASTINGS.

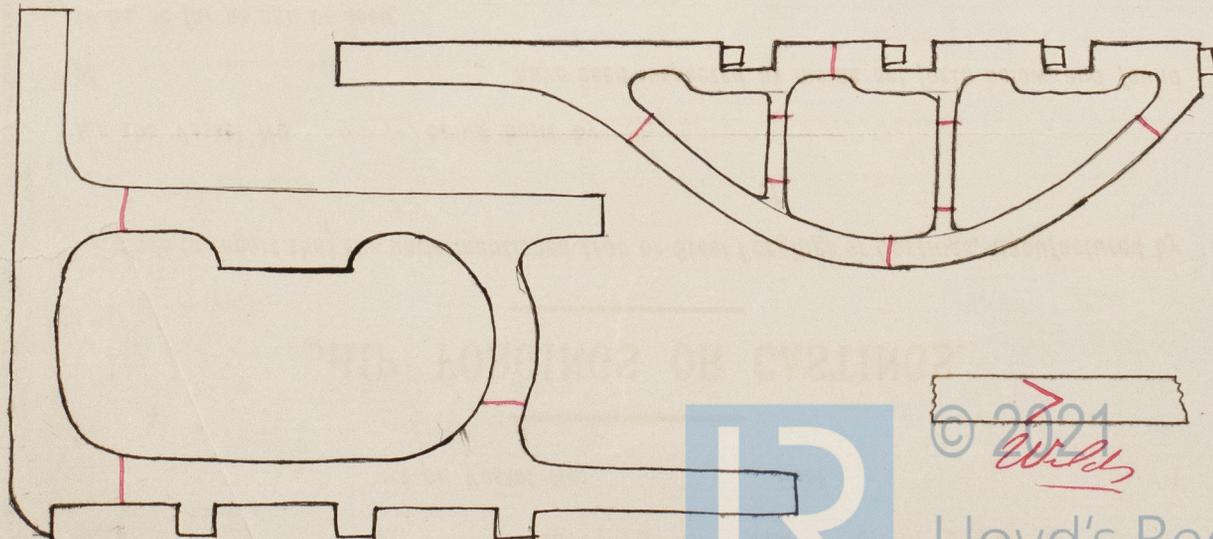

© 2021  
*Welds*

Lloyd's Register  
Foundation

\* If of Iron, state whether scrap or puddled iron.