


SKETCH SHEWING ENGINE & BOILER
OPENINGS ALSO BRIDGE
DECK HATCH.


S.S 19.

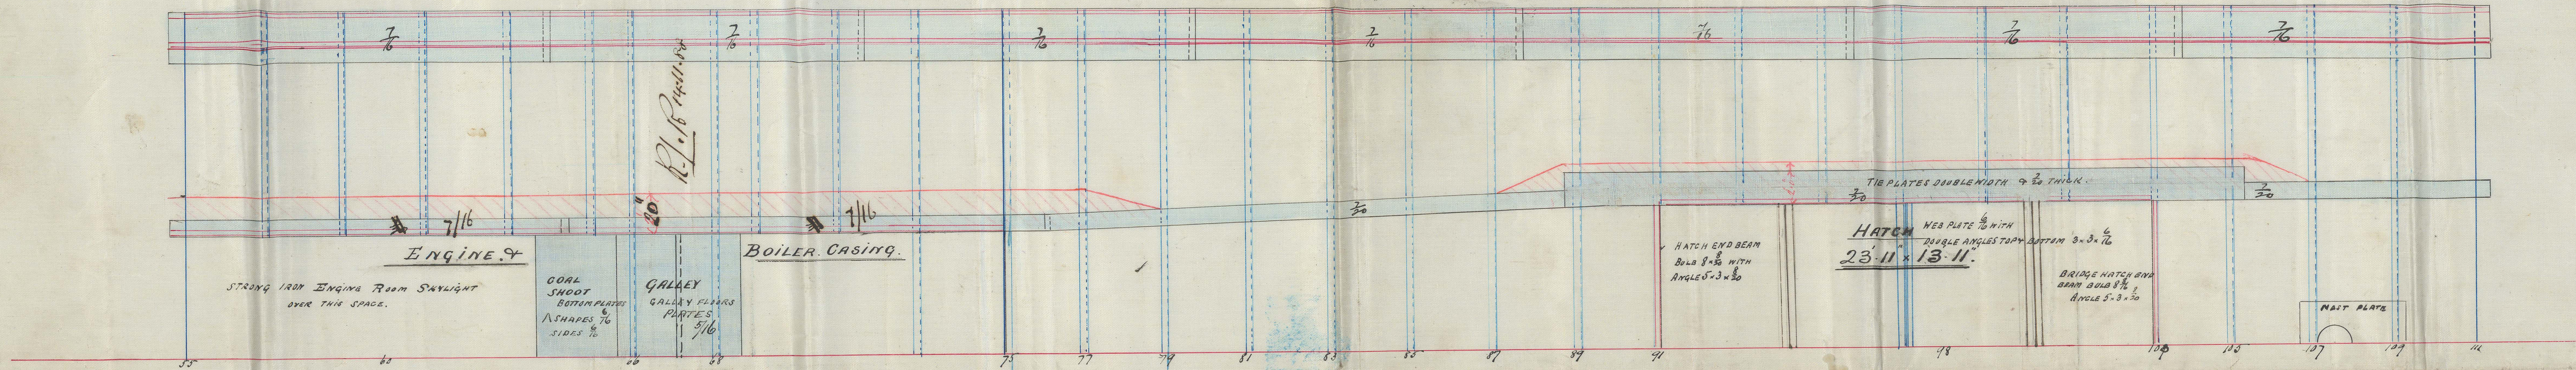

BRIDGE DECK.



MAIN DECK.

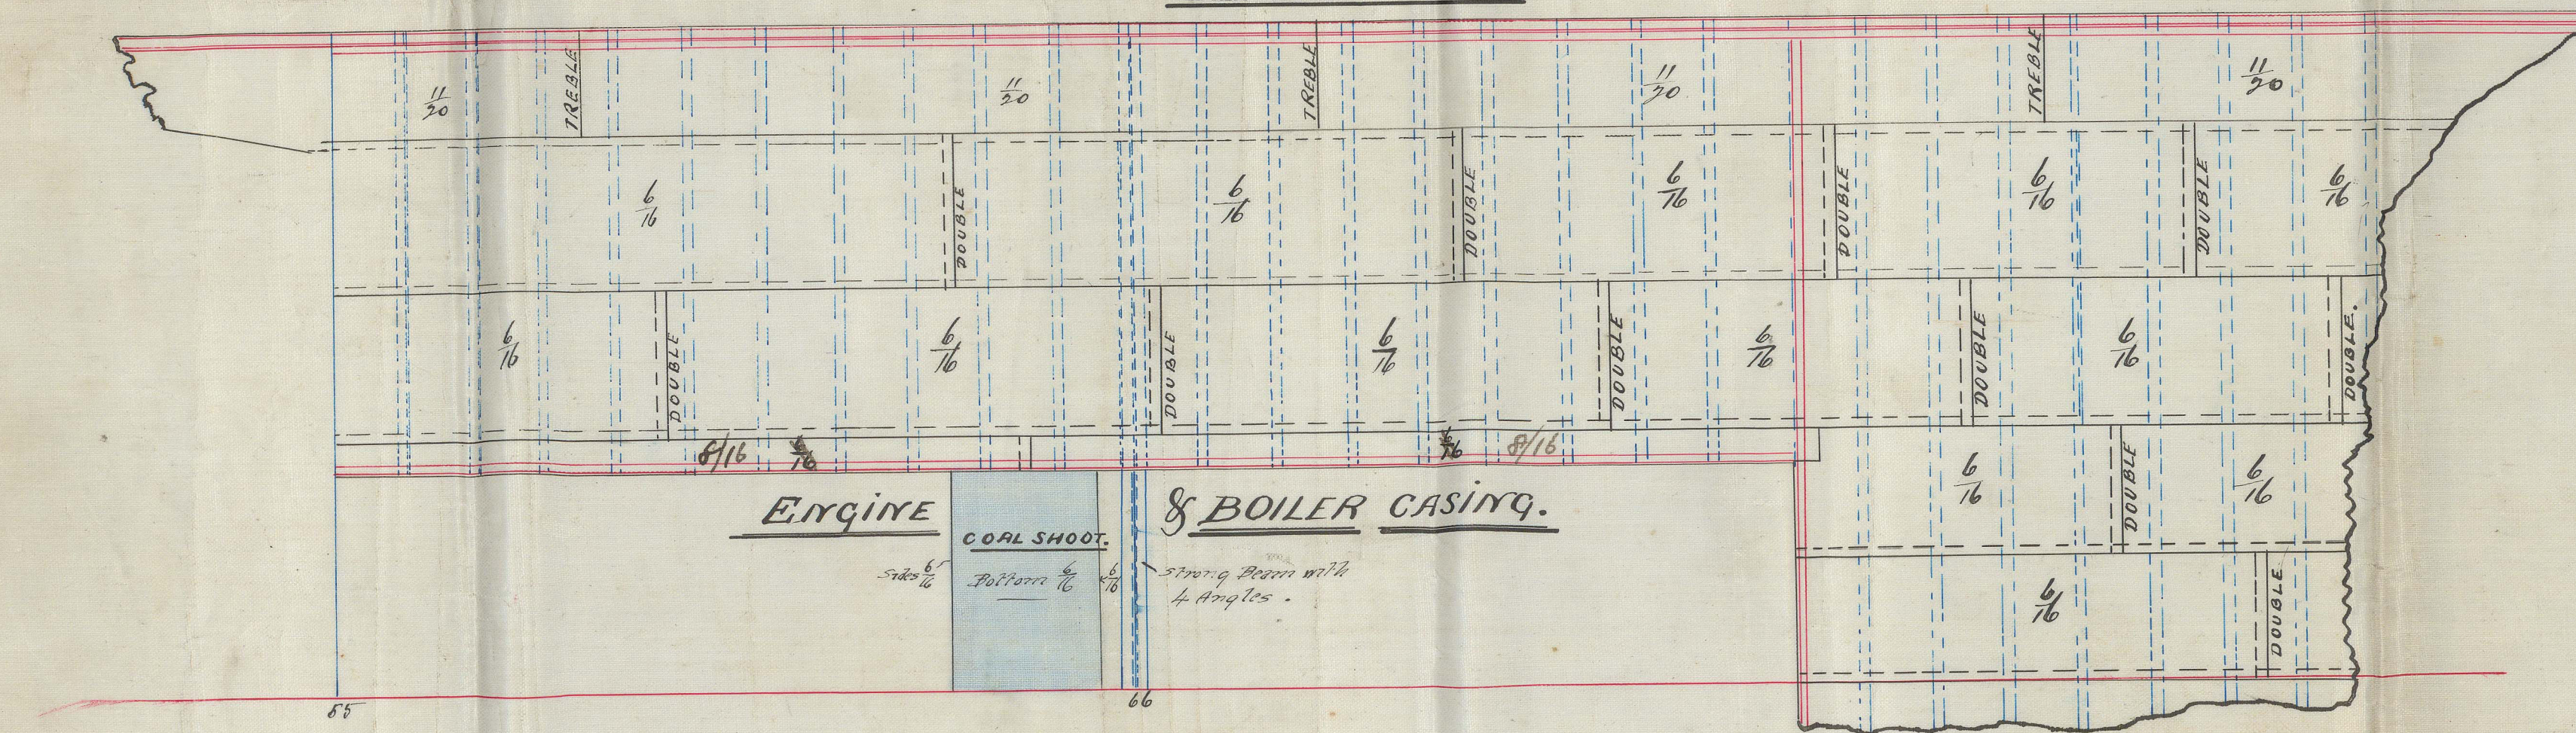


2122



SS 19

ENGINE

BOILER

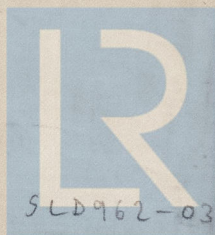

© 2021

Lloyd's Register
Foundation

SLD962-0300