

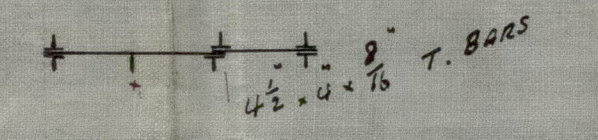


MON 29 JAN 89
FRI 18 FEB 89

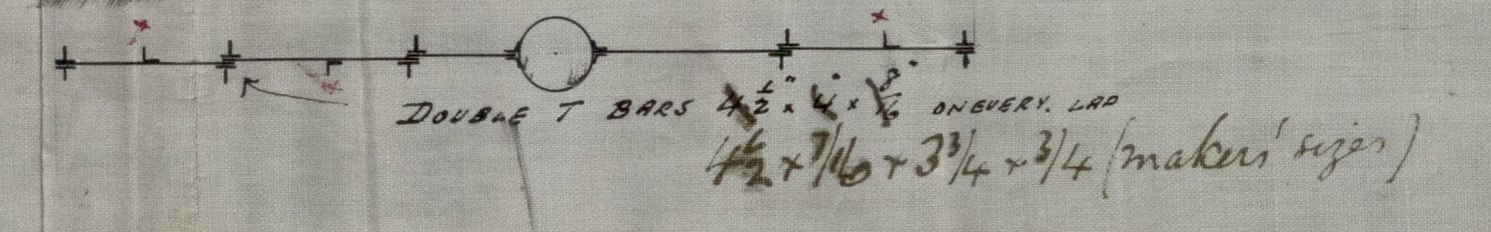

Extra Stiffeners proposed
down centre of each 3 x 3 x 1/16 in
two of 1/16 plates.

SECTION THRO' SHIFTING BOARDS. (LOOKING DOWN)

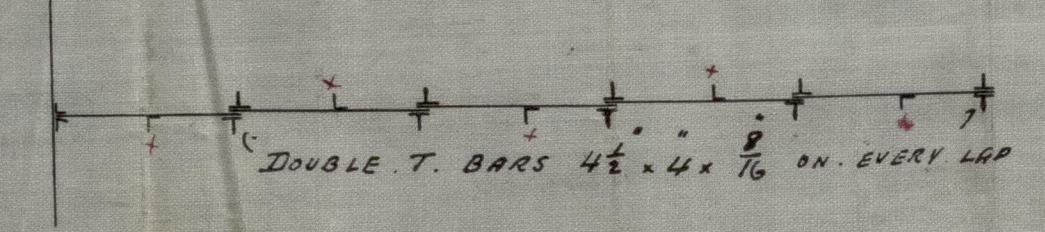


J.P.L.
26/1/89




PROPOSED PLAN of IRON SHIFTING BOARDS No 19
1/4" SCALE

19. S.S. DEDDINGTON

ILER ROOM

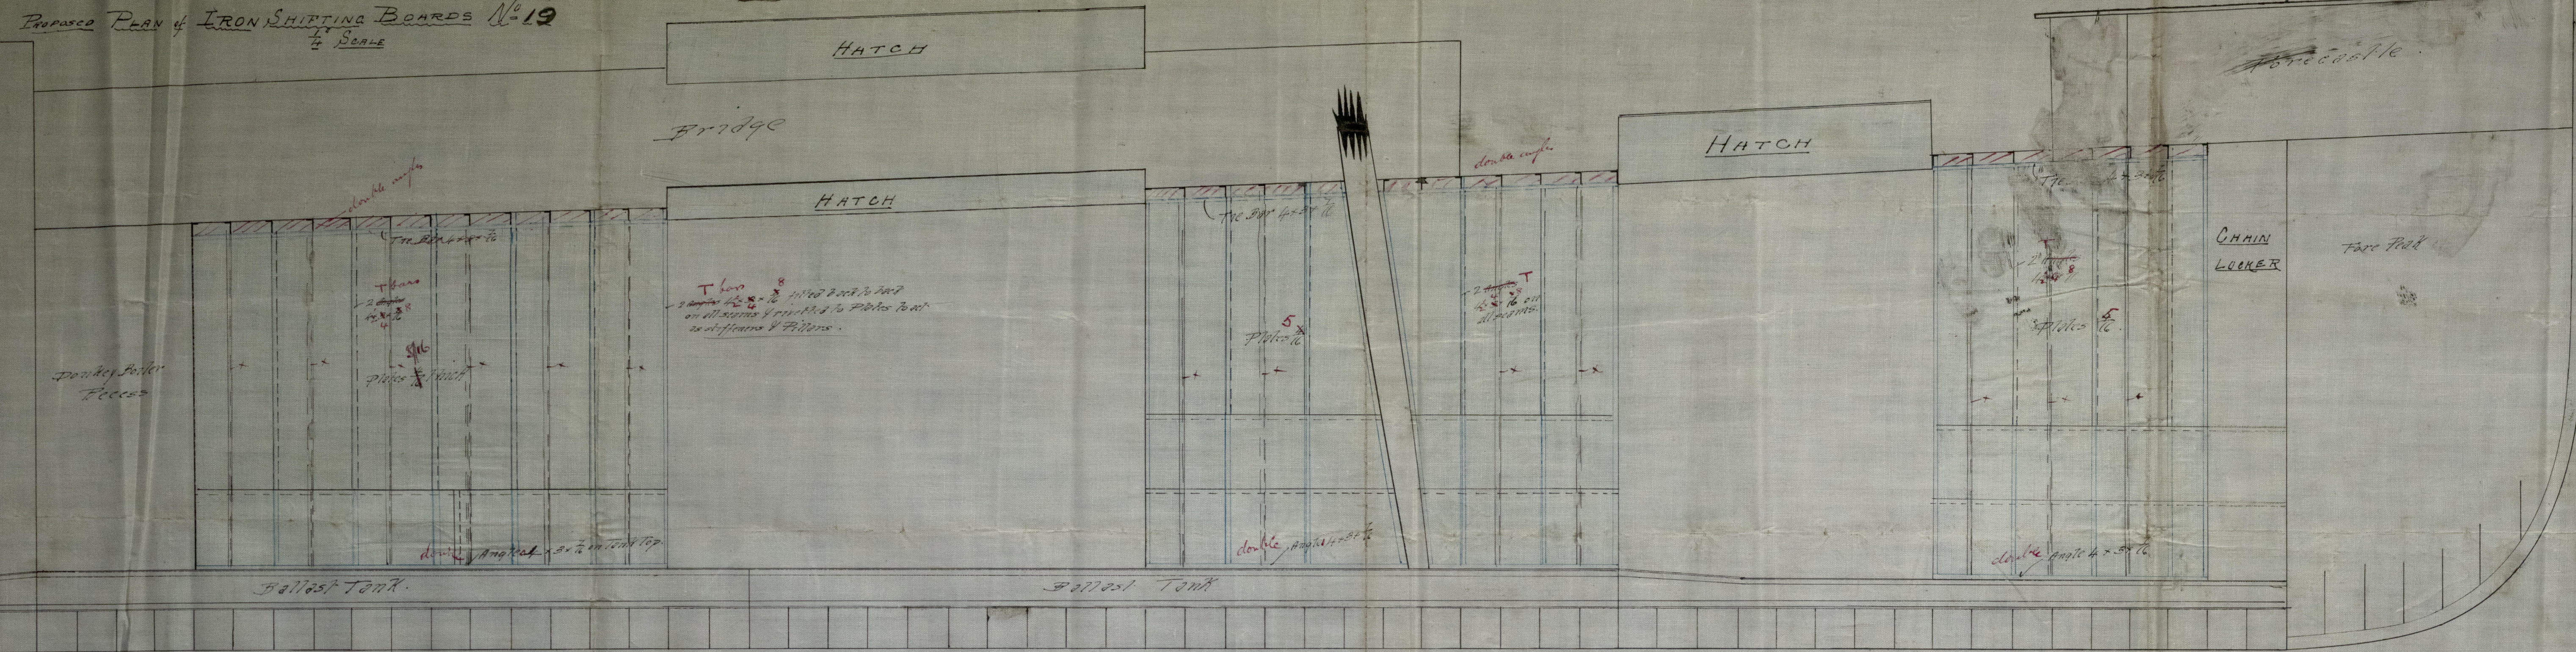

SECTION THRO' SHIFTING BOARDS. LOOKING DOWN

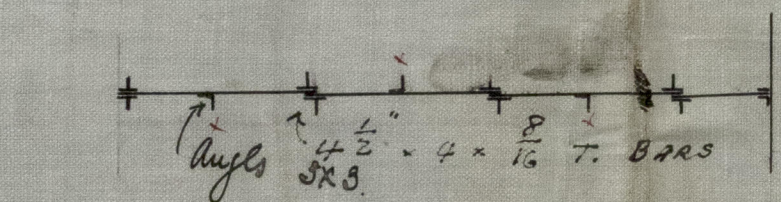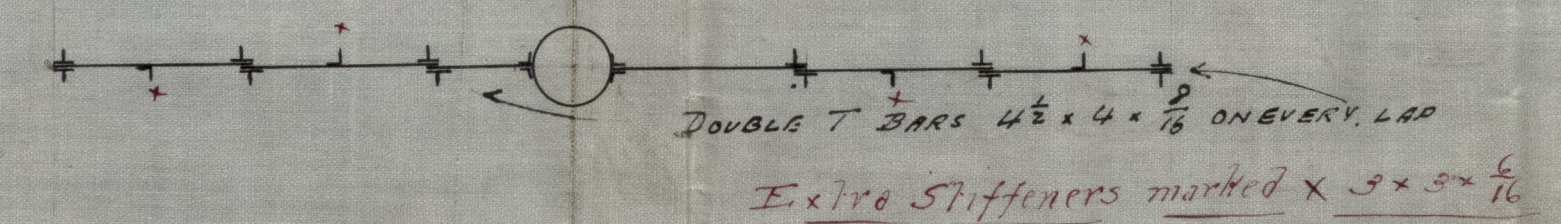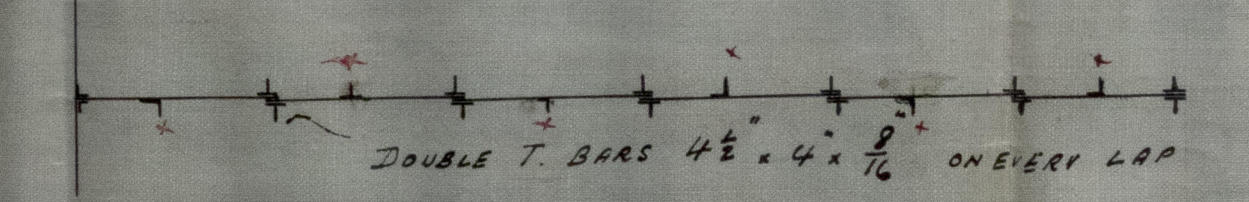









 

© 2021

Lloyd's Register Foundation

SLD962-0302