


Beddington. Rep. No. 15041

SCALE $\frac{1}{2}'' = 1 \text{ FOOT}$

MON 28 JAN 89
FRI 18 FEB 89

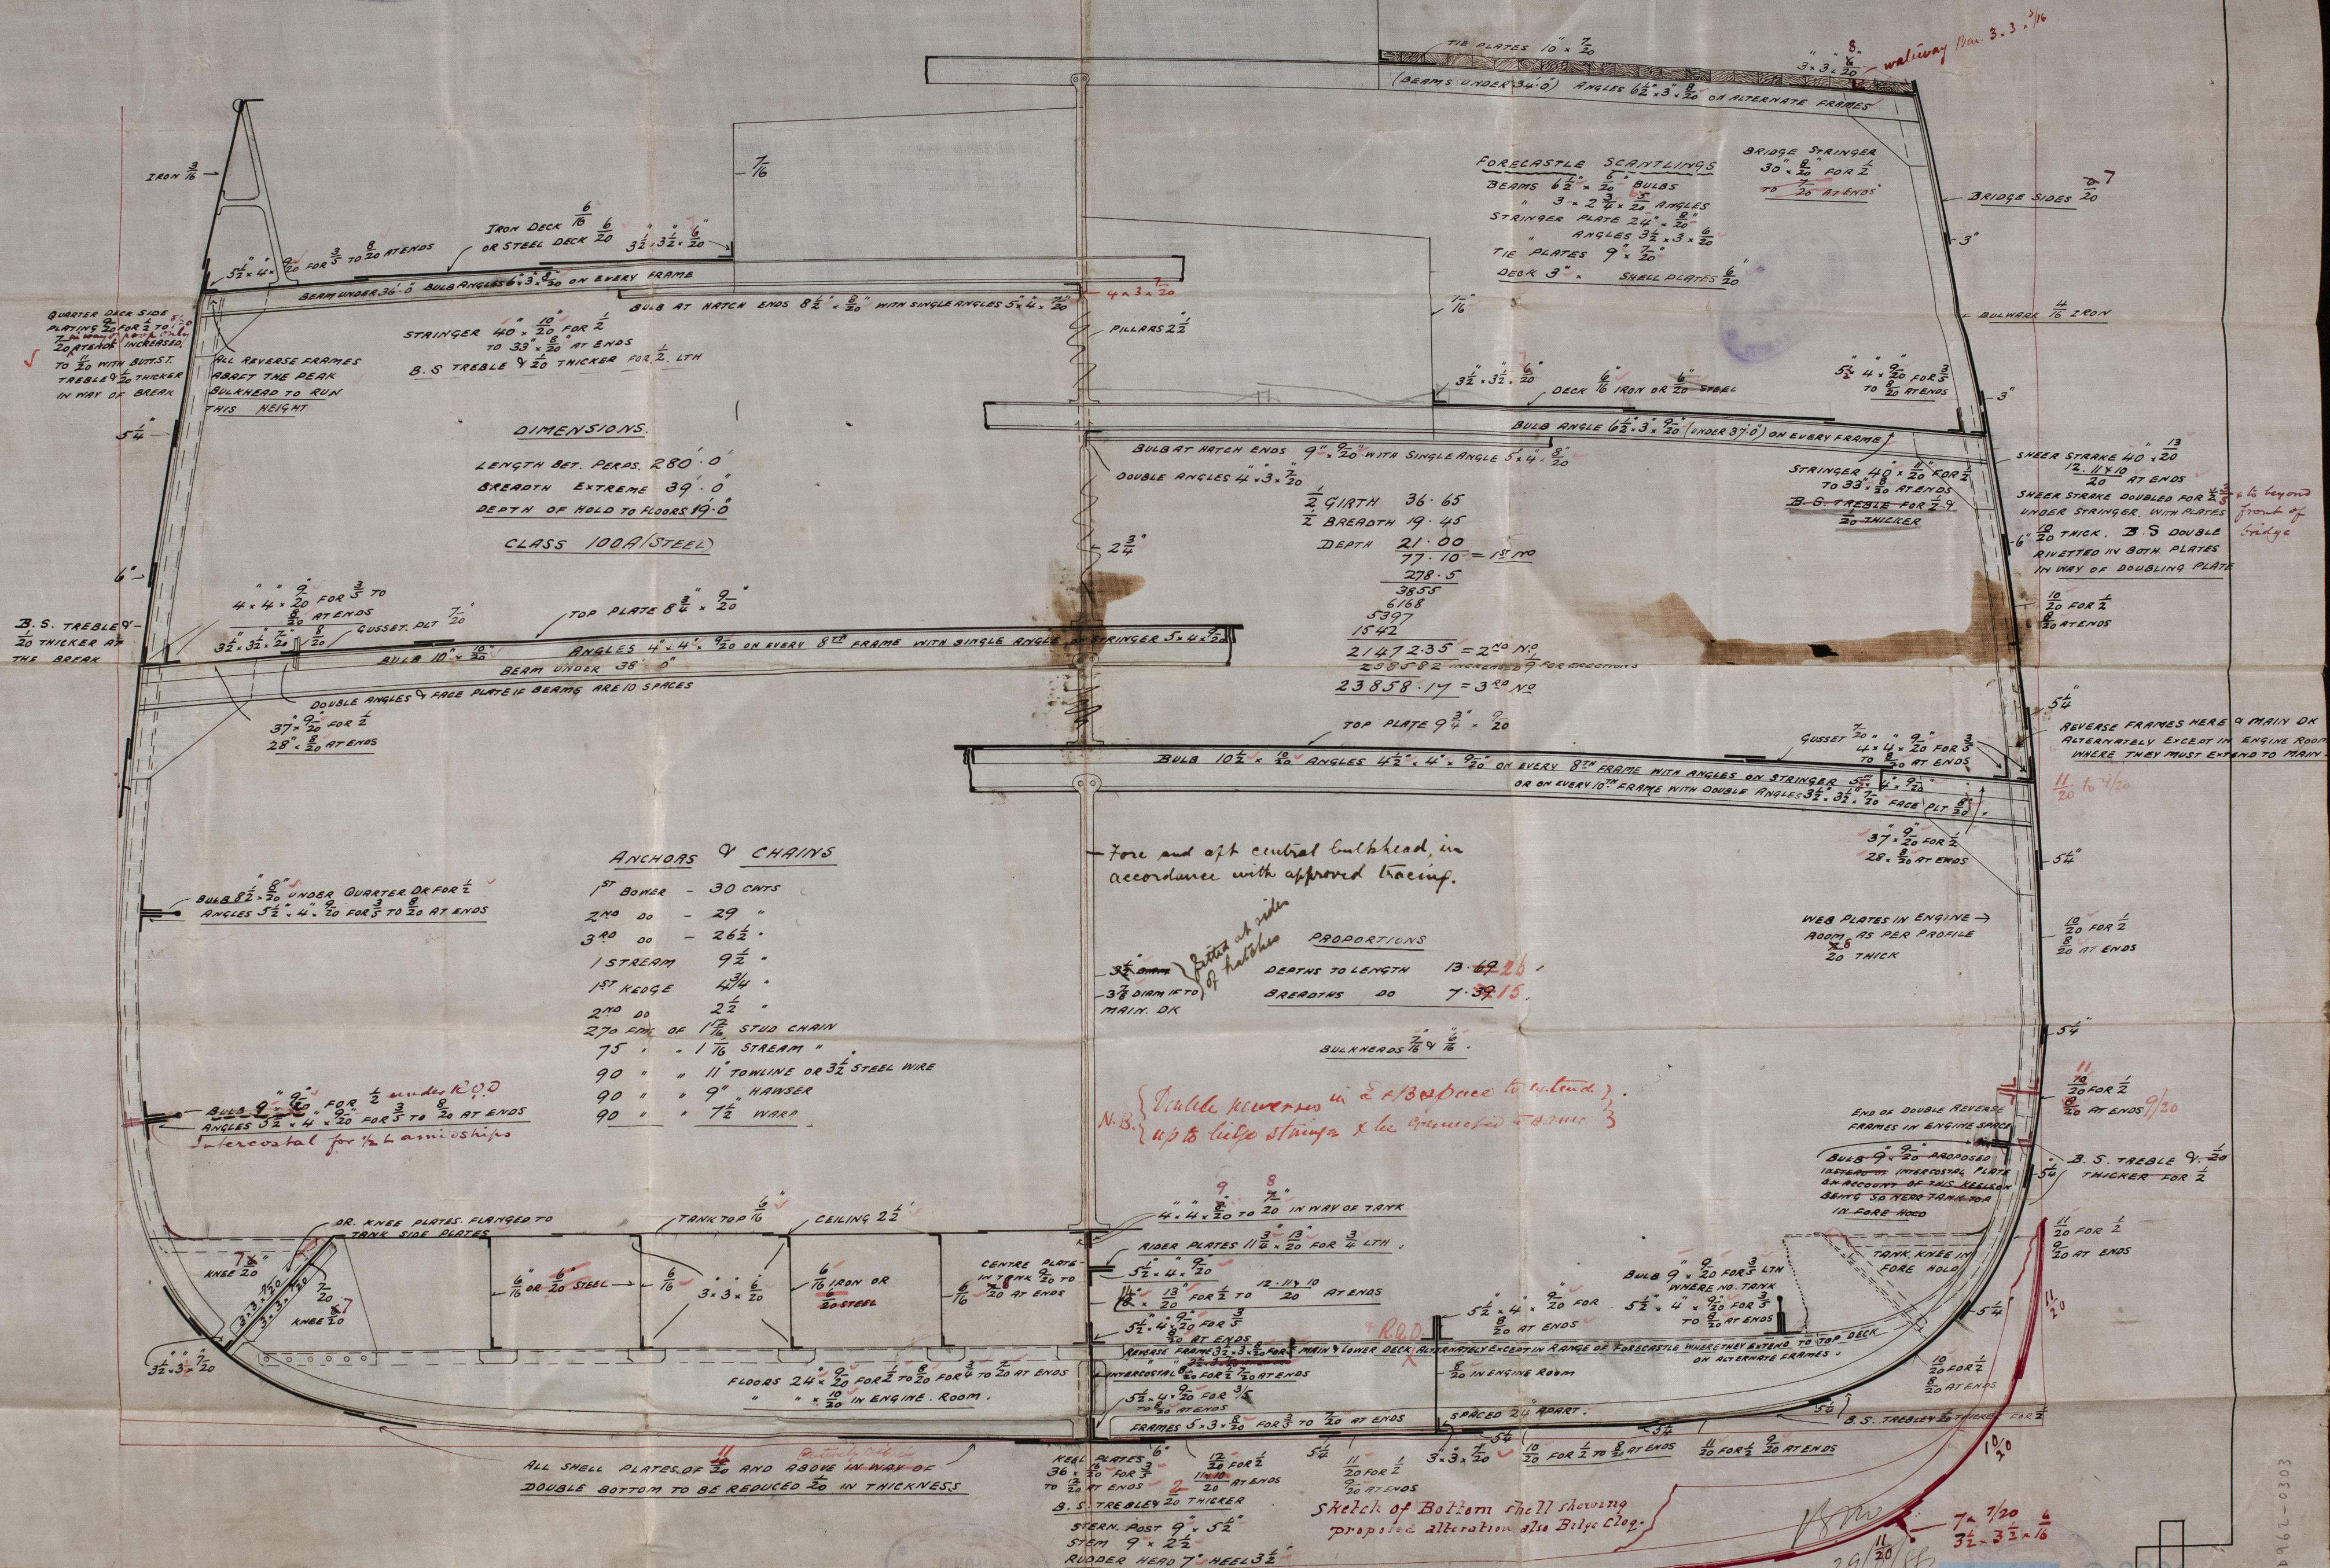

LLOYD'S REGISTER OF SHIPPING
RECEIVED
27 AUG. 88
LONDON

LLOYD'S REGISTER OF SHIPPING
RECEIVED
10 NOV. 83
LONDON

25 JAN

LLOYD'S REGISTER OF SHIPPING
RECEIVED
2 MAY 88
LONDON

LLOYD'S REGISTER OF SHIPPING
RECEIVED
8 FEB 89
LONDON

LLOYD'S REGISTER OF SHIPPING
RECEIVED
24 MAY 89
LONDON

LLOYD'S REGISTER OF SHIPPING
RECEIVED
1 MAY 88
LONDON

1 MAY 88
MON 28 MAY 88
10 5 2 00

