
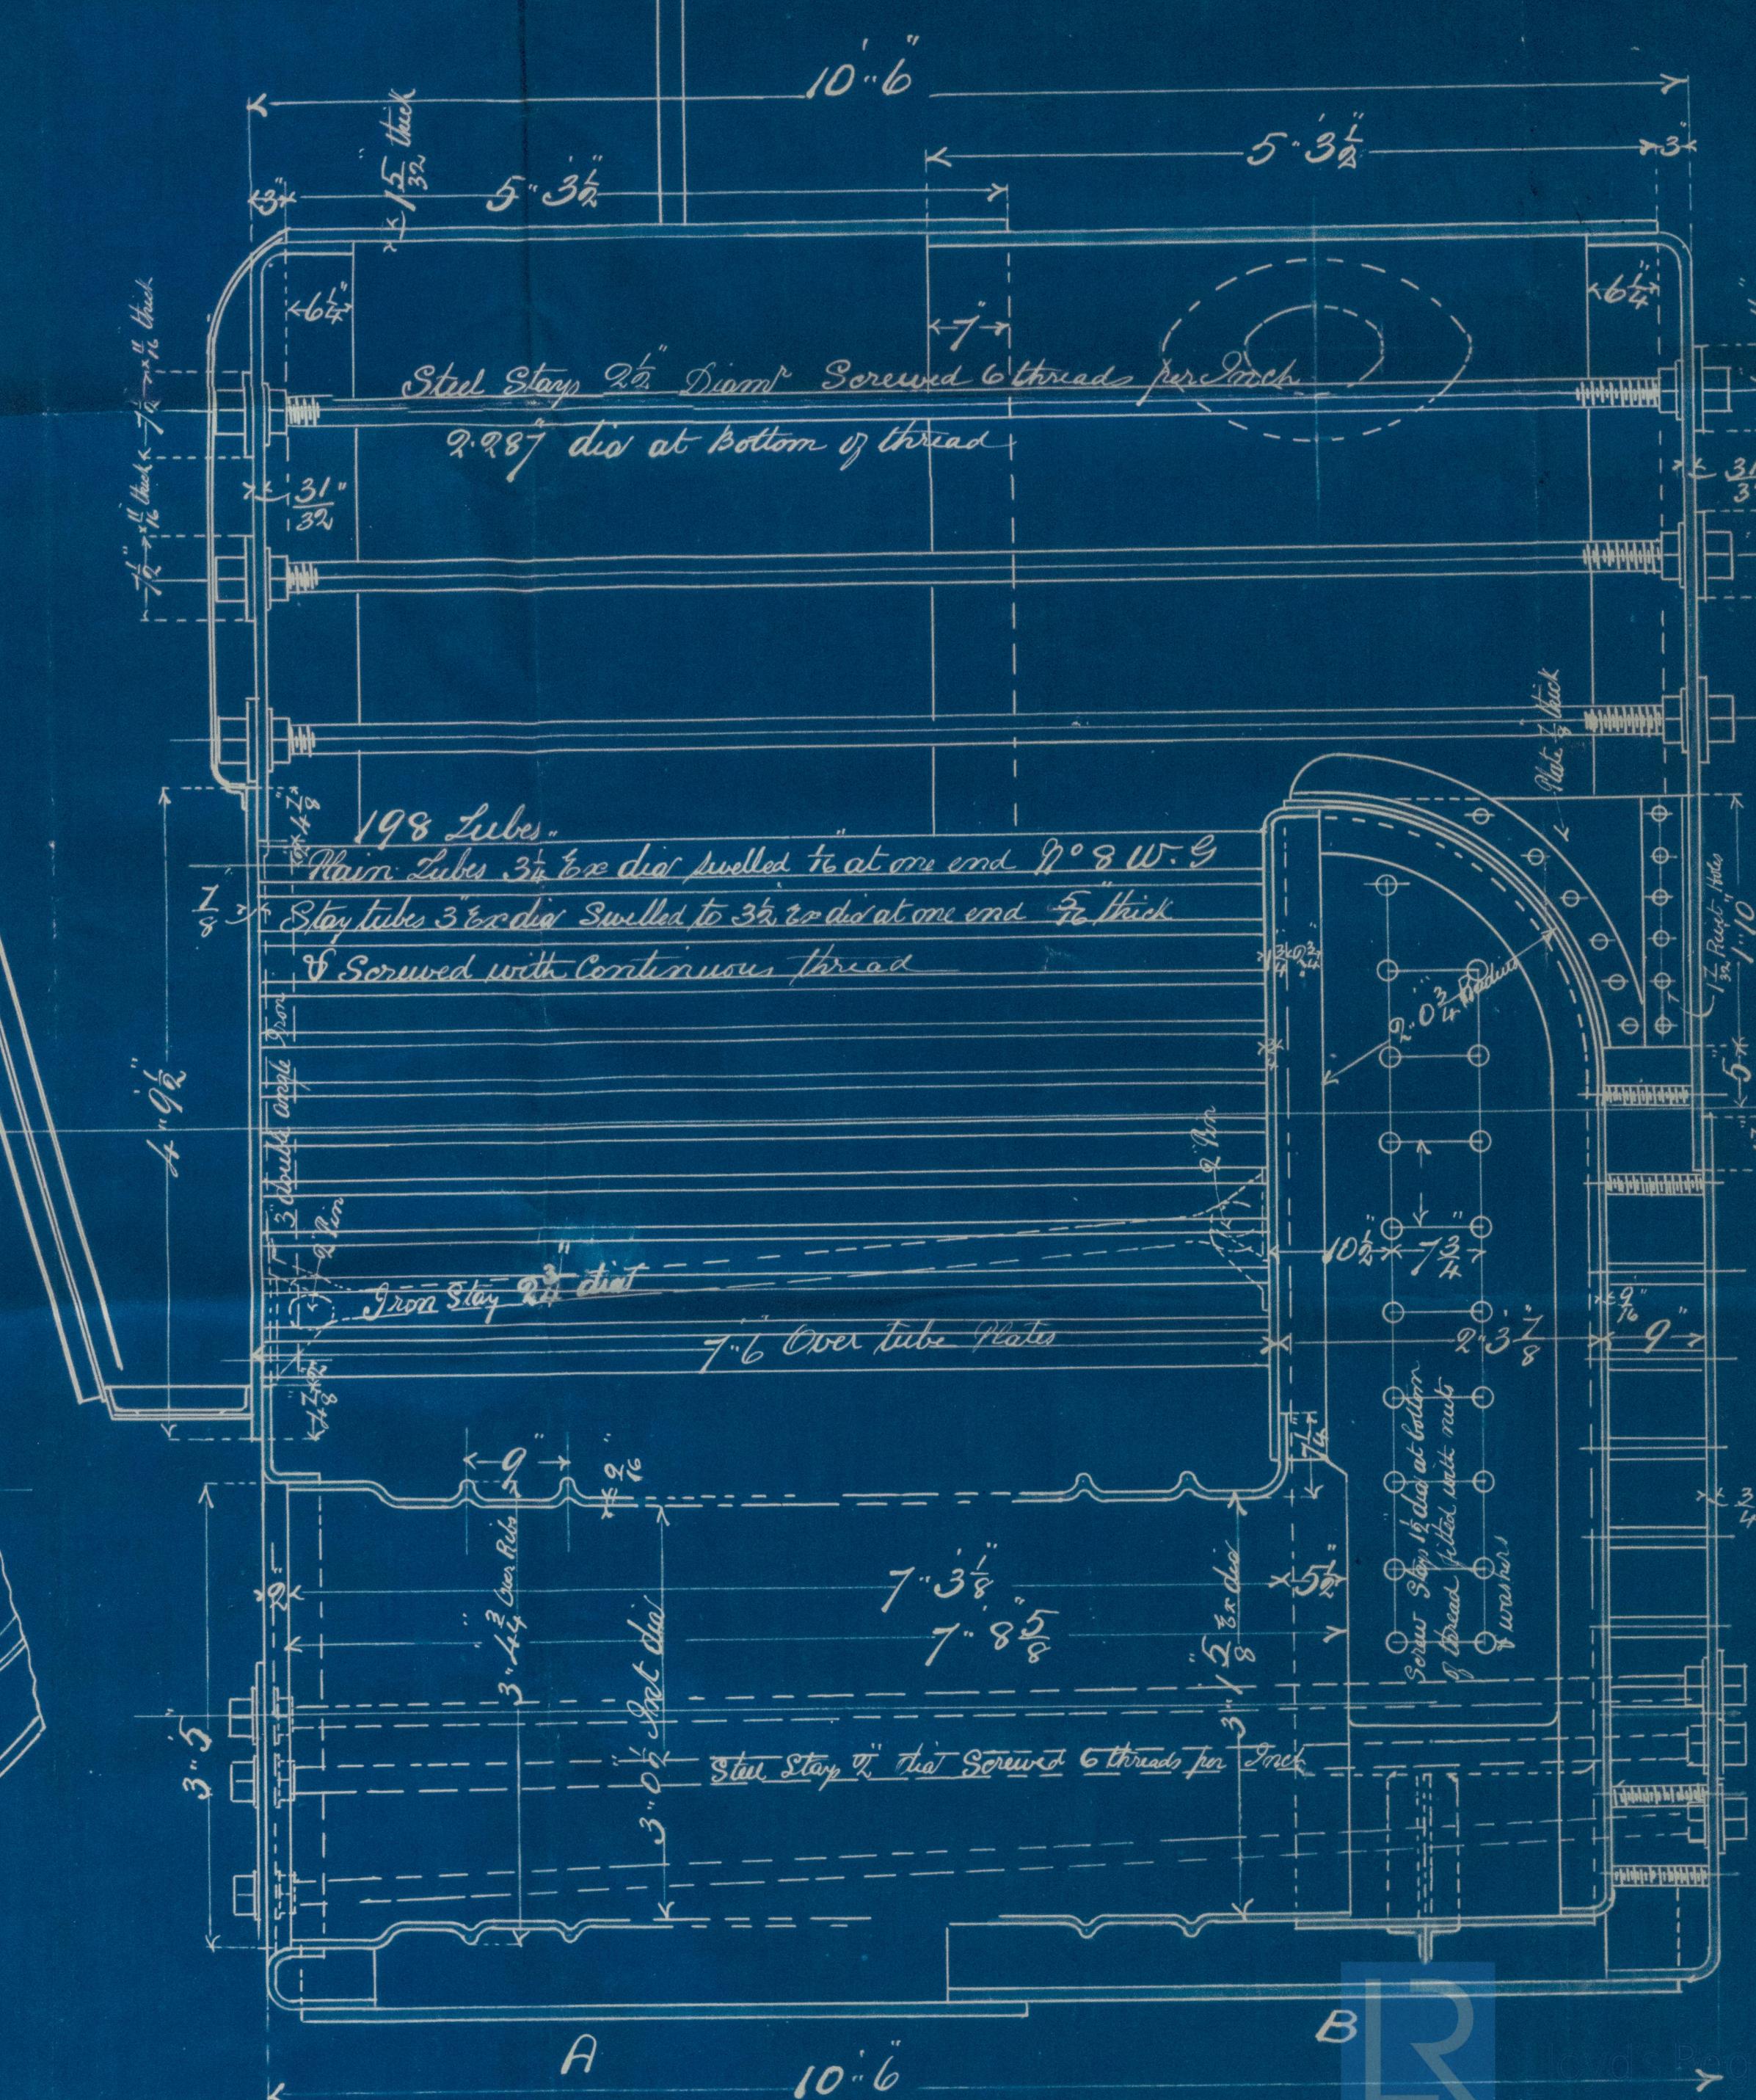


BOILERS. N° 2

PRESSURE 160 LBS PER SQUARE INCH

CALE - / INCH TO A FOOT }

All Plates Bends & Main Stays of Steel
Factor of Safety $5+5 = 5.1$

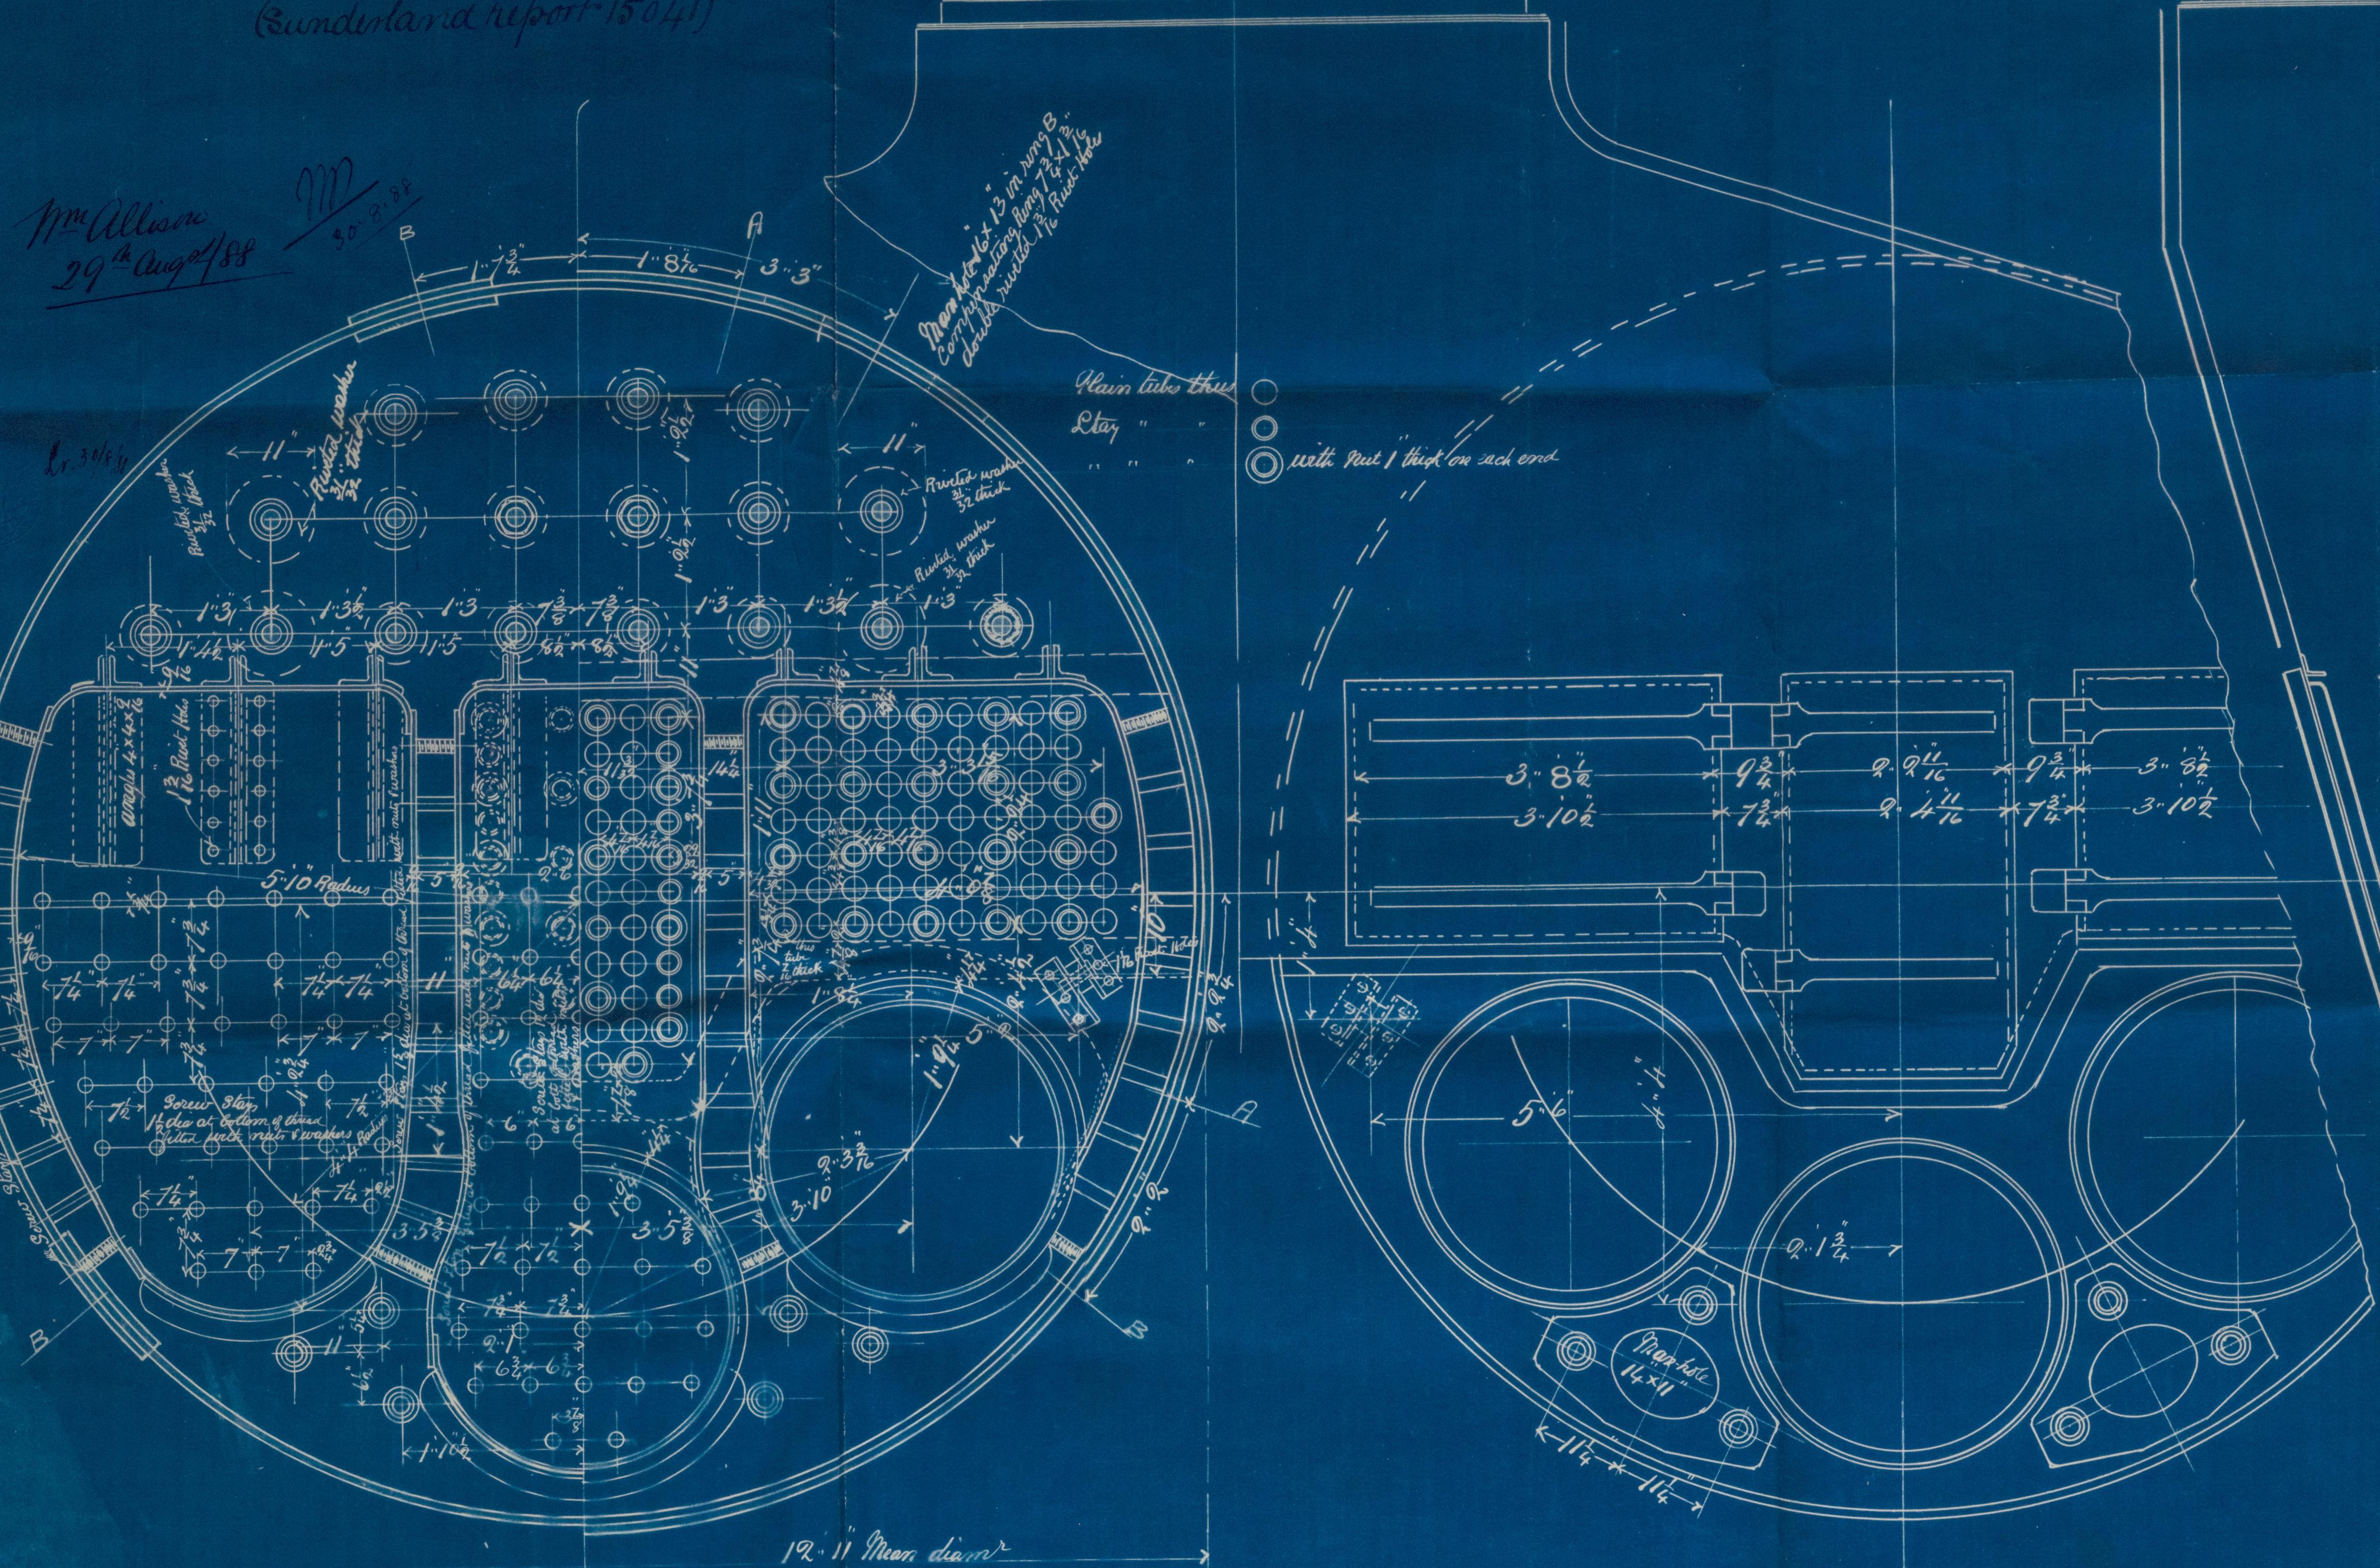

Clarks 494

SLD962-0314



© 2021
Lloyd's Register
Foundation