


26/9/89

1/3 County Down Hd. report No. 15245.

TANK SUCTIONS 166.
SCALE 1/8" = ONE FOOT

P. P. AUSTIN & SON
IRON & STEEL SHIPBUILDERS
AND
REPAIRERS
18/9/89
SUNDERLAND

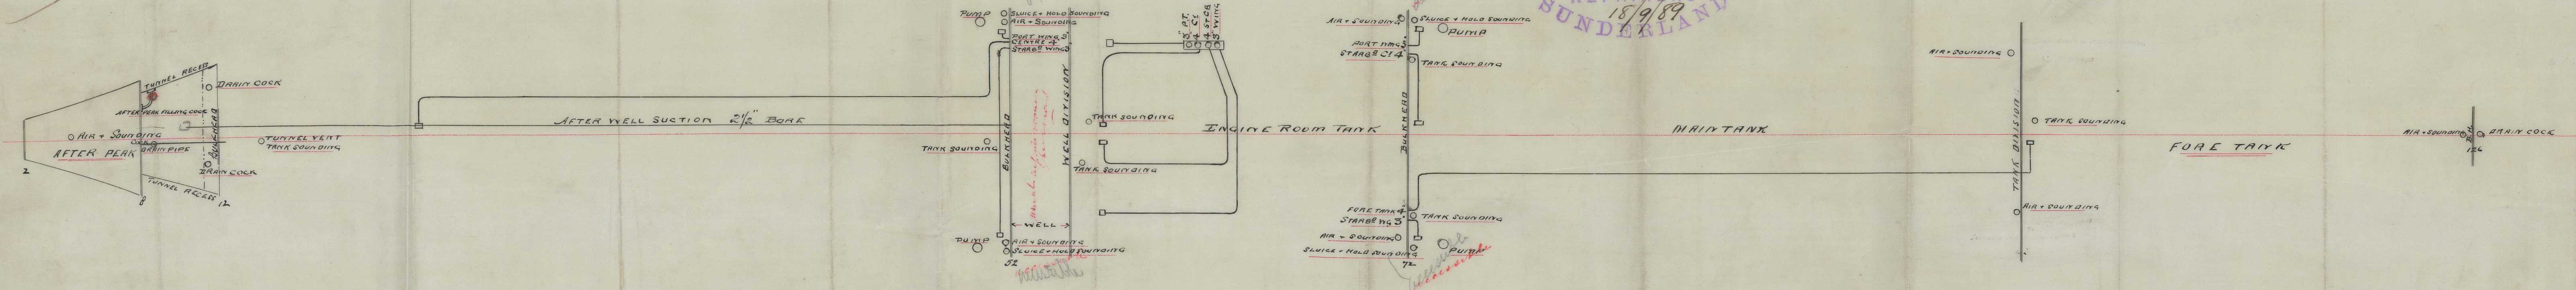

N.A.
25.9.89

25.9.89