

Lloyd's Register of British and Foreign Shipping.

Sund

(Report on Vessel No. 15245 Port SUNDERLAND.)

No. 1238a

SHIP FORGINGS OR CASTINGS.

The words FORGINGS or CASTINGS, IRON or STEEL, should be struck out as may be required.

I have to report that the undermentioned Iron ~~or Steel~~ Forgings ~~or Castings~~, manufactured by

The Wear Forge Co of *Falton*

for the Vessel No. 166, being built by *Messrs J.P. Austin & Son*

of *Sunderland* have been inspected by me as set forth below, and found to be, so far as can be seen, sound.



Mark on Forgings.

Lloyd's
No. 1238a
86-C

Walter Cameron
Sunderland

	STERN FRAME.	RUDDER FRAME.	STEM.
Material* - - - -	<i>Scrap iron</i>	<i>Scrap iron</i>	<i>Scrap iron</i>
How made - - - -	<i>Forged</i>	<i>Forged</i>	<i>Forged</i>
Dimensions - - - -	<i>9' 5 1/2"</i>	<i>7' 3 1/2"</i>	<i>9' 2 1/2"</i>
Progress on Inspection -	<i>Forged Smoothed</i>	<i>Forged Smoothed</i>	<i>Forged</i>
Dates when Inspected	<i>March 14 21-23 April 8 17 25</i> <i>30 May 6-10 21-23/89</i>	<i>July 20 Aug 17-22</i> <i>Sept 20/89</i>	<i>March 21/89</i>

SKETCHES OF FRAMES SHEWING POSITION AND DESCRIPTION OF WELDS OF FORGINGS, OR PARTICULARS OF TESTS APPLIED TO CASTINGS.

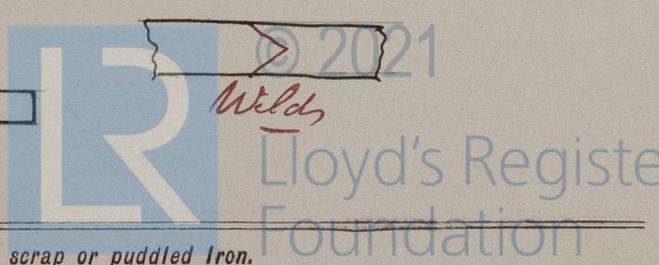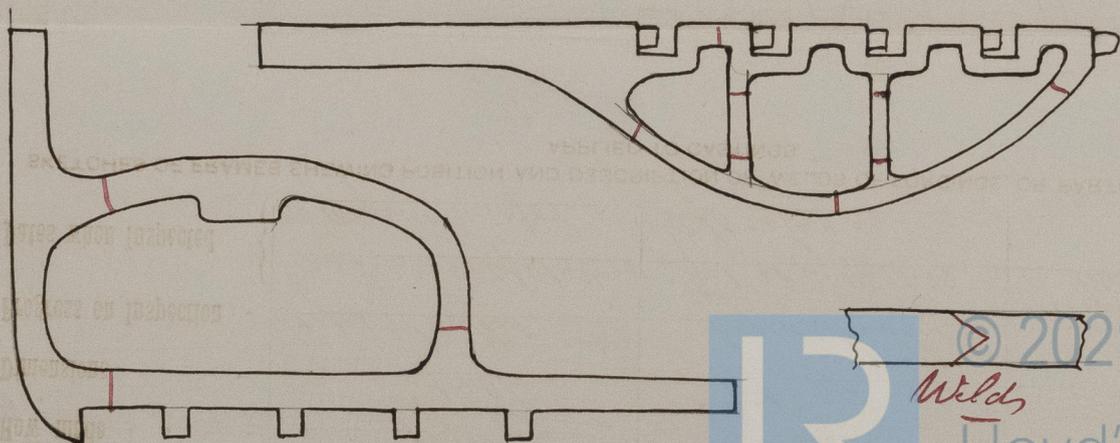

1238