
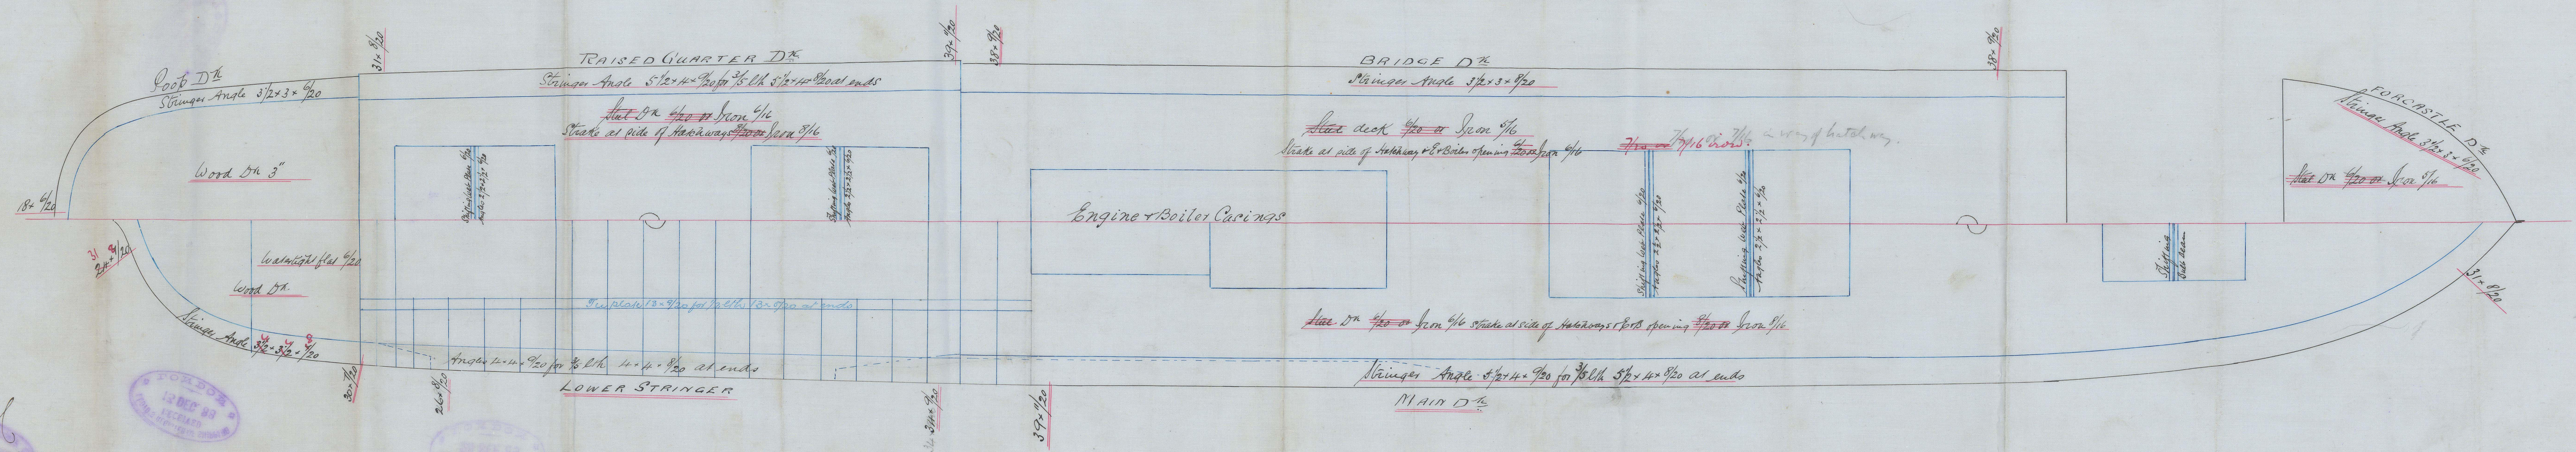


FRI 14 DEC 83

SCALE 1/8" = ONE FOOT

*from
note
note*

S. P. AUSTIN & SON
8.12-88
IRON & STEEL SHIPBUILDERS
AND
REPAIRERS
of *Marconi*
SUNDERLAND

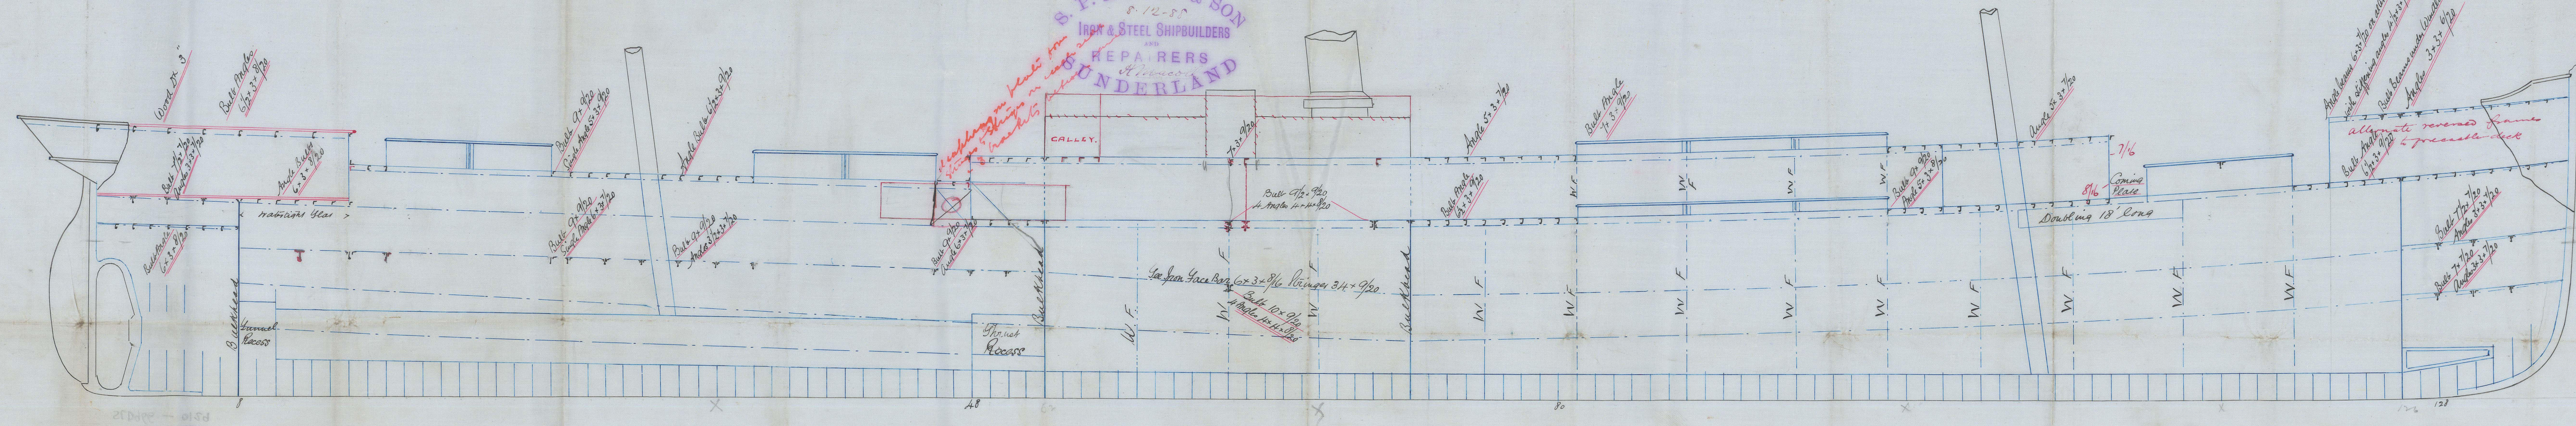


L.H.L.
14/12/88

1876
 1st/12/88
 74.5

LOYD'S REGISTER OF SHIPPING
 RECEIVED
 13 DEC 88
 LONDON

LOYD'S REGISTER OF SHIPPING
 28 SEP 89
 LONDON

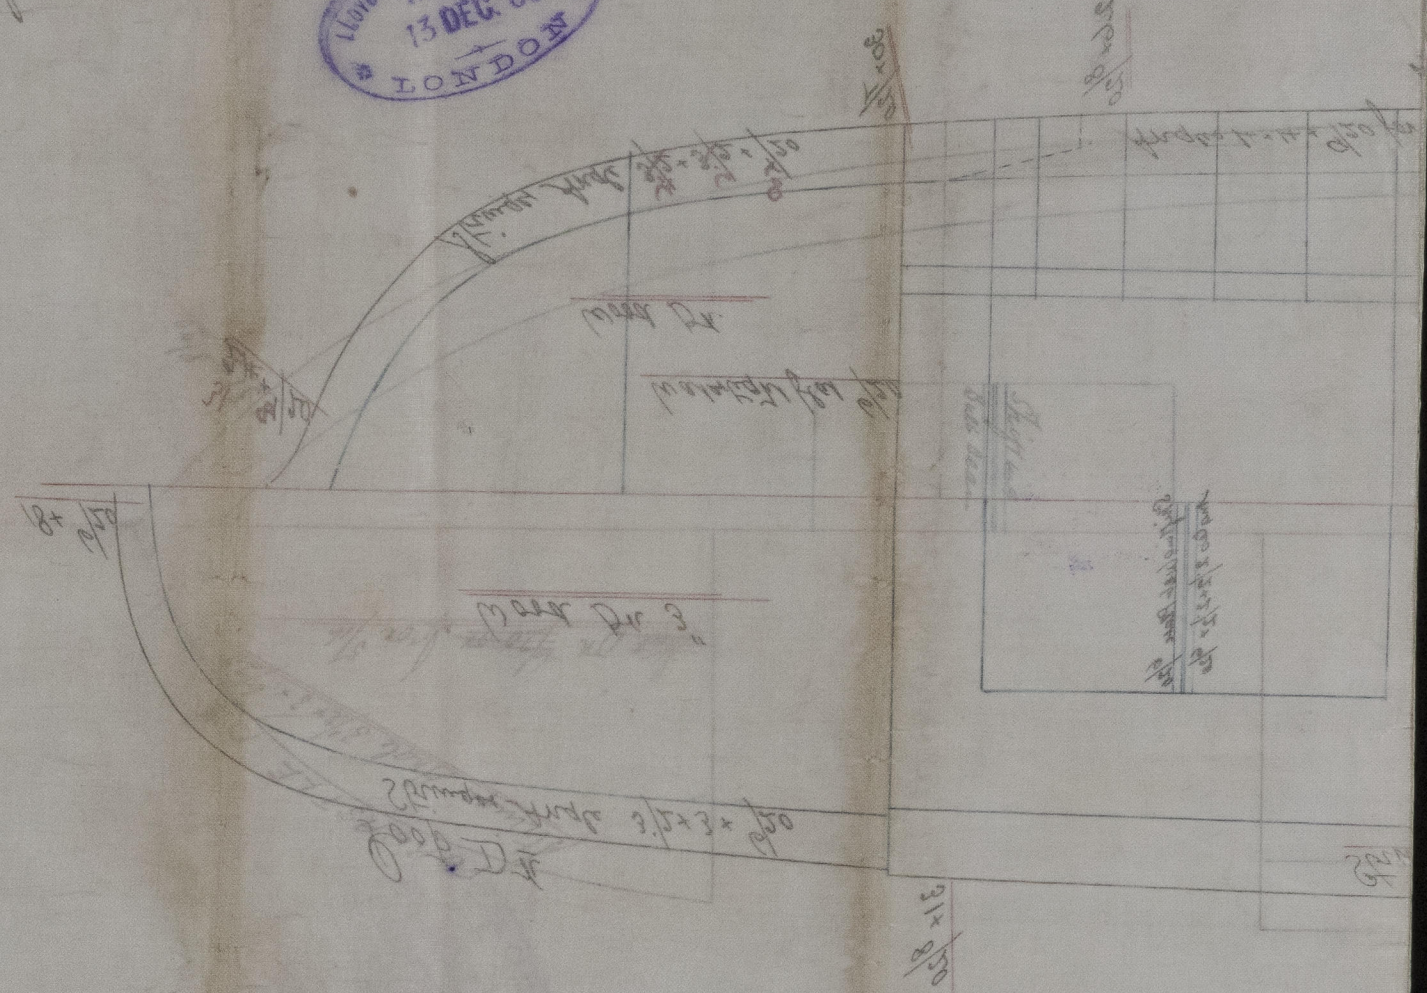

SLD966 - 0129



© 2021

Lloyd's Register
 Foundation