
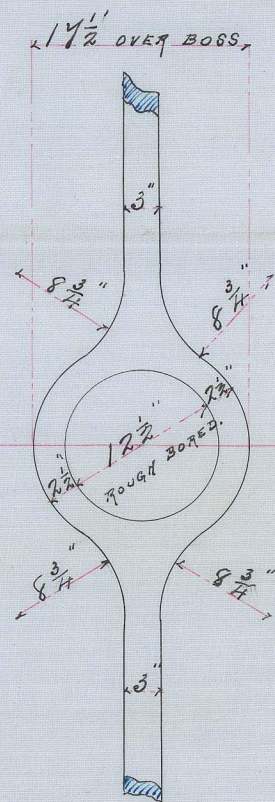
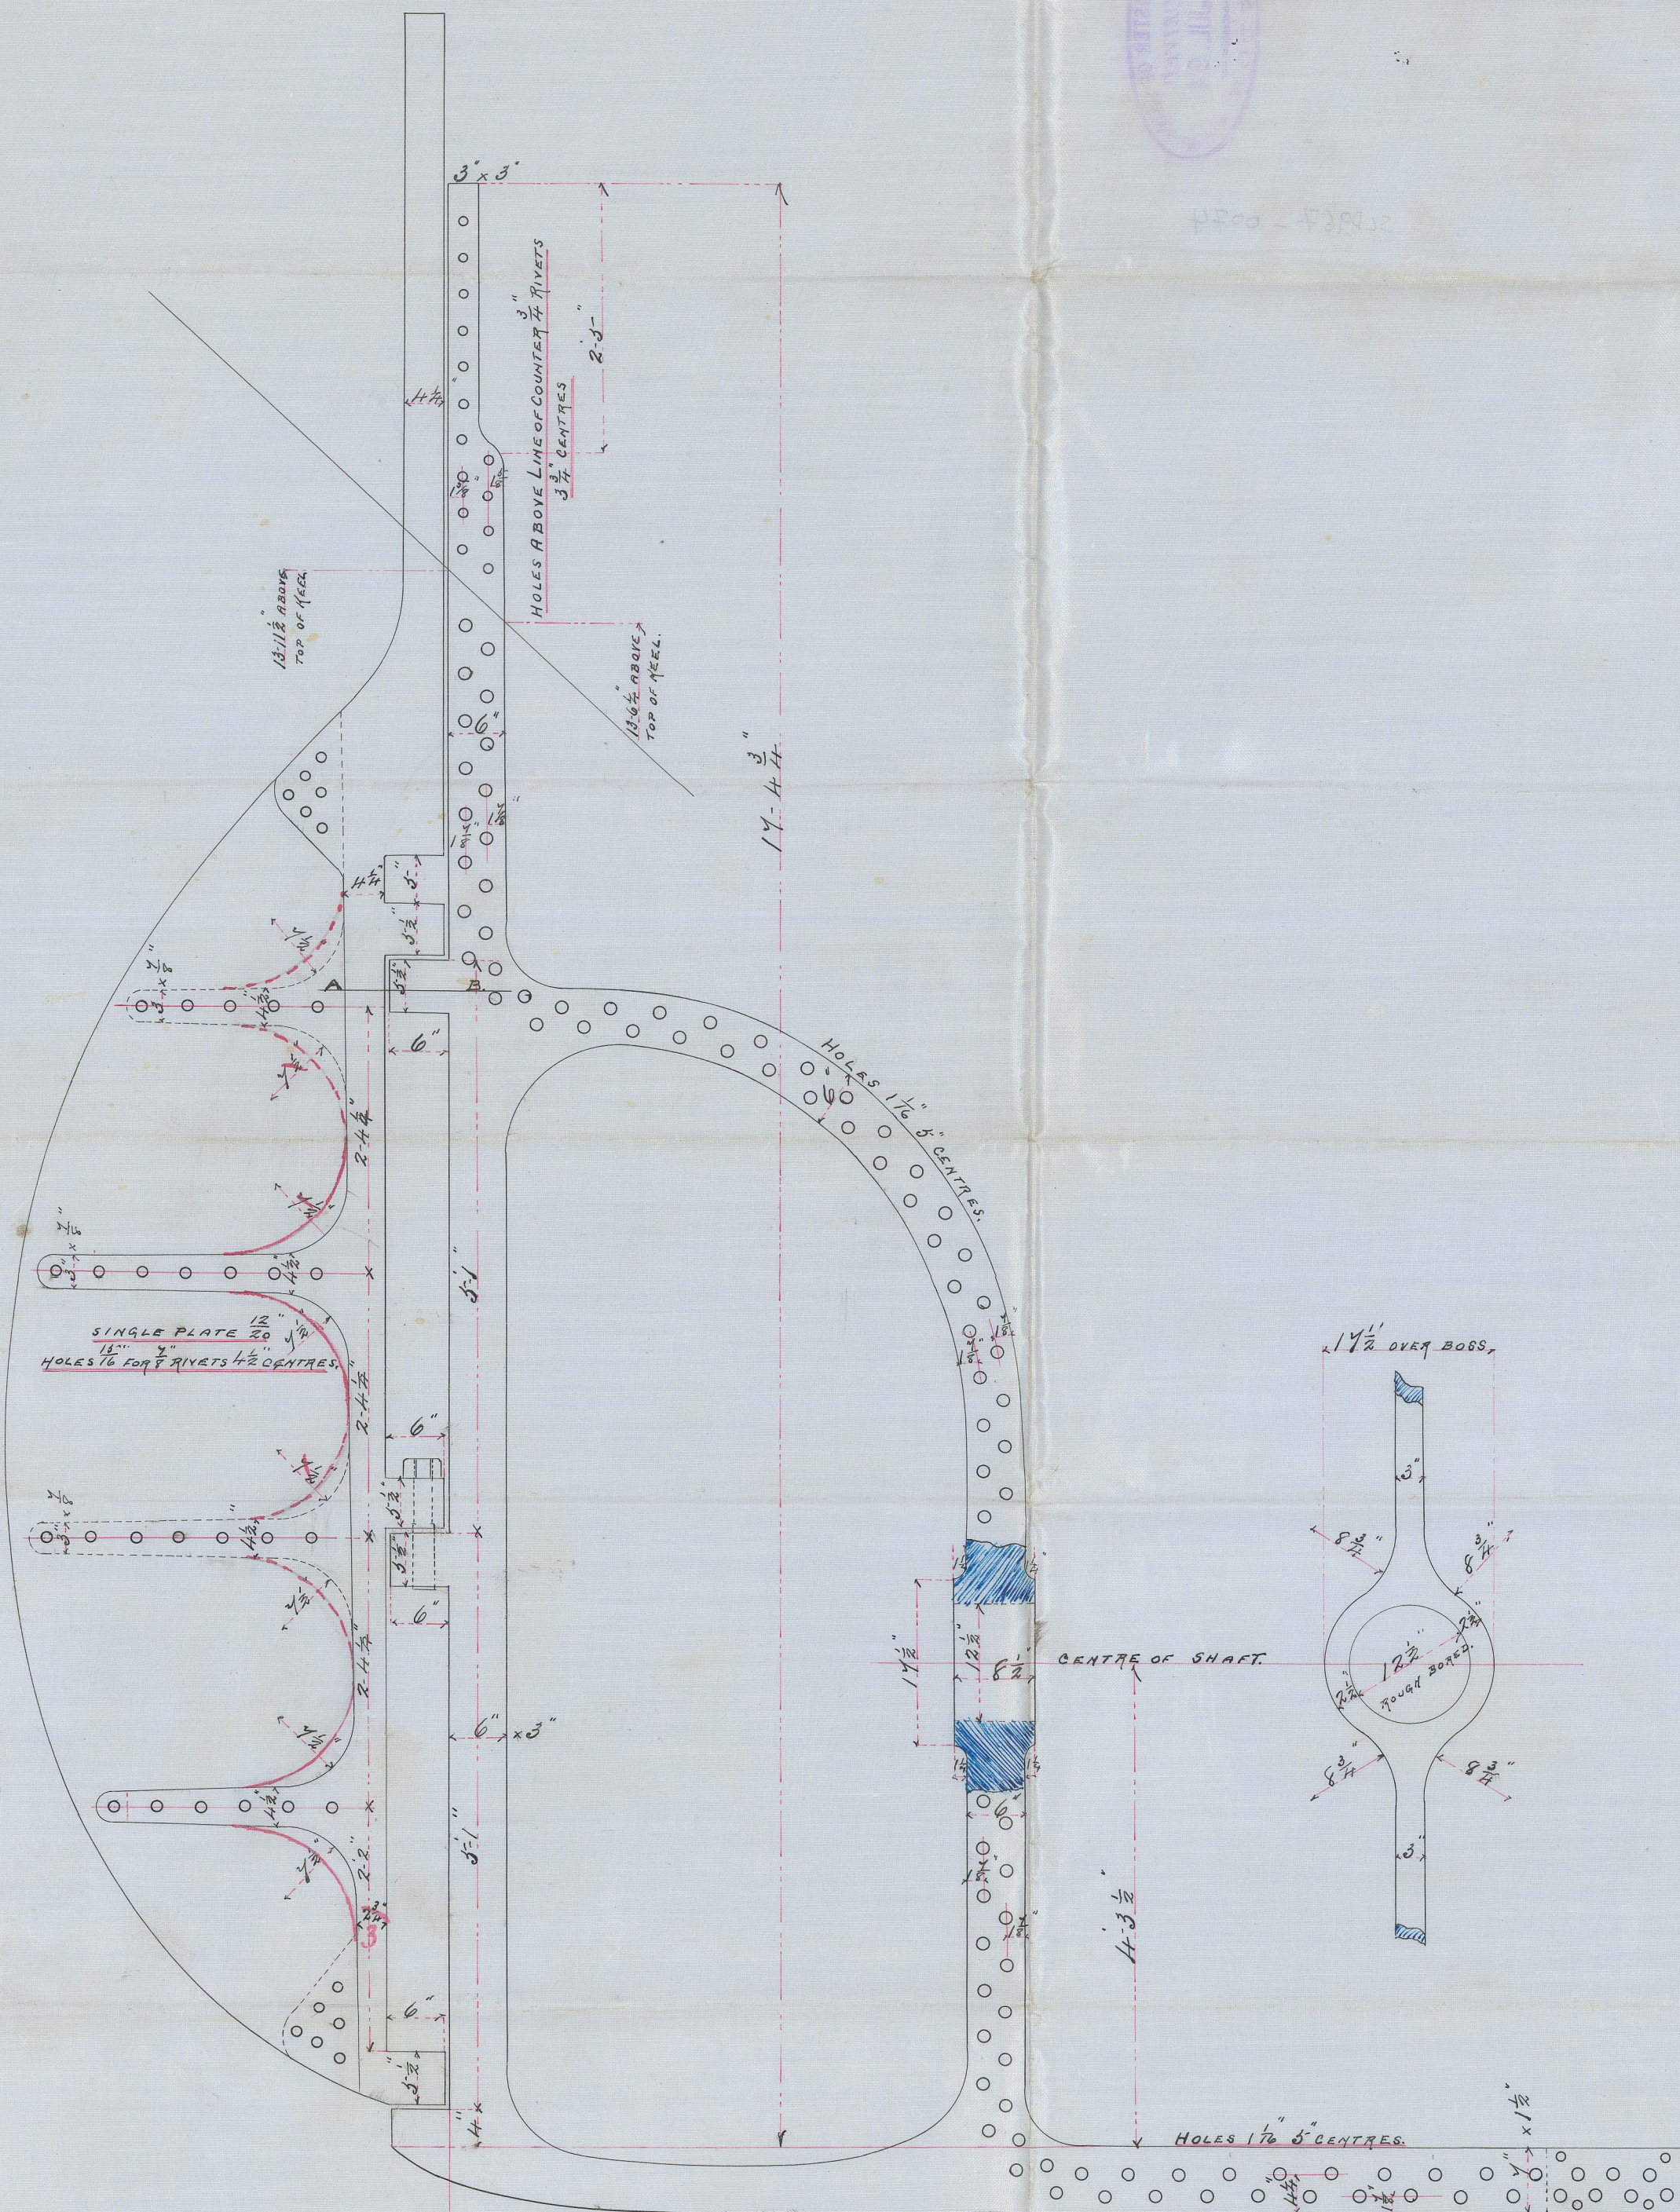
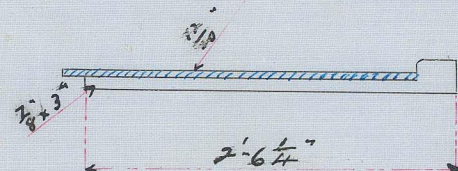
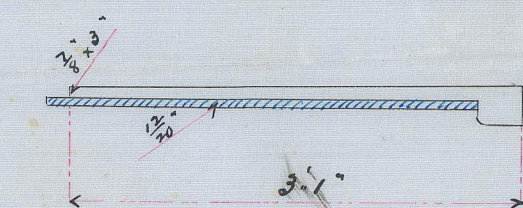
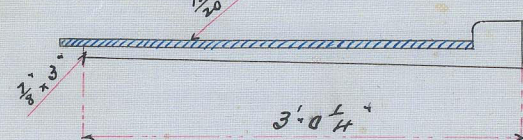
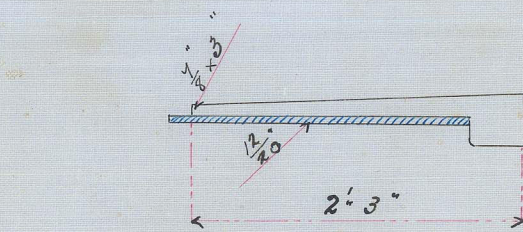


31.7.94

STERN-POST & RUDDER

S.S. N^o 48

SCALE $\frac{3}{4}$ INCH = 1 FOOT.

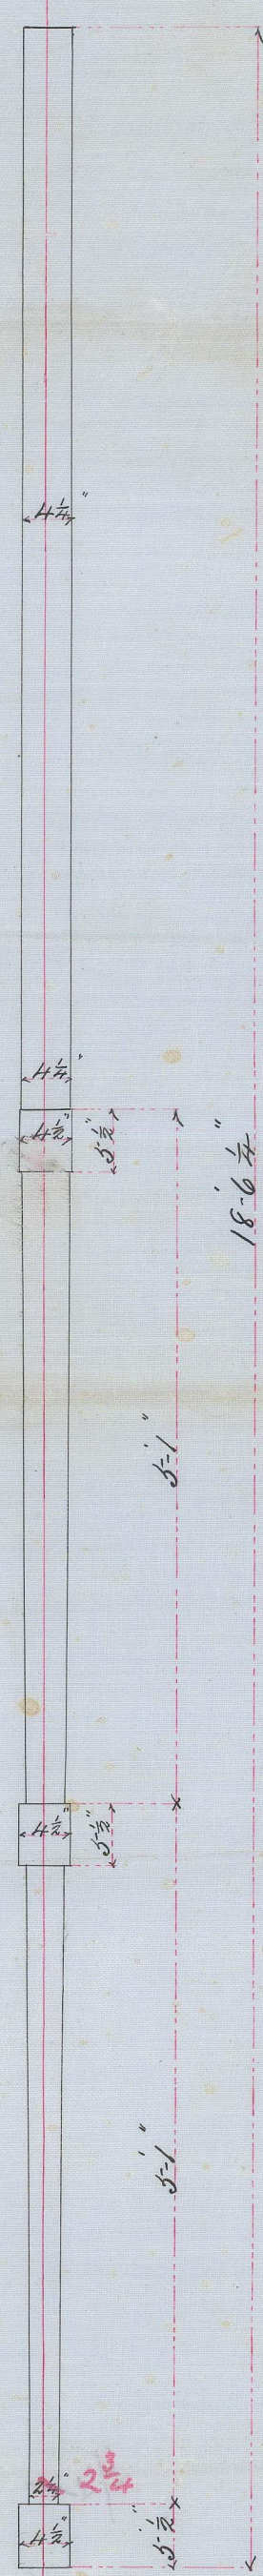

30/7/94


26/7/94

45/6/92
30



STERN-POST & RUDDER

S.S. "Hilse" Glasgow Report No. 13340

SCALE 1/4 INCH = 1 FOOT

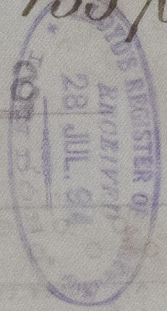

SLD967-0074

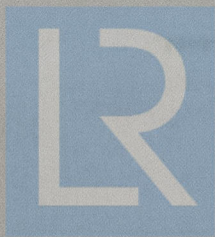 

© 2021

Lloyd's Register
Foundation