


Expansion of Plating at Break & Bridge House

S. S. No 48.

Scale $\frac{1}{4}$ Inch = 1 Foot.

28.6.94

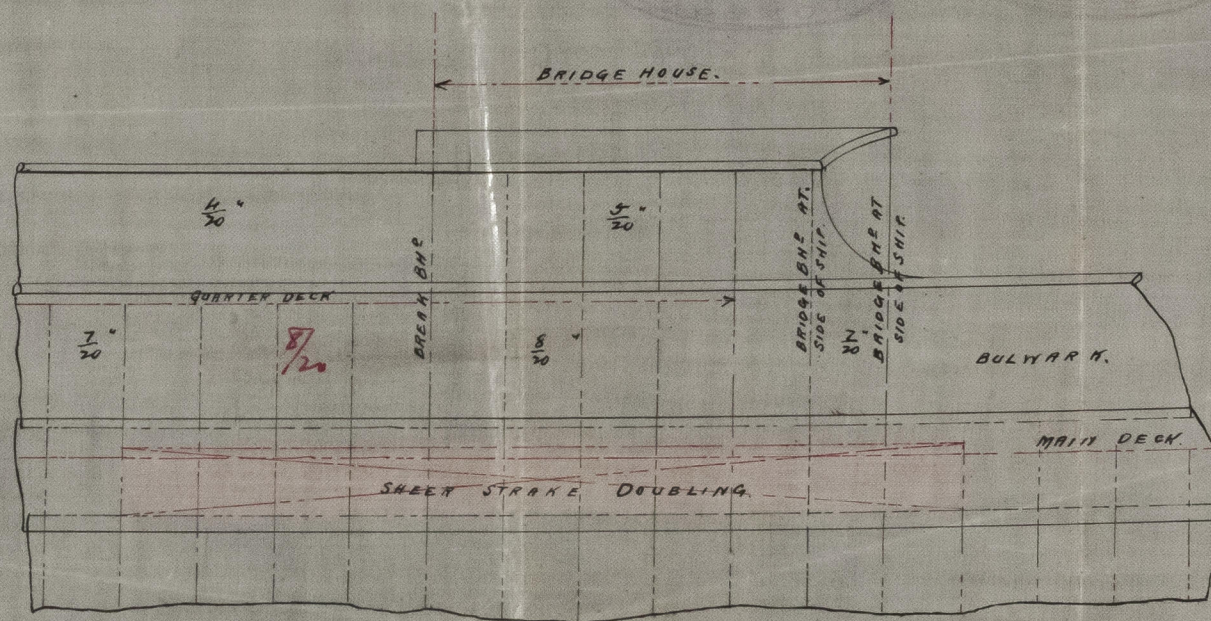

28/6/94



© 2021

Lloyd's Register Foundation

SLD967-0080

26/6/94



SLD967-0080

40.1-26



Original

27/6/94



© 2021

Lloyd's Register
Foundation