

28.6.94

MIDSHIP SECTION.

S. S. N° 48.

TO CLASS 100A.1. QUARTER DECK BRIDGE & TOP OF CASTLE.

SCALE 1/2 INCH = 1 FOOT.


DEPTH 11.2
1/2 BREADTH 11.25
1/2 GIRTH 20.1
 $42.55 \times 140.5 = 5978 = 2^{nd} N^o$
 $+ 77.5 = 6055.5$
 $6055.5 = EQUIP^t N^o$
 6576

PROPORTIONS.
DEPTH TO LENGTH 12.54
BREADTH TO LENGTH 6.24.

EQUIPMENT "C."

2 BOWER ANCHORS 16" dia. 8 1/2" CWT. STOCKLESS.
1 STREAM 2
1 HEDGE 1
165 FMS 3/4" STUD CHAIN CABLE, MIN. WT. 74.1.26.
45 1/2" STUD CHAIN CABLE, MIN. WT. 9.3.0.
75 1" TOWLINE.
90 5" HAWSER.

FORECASTLE DECK BEAMS 4 1/2" x 3" x 20 on alternate frames.
STRAINER 20" x 20 to 16" x 20.
TIES 1" x 20 DECK 2 1/2" PINE.
BRIDGE DECK BEAMS 4 1/2" x 3" x 20 on alternate frames.
STRAINER 20" x 20 DECK 2 1/2" PINE.
TIES 1" x 20 SIDE PLATING 20."

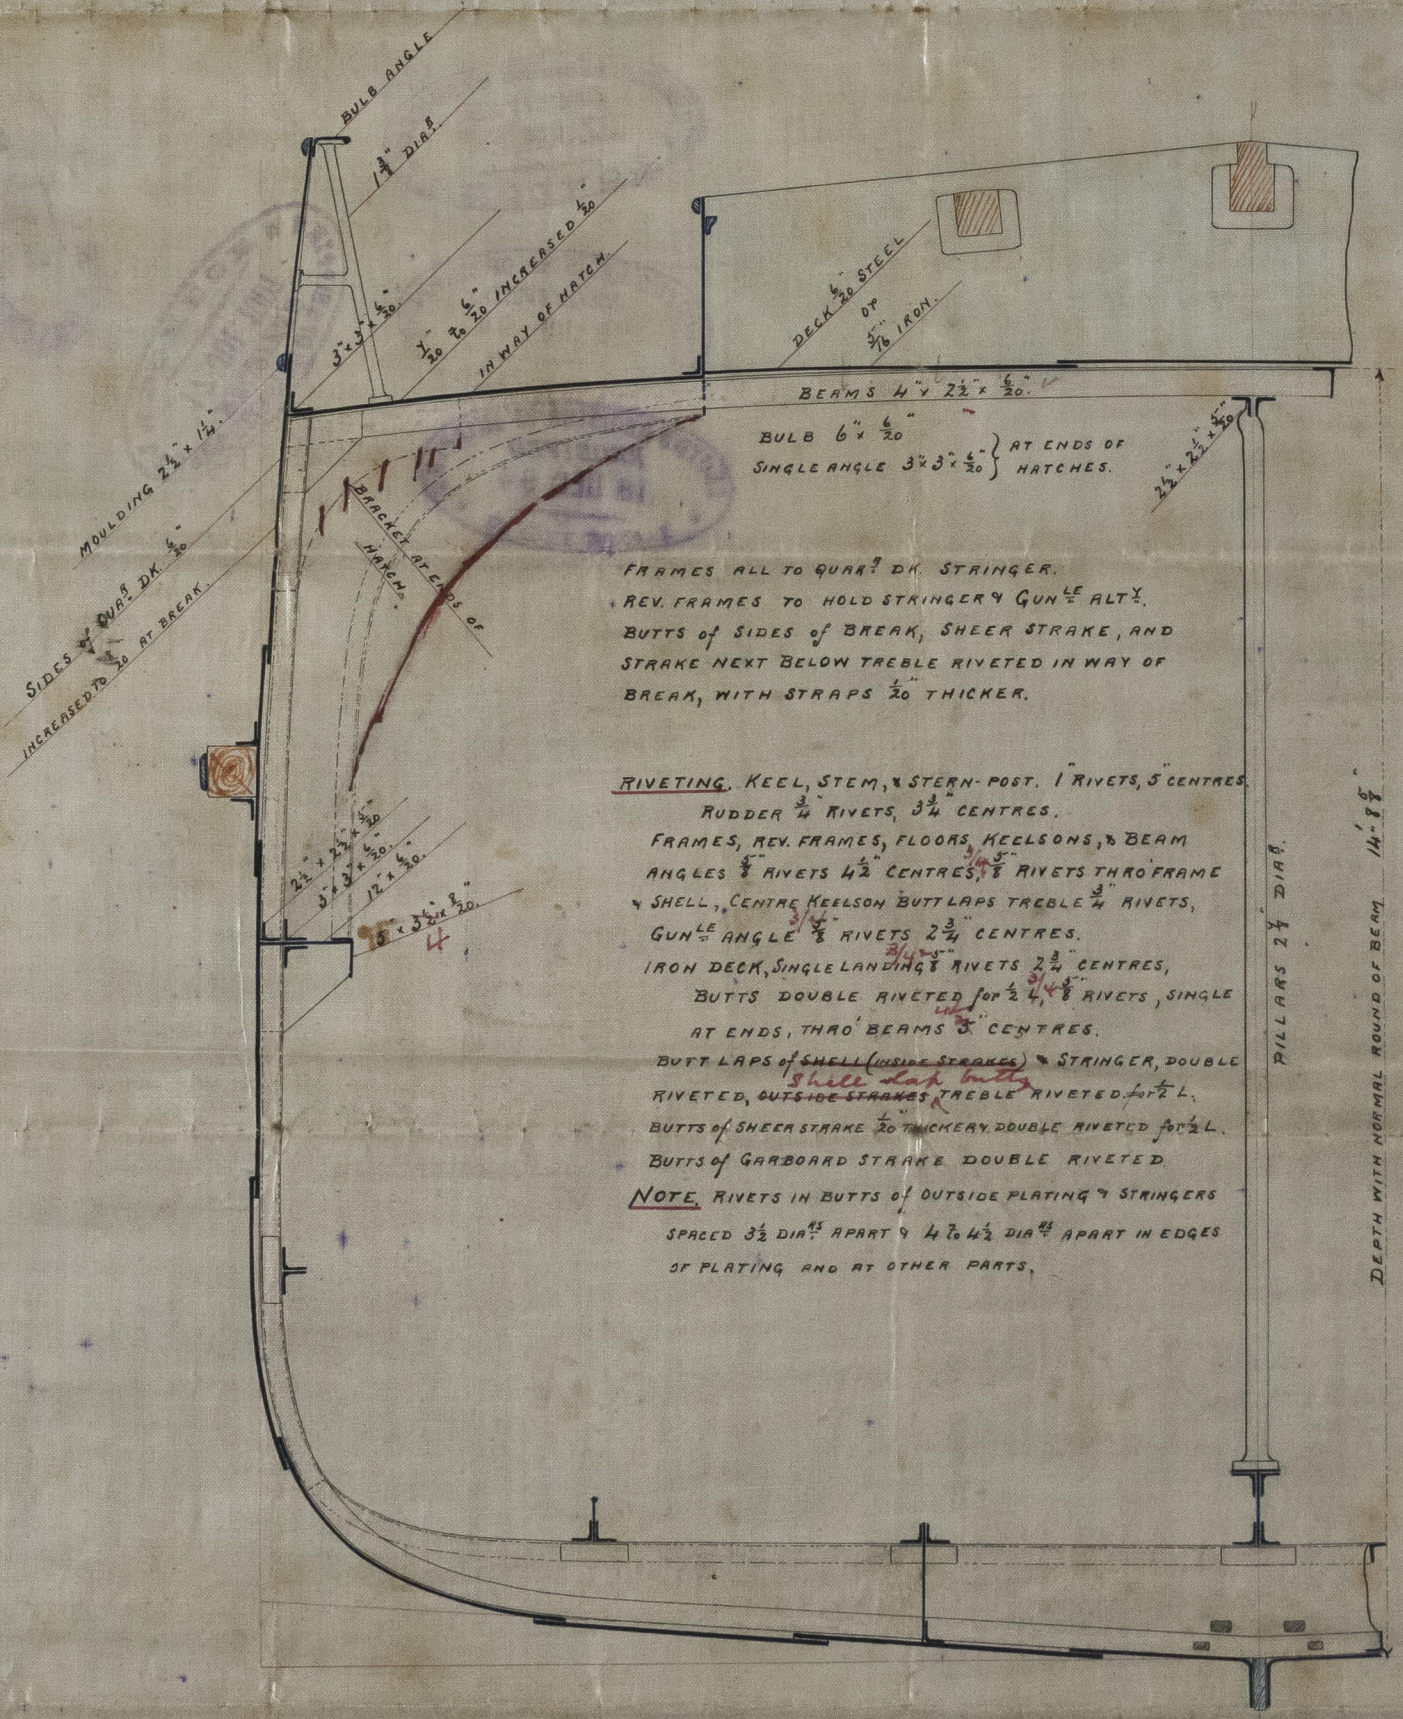

BUTTS OF SIDES OF BREAK, SHEER STRAKE, AND
STRAKE NEXT BELOW TABLE RIVETED IN WAY OF
BREAK, WITH STRAPS 3/4" THICKER.

RIVETING. KEEL, STEM, & STERN-POST. 1 RIVETS, 5 CENTRES.
RUDDER 1/4 RIVETS, 3/4 CENTRES.
GUN ALT. 1/2 RIVETS 2 1/2 CENTRES.
IRON DECK, SINGLE LANDING 1/2 RIVETS 2 1/2 CENTRES,
BUTTS DOUBLE RIVETED FOR 2 1/4 RIVETS, SINGLE
AT ENDS, THRO' BEAMS 3 CENTRES.
BUTTS OF SHEER STRAKE 3/4 THICKEN, DOUBLE RIVETED FOR 1/4 L.
BUTTS OF GARBORD STRAKE DOUBLE RIVETED.

NOTE. RIVETS IN BUTTS OF OUTSIDE PLATING & STRAINERS
SPACED 3 1/2 DIA. APART & 4 1/2 DIA. APART IN EDGES
OF PLATING AND AT OTHER PARTS.



KEEL 7" x 1 1/2" SCARPHS 12 1/2 LONG.
STEM 6" x 1 1/2" to 5" x 1 1/4".
STERN POST 6" x 8".
RUDDER STOCK 4" dia. HEEL & PINTLES 2 1/2" dia.
FRAMES 3" x 2 1/2" SPACED 21" APART, HEEL PIECES 2 1/2" LONG.
REV. FRAMES 2 1/2" x 2 1/2" TO BILGE STRAINER GUN ALT.
DOUBLED FROM BILGE TO BILGE IN 4" B. SPACES.
BULKHEADS 20" ANGLES 3" x 2 1/2" x 20".
FLOORS 15 1/2" x 20" + 20" IN ENGINE SPACE.
20" IN BOILER SPACE.

CL
26/6/94

28.6.94

RECEIVED
27 JUN 94
LONDON

RECEIVED
28 JUL 1894

RECEIVED
18 DEC 94
LONDON



SLD967- 0081

Lloyd's Register
Foundation