


See h to 512

THE PATENT

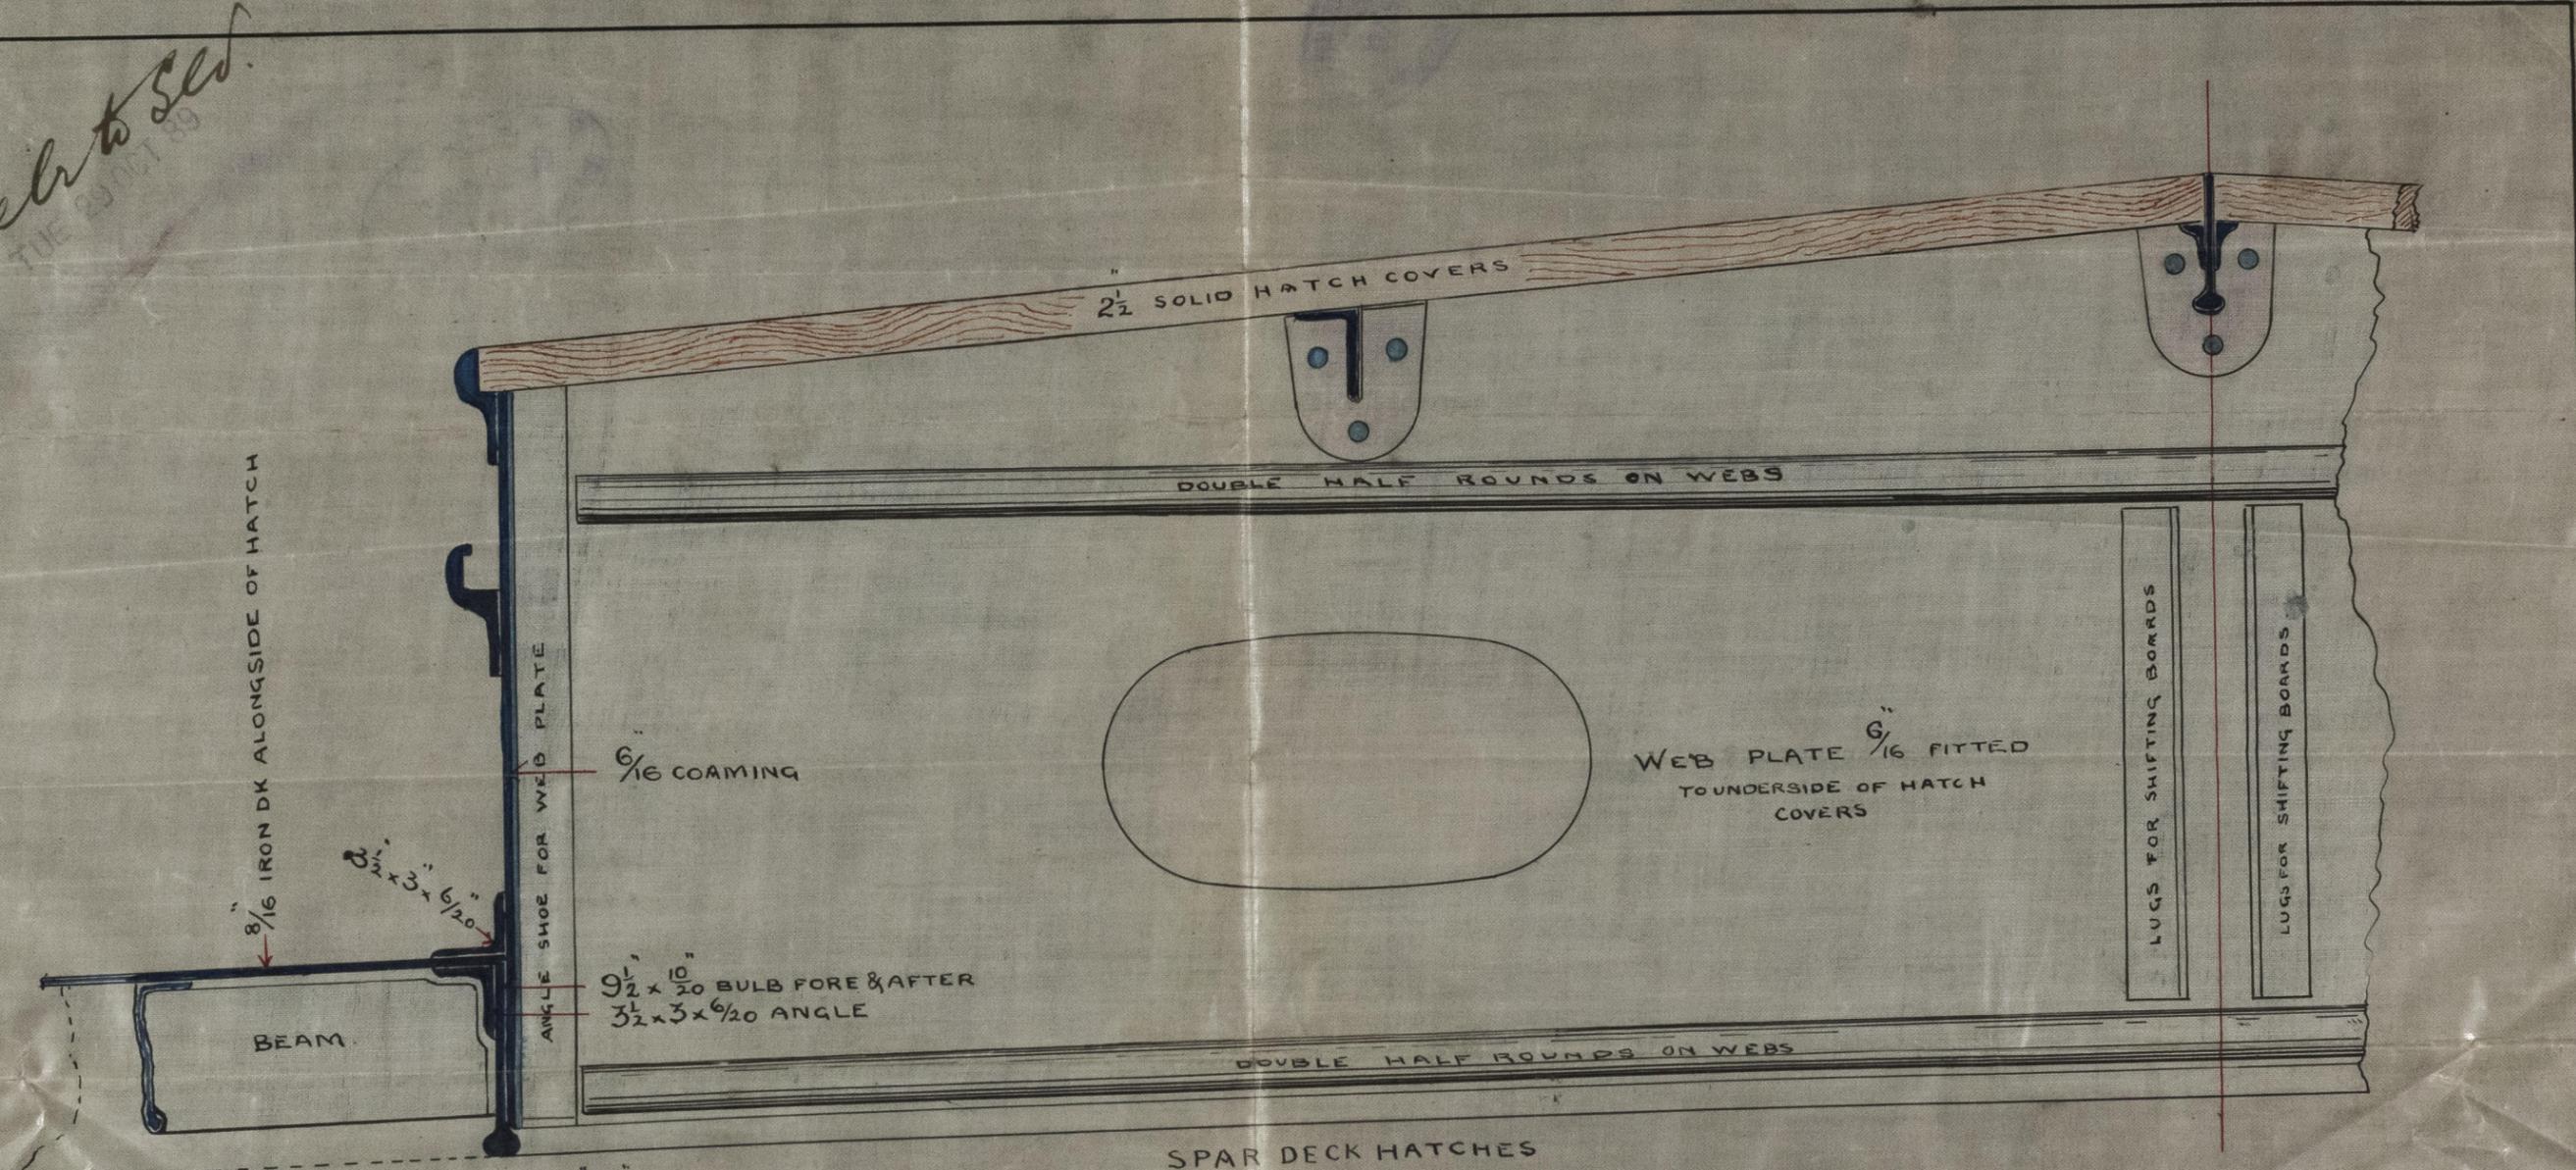


SPAR DECK HATCHES

MATCH COAMINGS AS FITTED SHEWING FORE & AFT CARLINGS



Nº 192 . S.S

Scale 1 1/2 inches = 1 foot


HATCHEND BEAM 9 1/2" x 10" BULB
SINGLE ANGLE 5 x 3 1/2" x 3/20

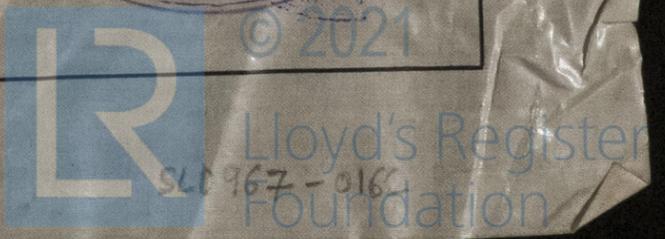

"Maori King"
Sld 153522

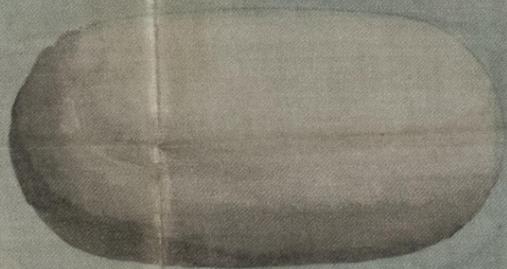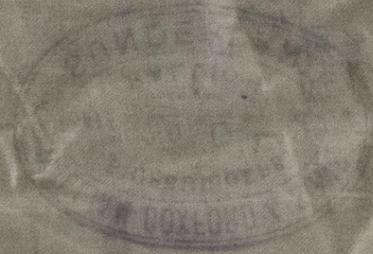


 

© 2021

Lloyd's Register
Foundation