



THU 16 MAY 89  
SAT 10 AUG 89  
MON 14 DEC 89

~~No 323 design~~

Yard No. 192.

Amended sizes of topside & sheer strakes  
Scale  $\frac{1}{2}'' = 1'-0''$

Stringer 52 x 8/20  
doubling 40 x 8/20

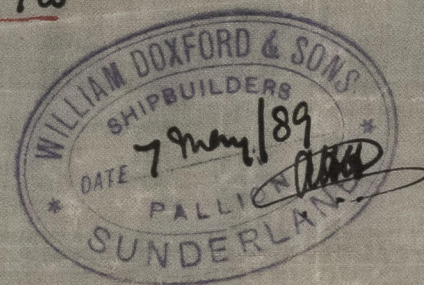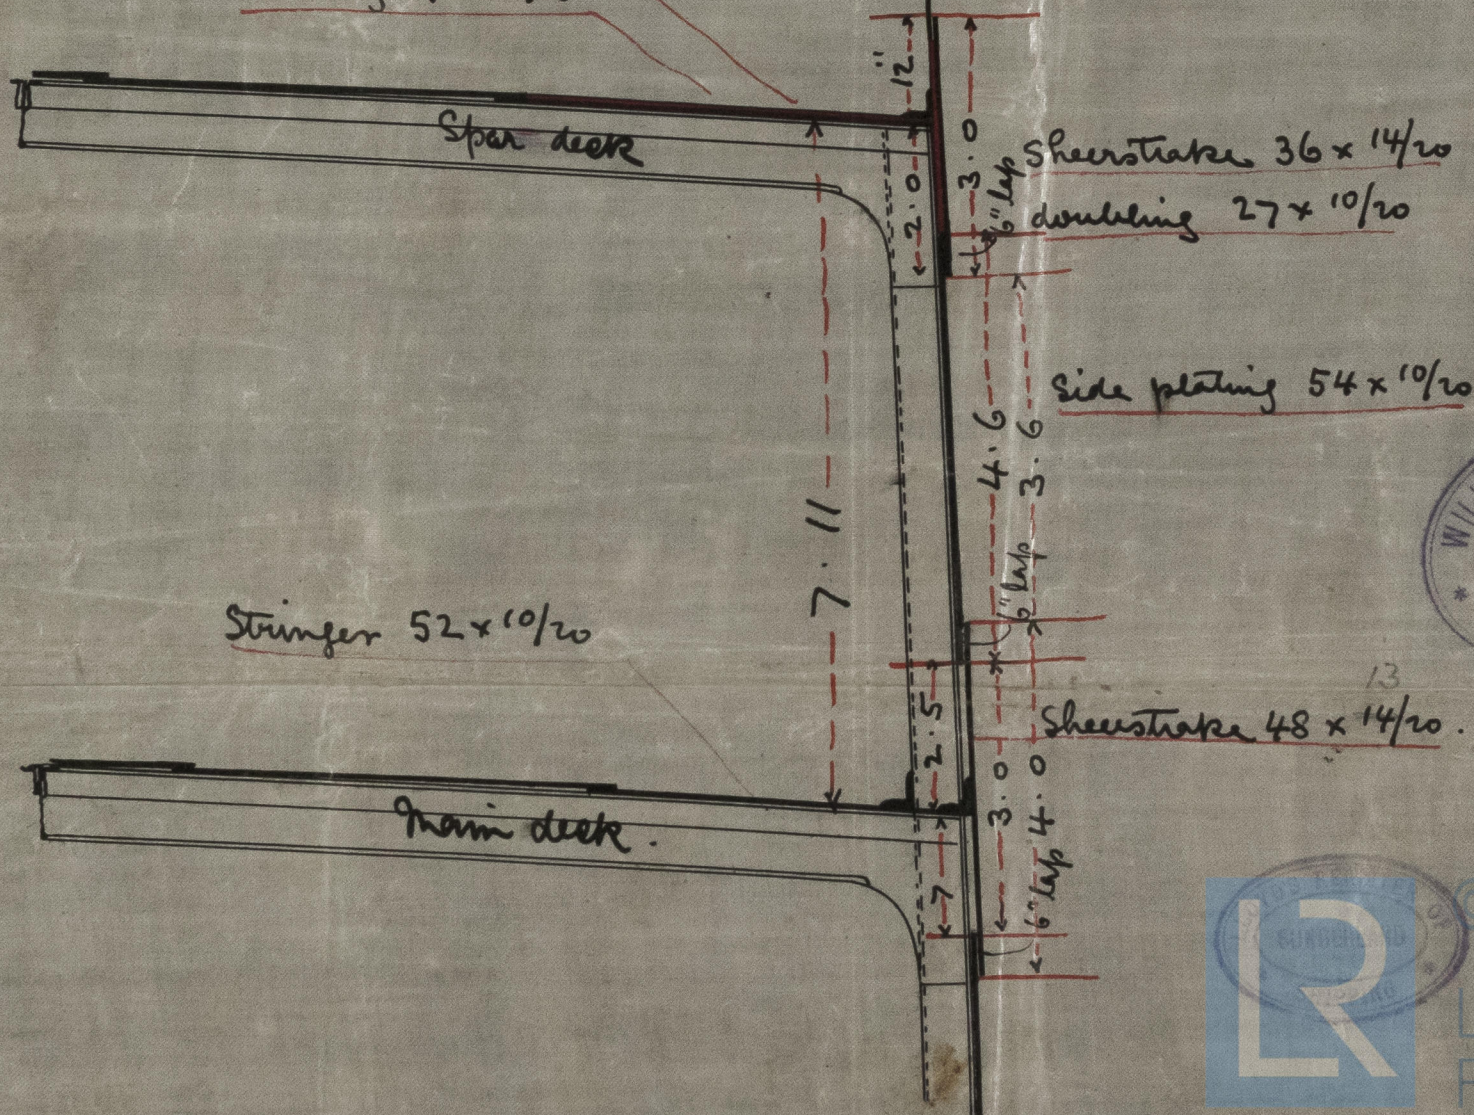

© 2021

Lloyd's Register  
Foundation

SLD957-0178