



SCALE  $\frac{1}{4}'' = 1 \text{ FT.}$

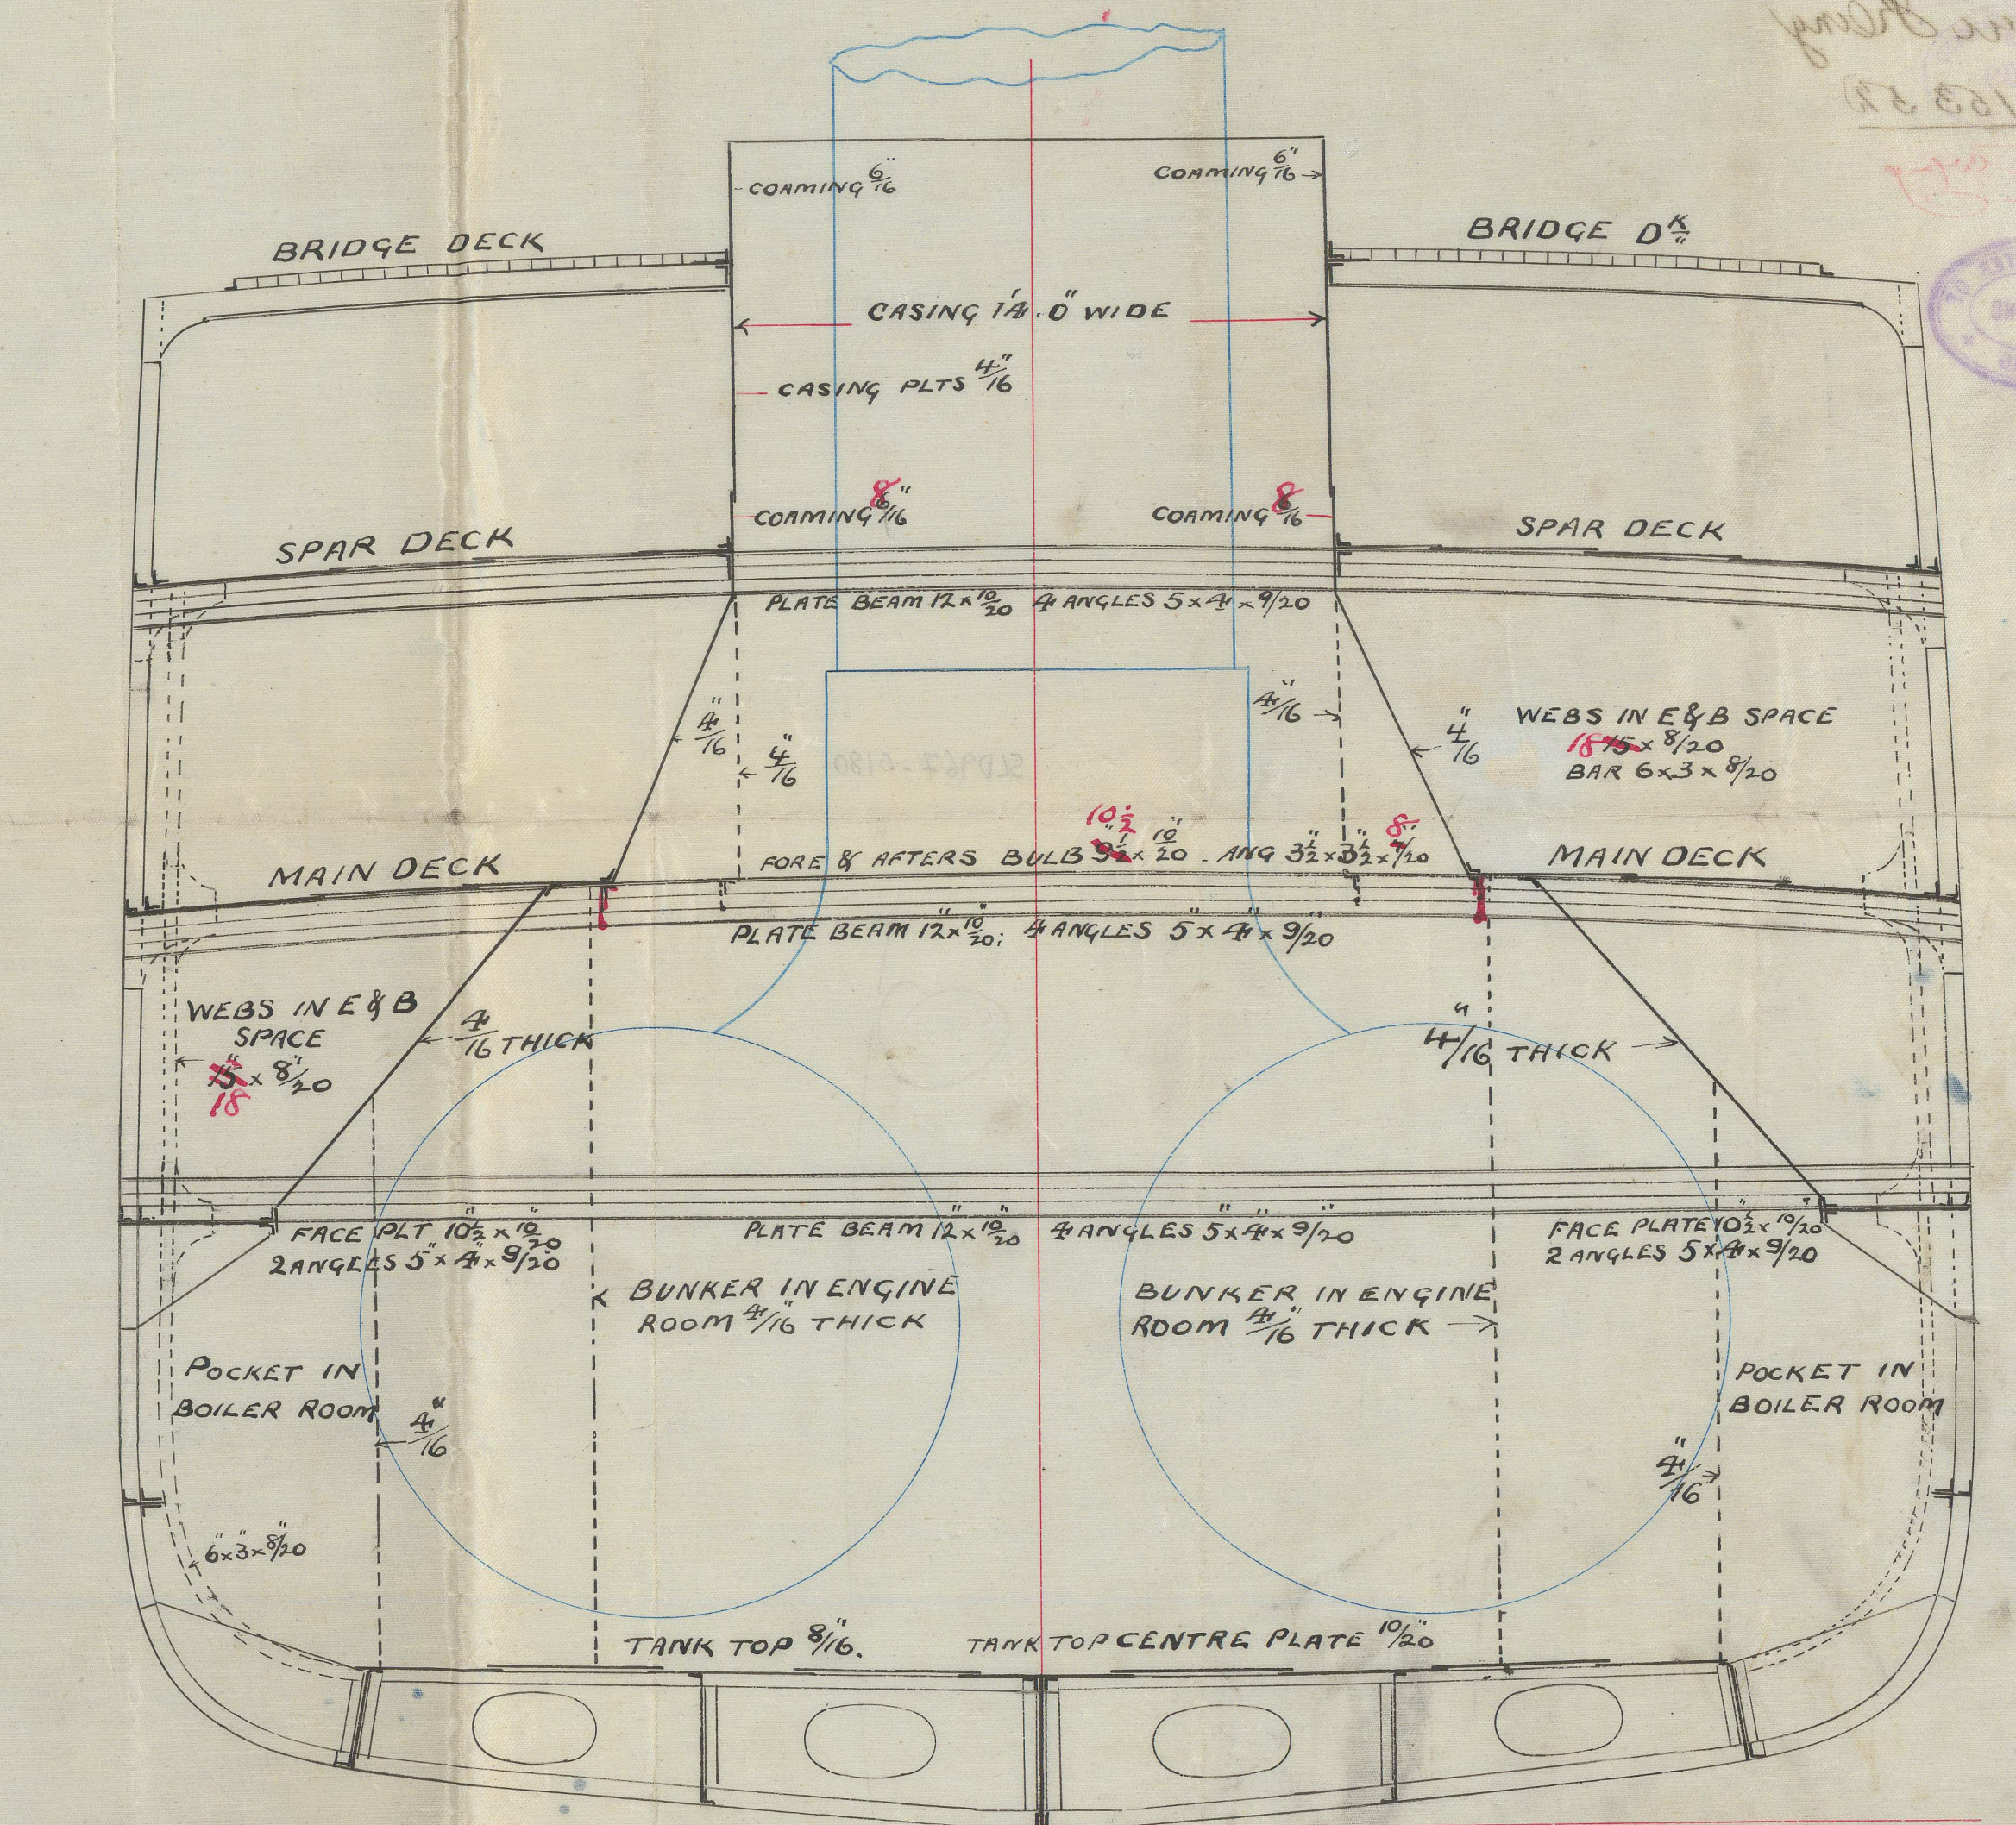

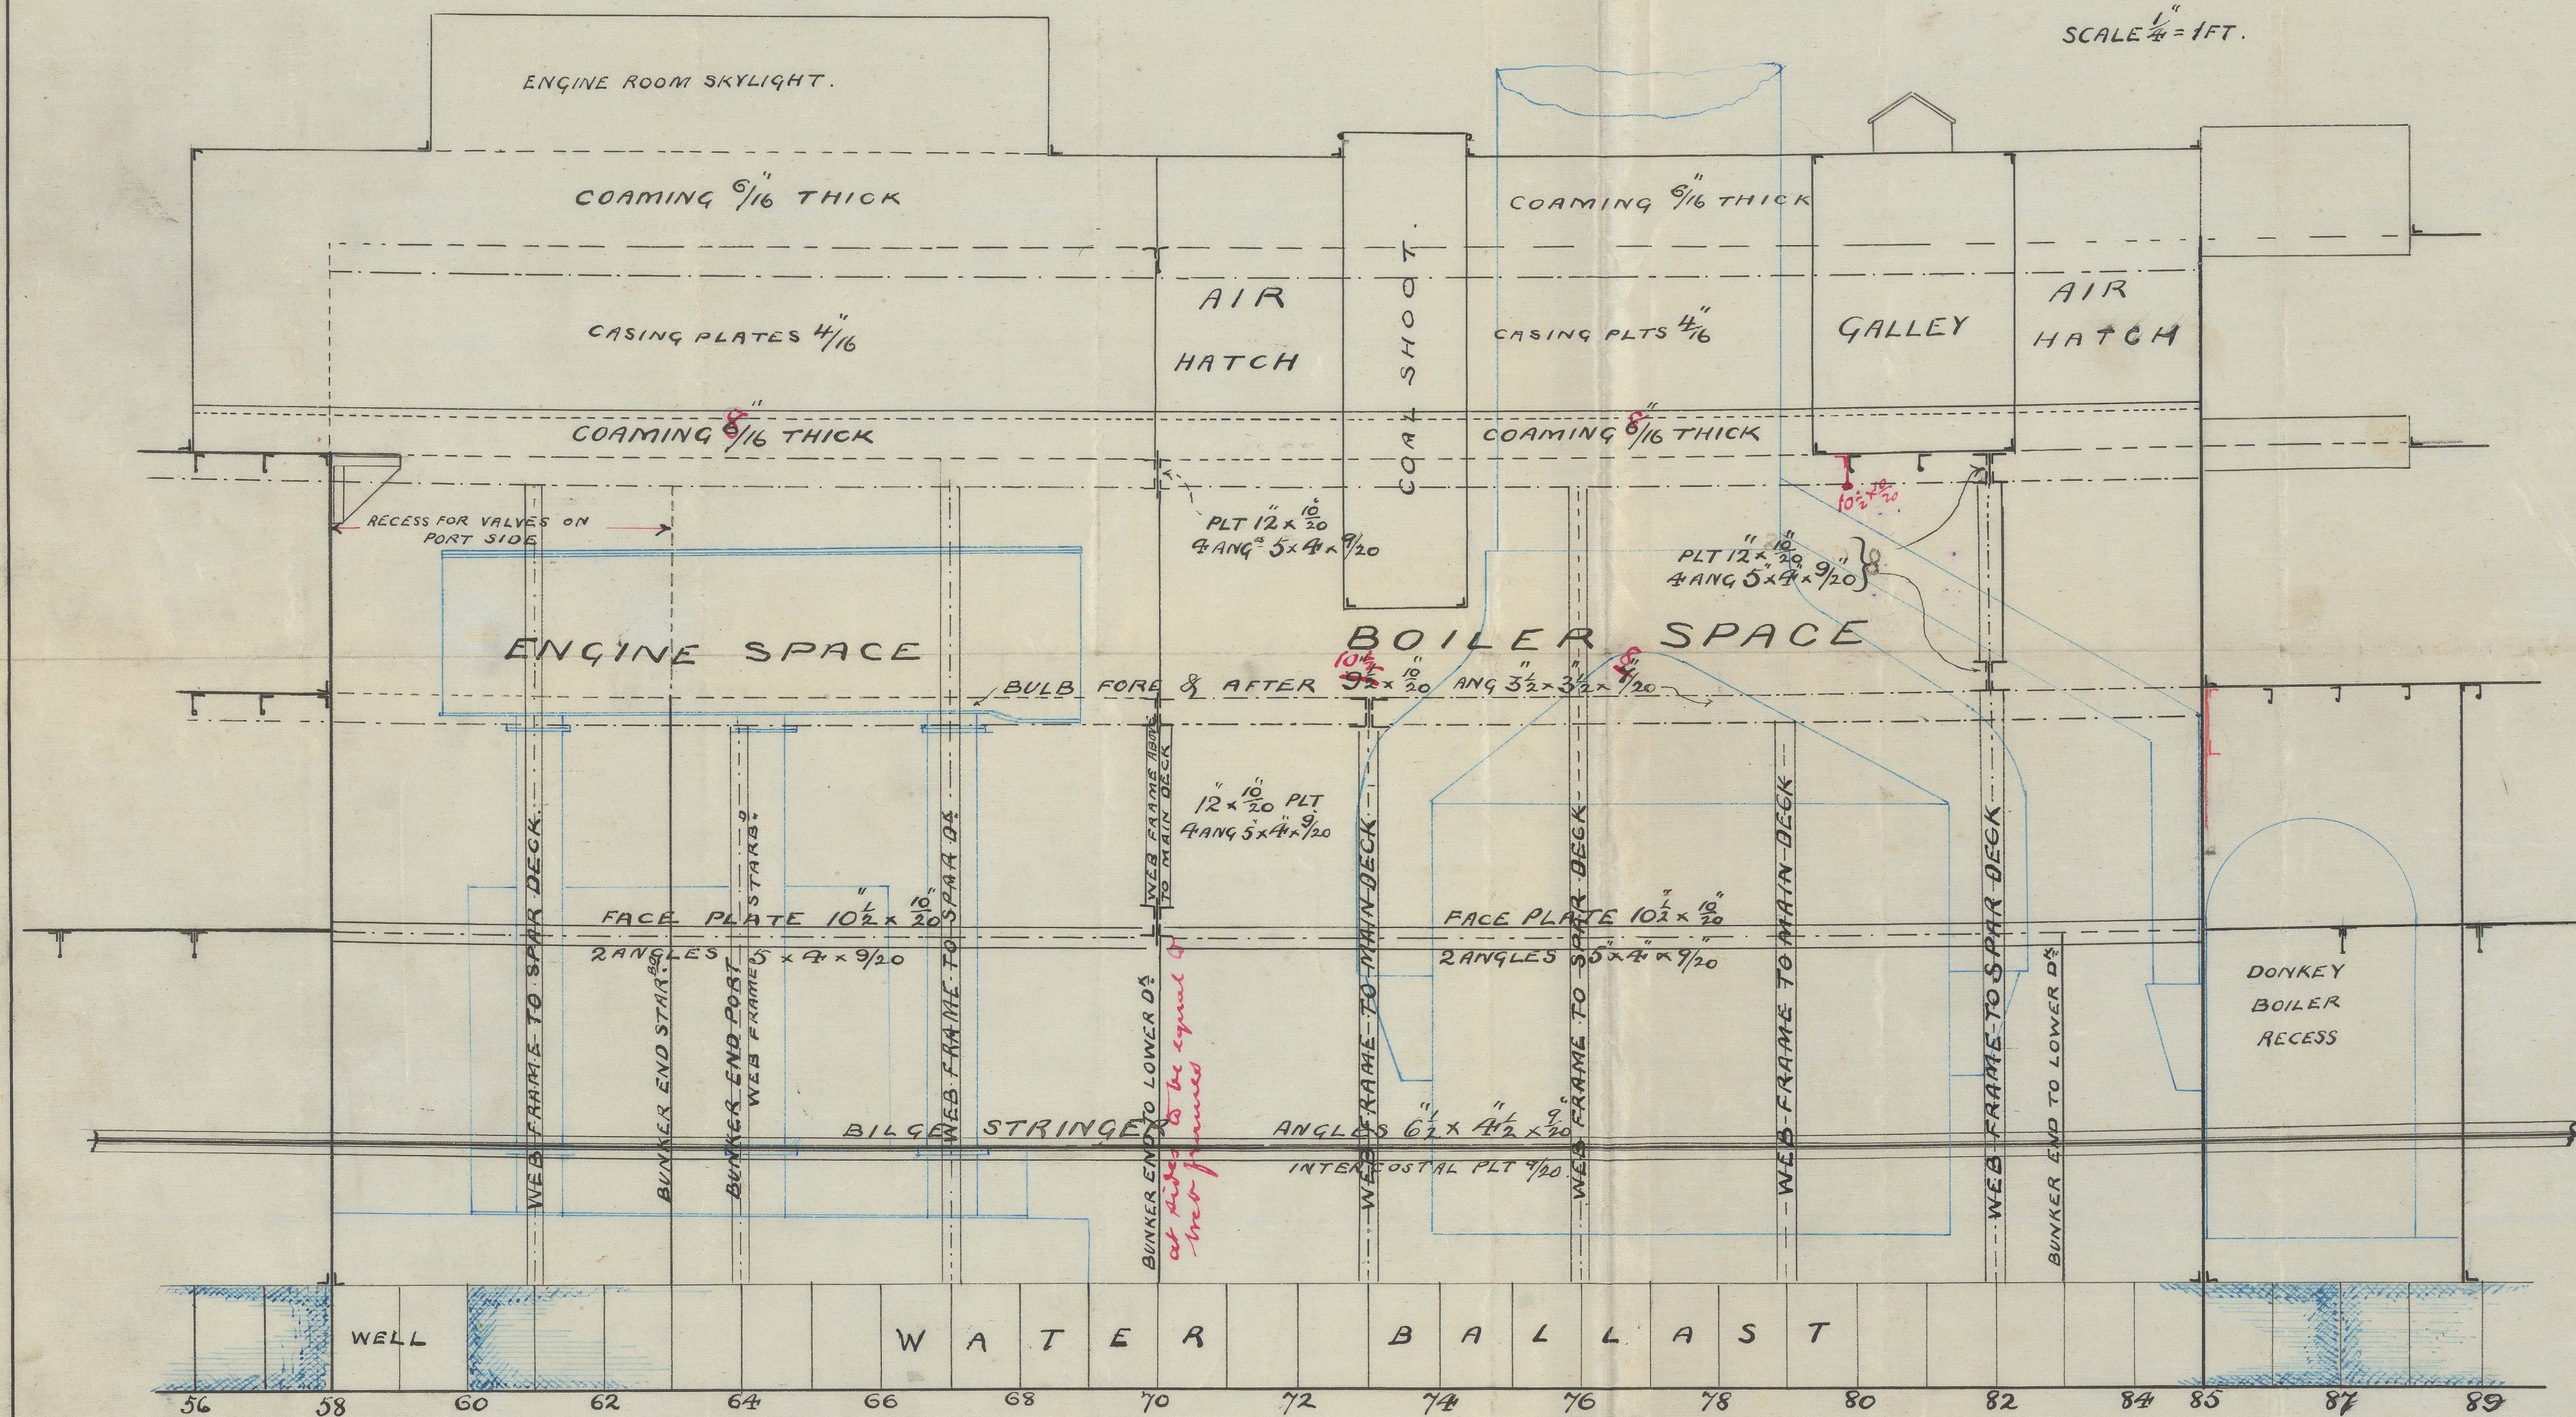

No 192 s/s

From Oxford this

Shrou Beams &  
Web frames in  
27 Boiler Space  
" Maori King "  
Std 153 5 1/2

Official Copy

