


Ms. Mary Phipps Sld No 15428


PLAN OF DECKS No 193 SHIP

SCALE 1/8 INCH = ONE FOOT


SPAR DECK

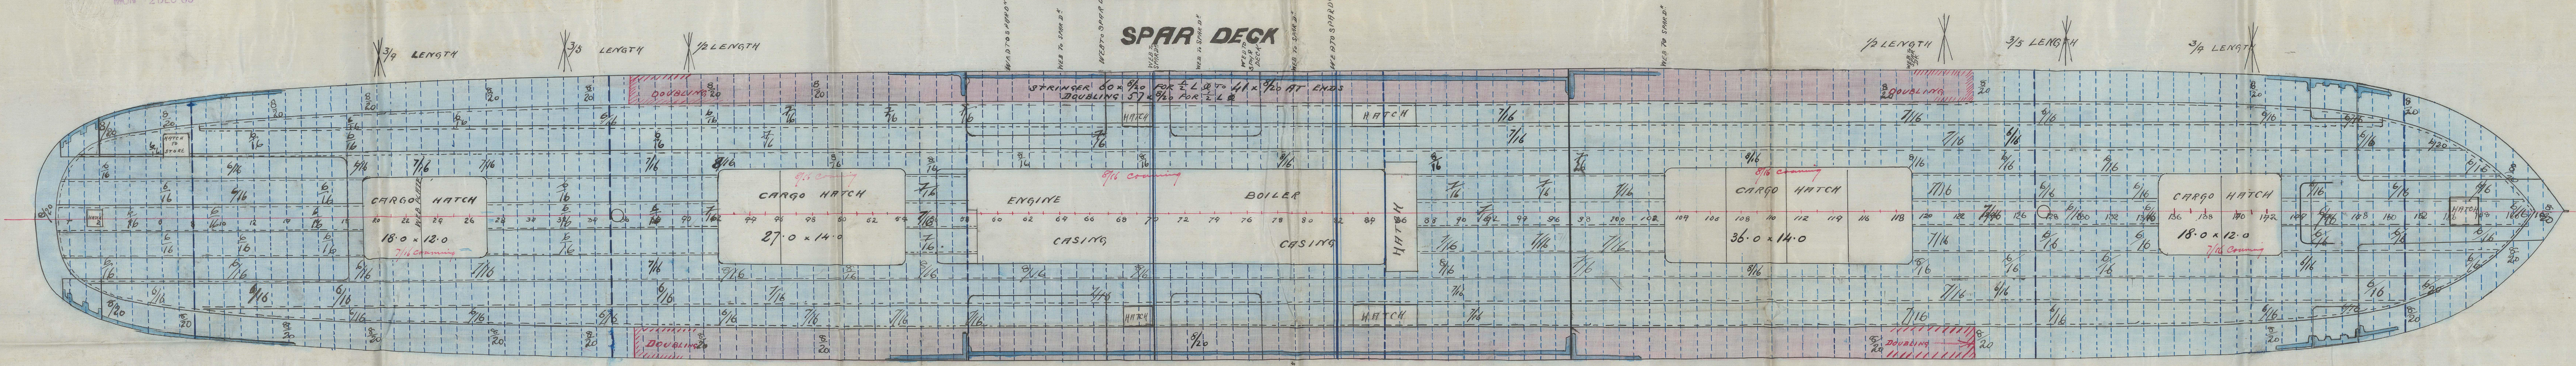


MAIN DECK

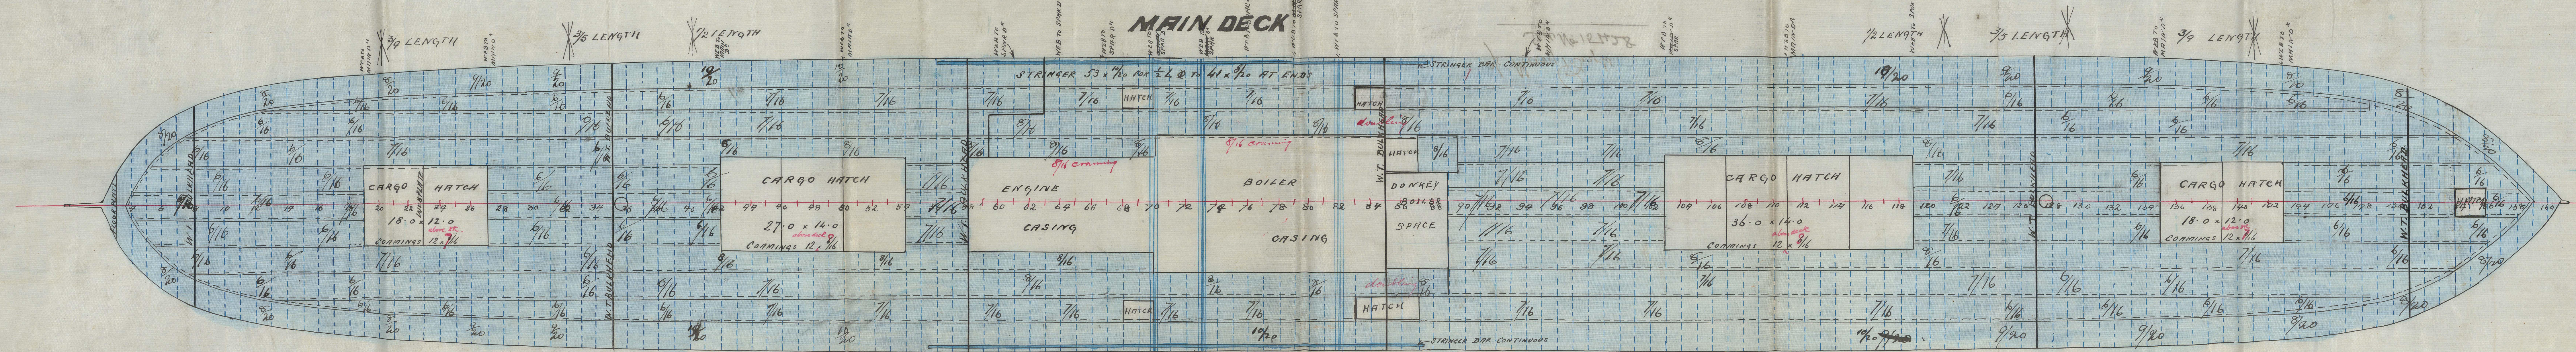

LOWER DECK

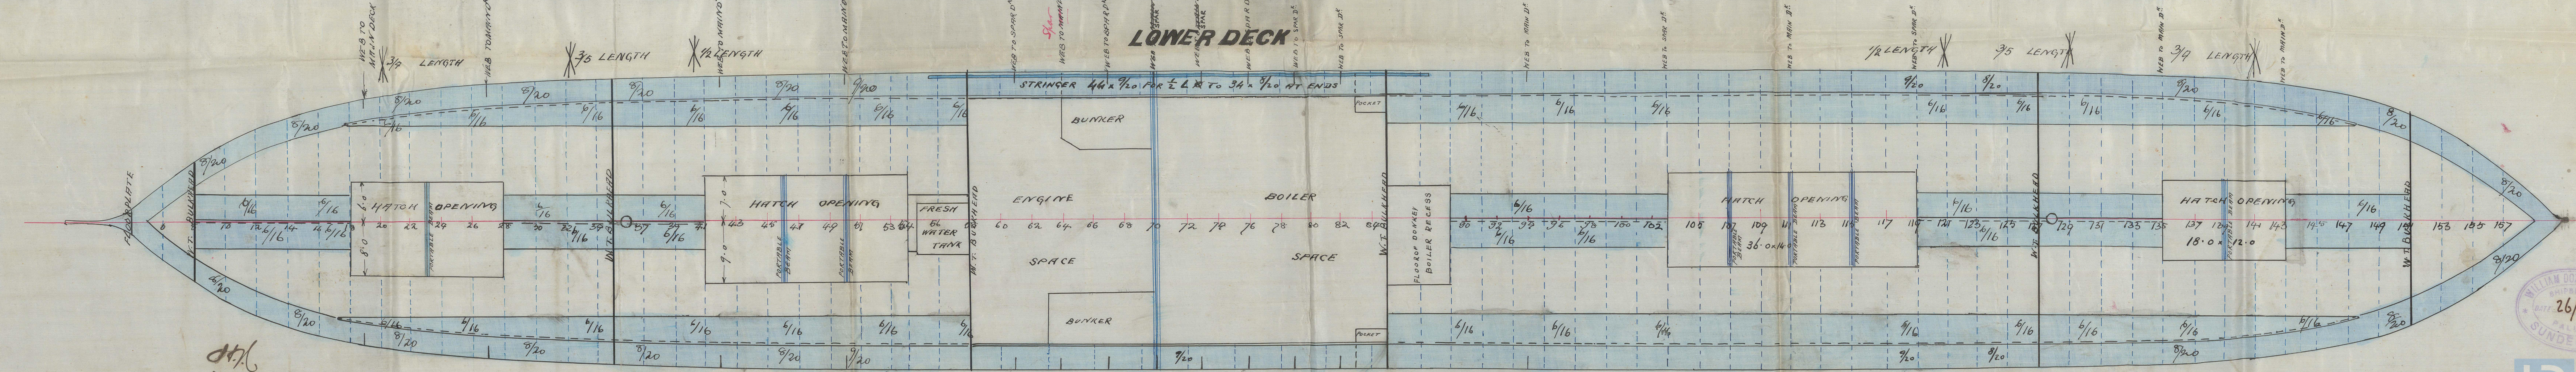


26/11/89
SUNDERLAND


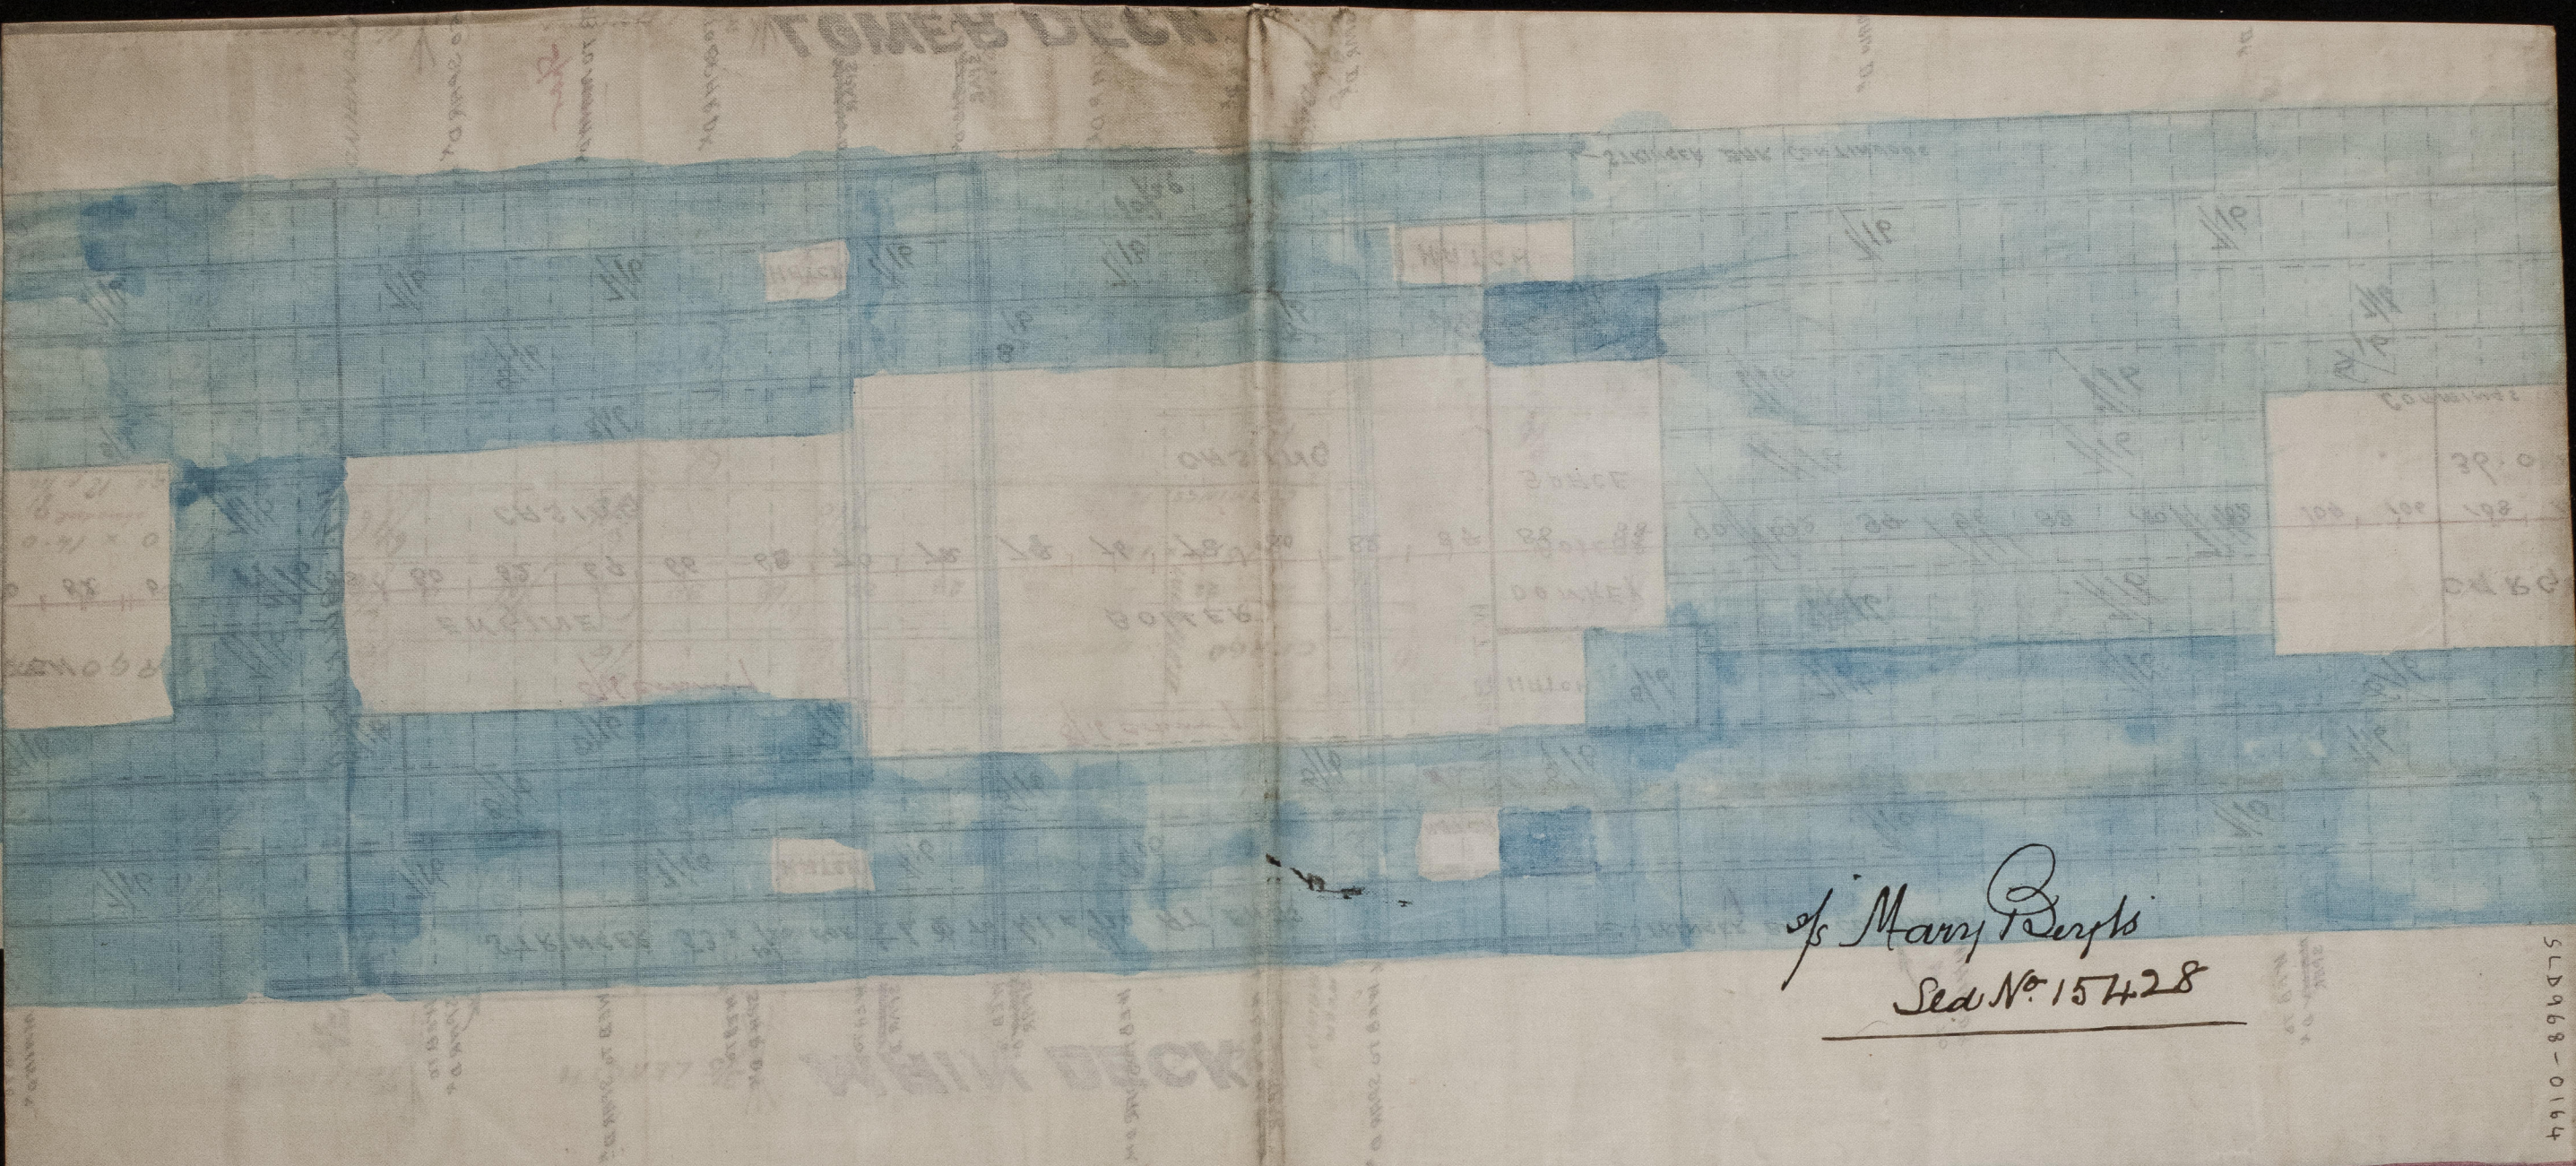


of Mary Perls
Sed No 15428

SLD968-0164

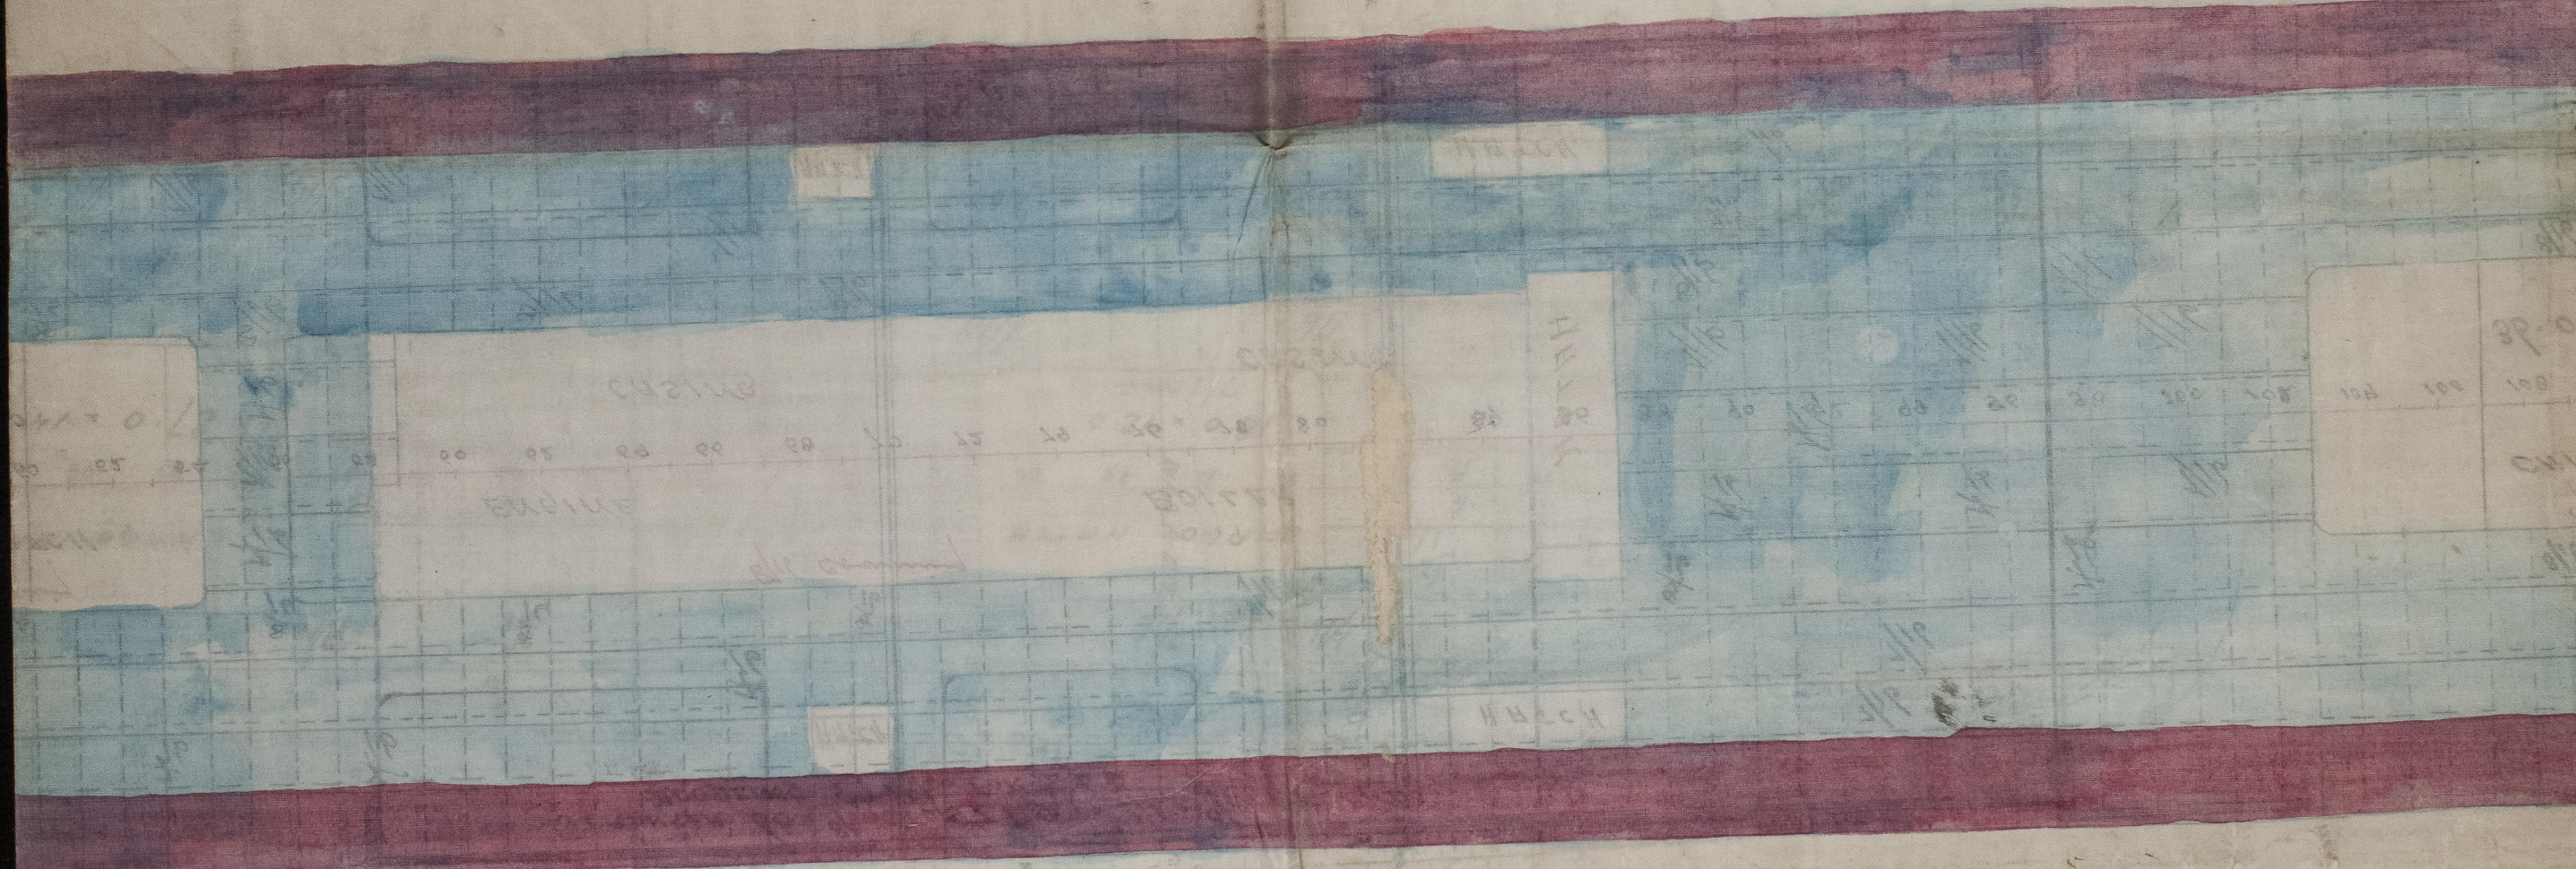

PLAN OF DECKS
SHIP
SCALE 1/8 INCH = ONE FOOT

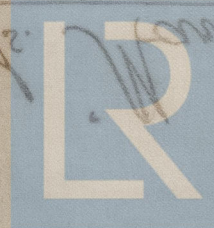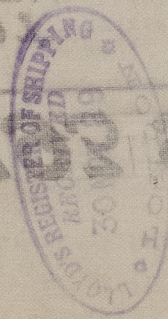

© 2024
Lloyd's Register
Foundation