

26/9/89


Ms. Lady Salisbury SUNDERLAND. No 15429

-TANK SUCTIONS. 167.

SCALE $\frac{1}{8}$ = one foot

S. P. AUSTIN & SONS
IRON & STEEL SHIPBUILDERS
AND
REPAIRERS
SUNDERLAND


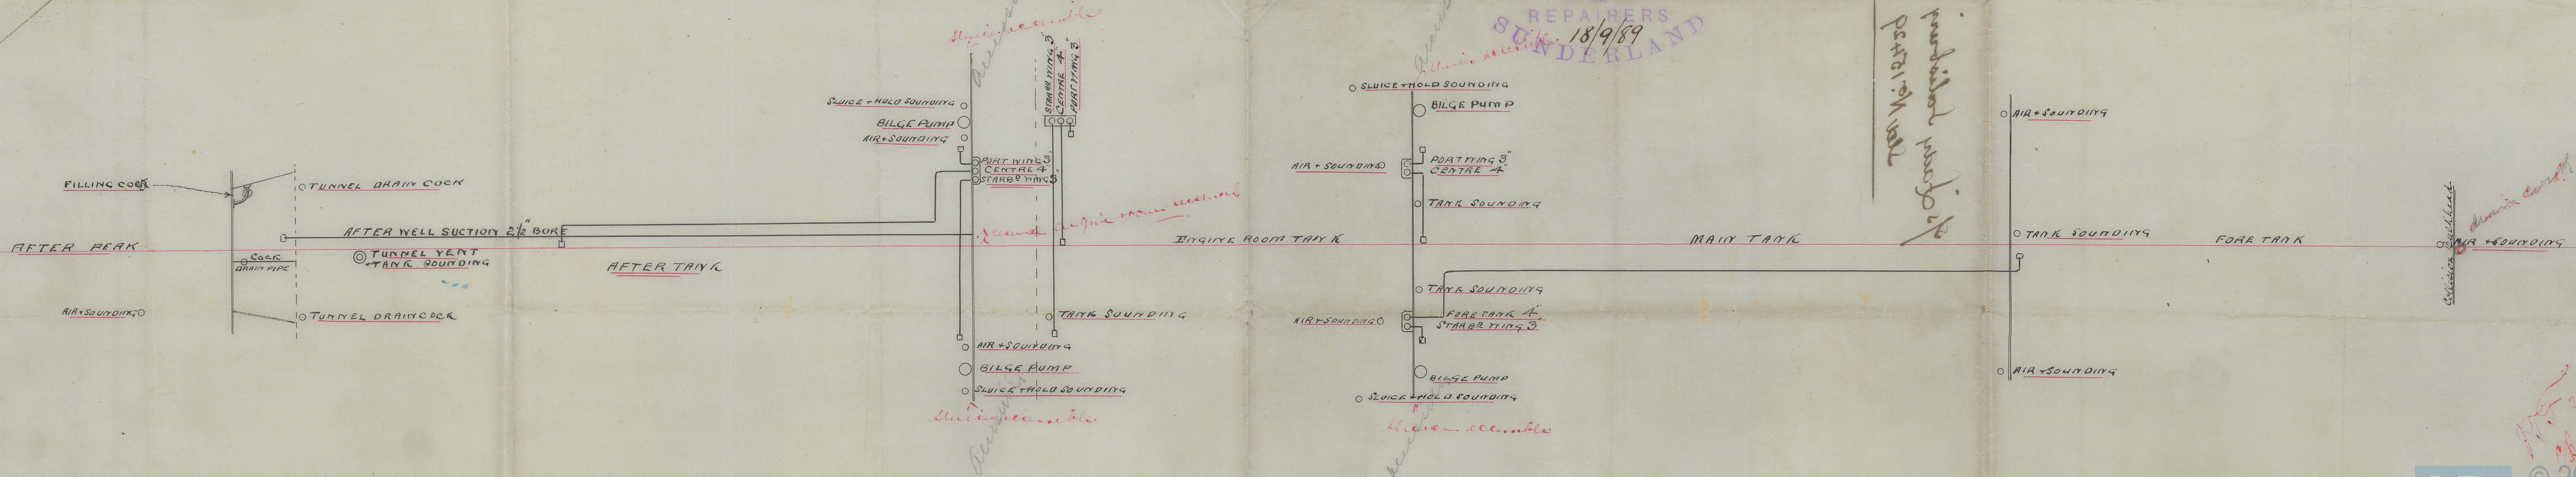

N.A.
25.9.89


SLD968-0200

Ms Lady Salisbury
Slid No 15429

SHORT NAME

RECEIVED
18/8/81
LLOYD'S REGISTER
LONDON

1800










© 2021

Lloyd's Register
Foundation