


"Lady Salisbury" Sunderland 15429

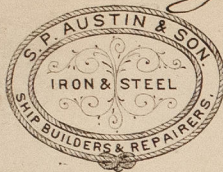

All communications to be addressed to the FIRM.

Wear Dock Yard,
Sunderland, Sept 10th 1889.

AGENTS FOR
MUNTZ'S METAL COMPANY, LIMITED.
Graving Dock 500 feet long

Telegrams 'Austin' Sunderland
ENCLOSURES.

Messrs Loyds Surveyors.

Dear Sirs


Annexed please find lengths
& particulars of Fore & Mainmasts for our
S. S. 167. We shall be glad to learn as
early as possible if the same meets with
your approval

P. P. S. P. Austin Son.
[Signature]


SLD968-0202

S. S. 167. ^{S/S Lady Salisbury} SUNDERLAND.
No. 15429

Foremast.

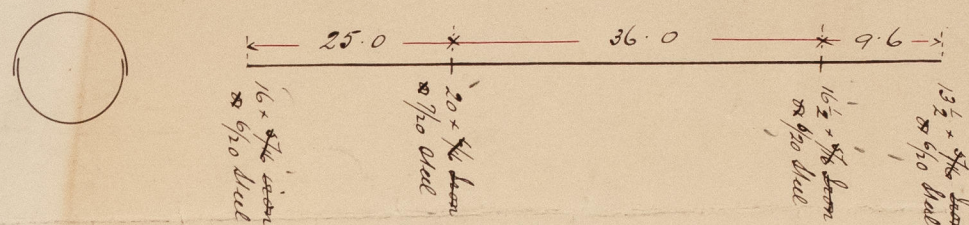

Mainmast

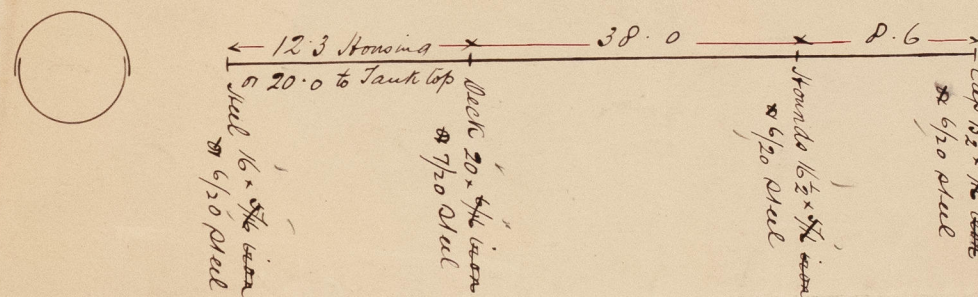

Schooner Rigged. may have Lards on Foremast
with ~~4~~ 7/10 planks.
Masts doubled at Deck, steel
Butts lapped & riveted according to Rule.
Seams single Riveted