



Sp Lady Salisbury
Sid No 15429

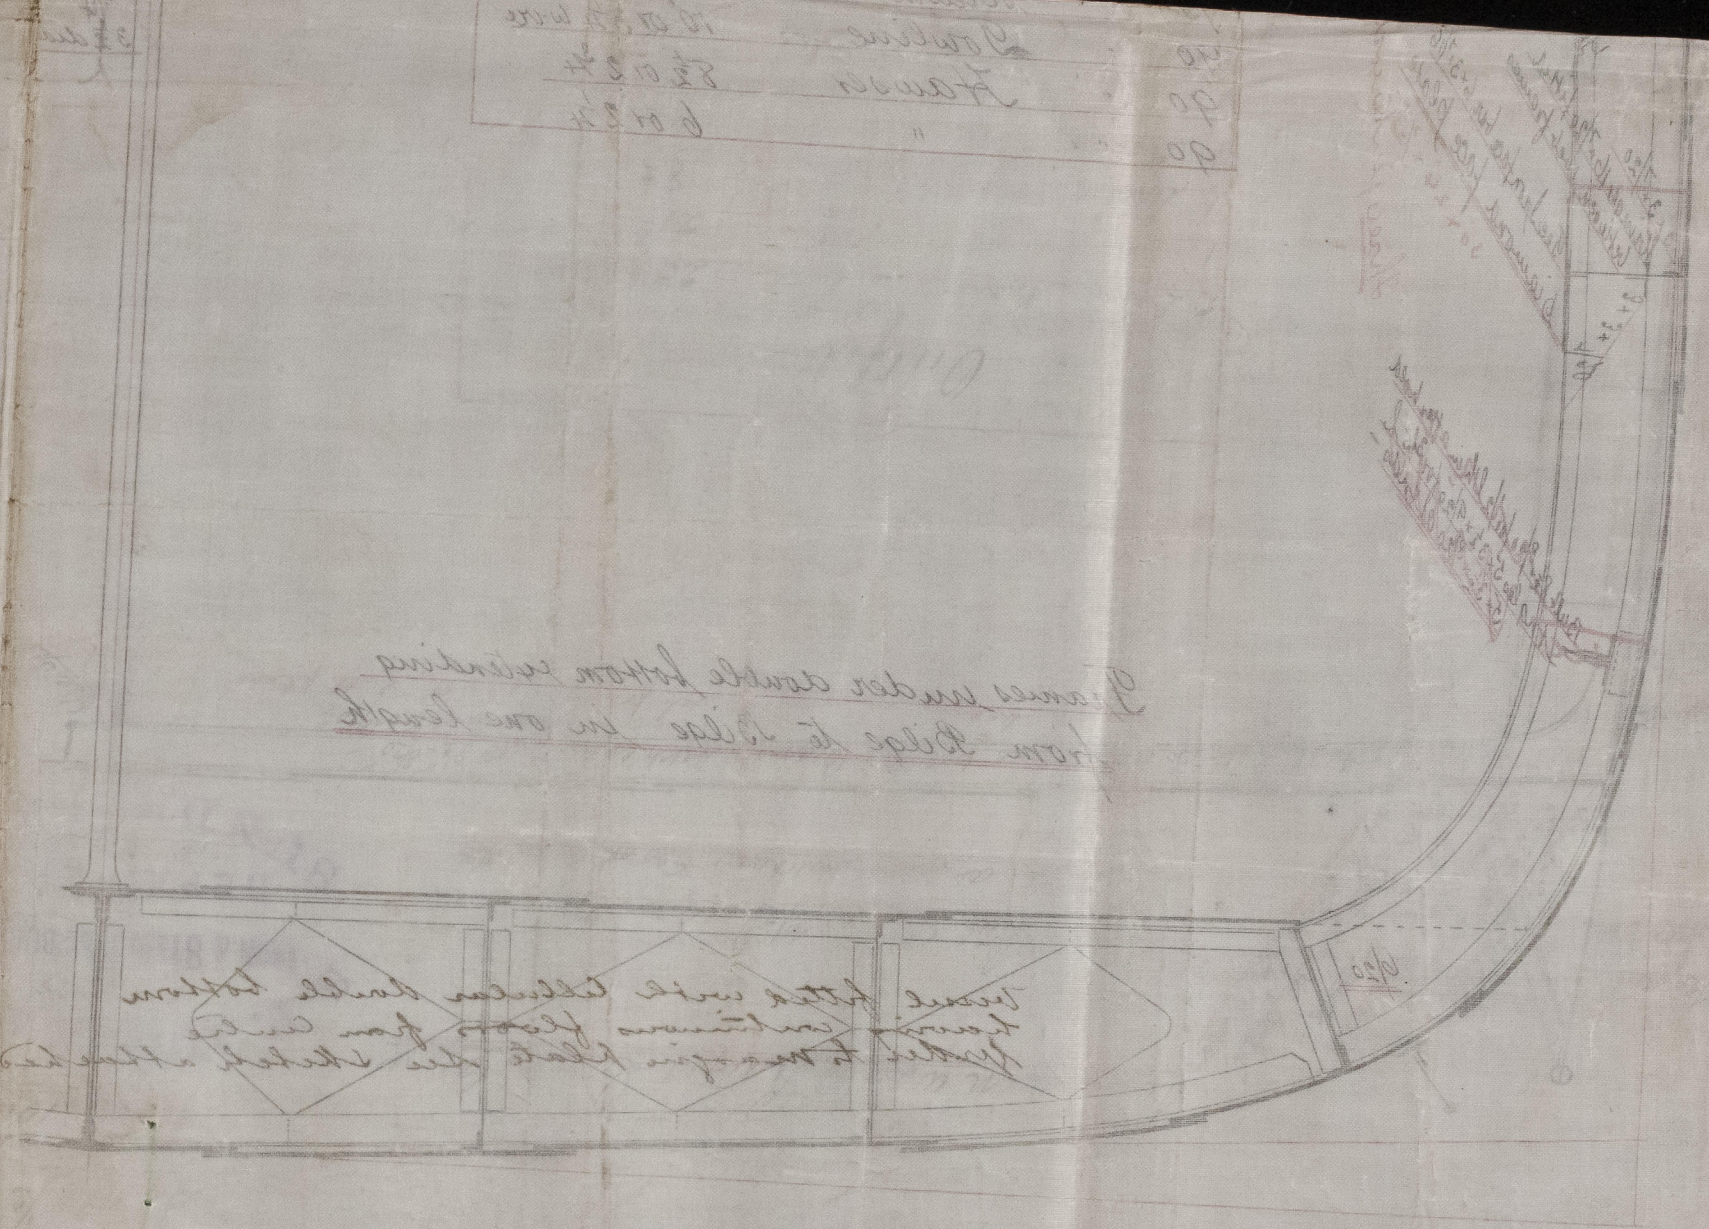

RECEIVED
 14 NOV. 83
 LLOYD'S REGISTER OF SHIPPING
 LONDON

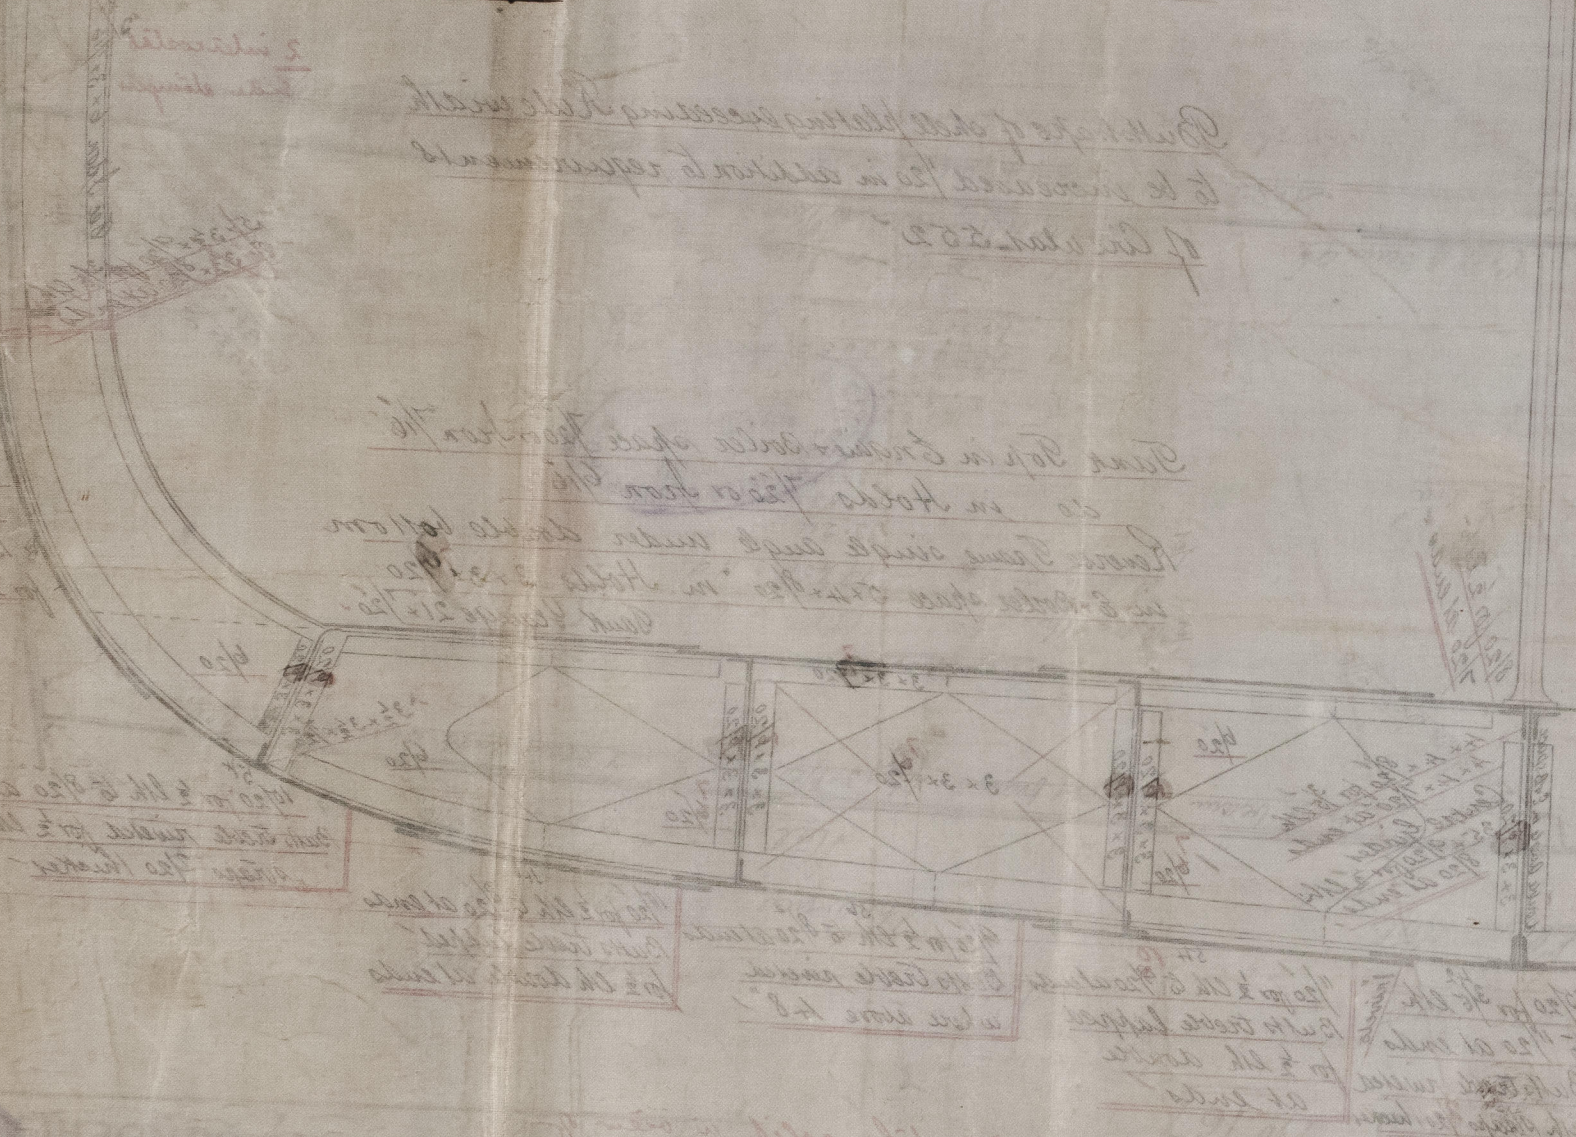

© 2021
 Lloyd's Register
 Foundation