


PLAN OF DECKS No 194 SHIP

Sea King Sla No. 1542/8

SCALE 1/8 INCH = ONE FOOT

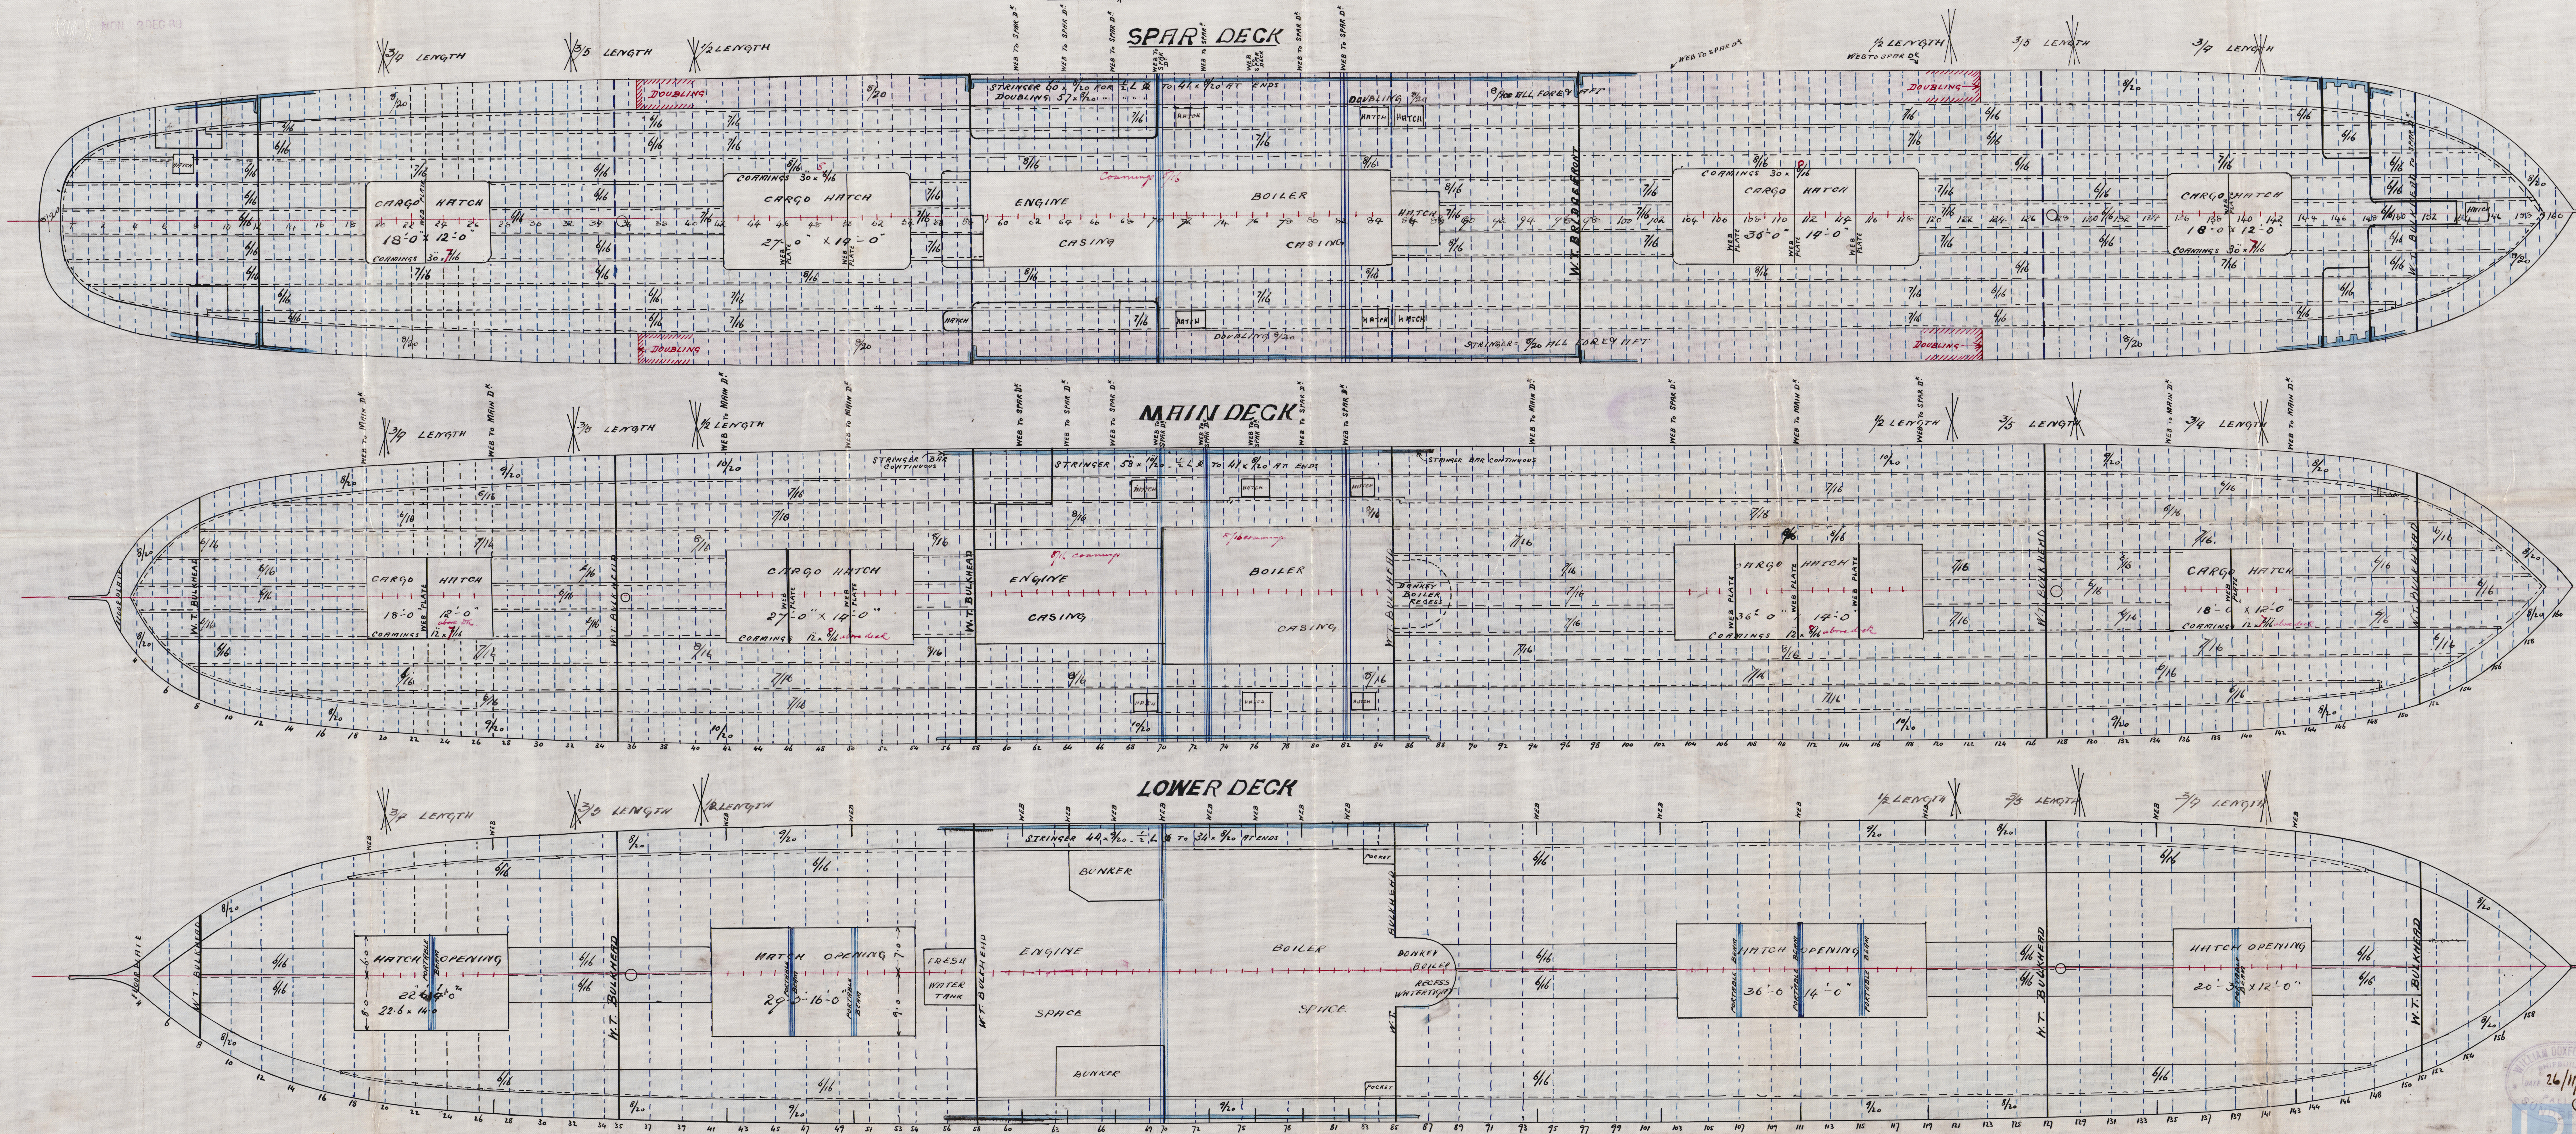

s/s Sea King
Sld. No. 1544/8

SLD969-0052



© 2020

Lloyd's Register
Foundation