

S.S. No 86 and 87


"Oculus"

MIDSHIP SECTION

Length B.P. 215-0
Beam extreme 28-0
Depth to Lloyd's floor 12-9
Cellular bottom 11-2 1/2

Class 100 A.1. Awning Deck

Scale 1/2" = 1 foot

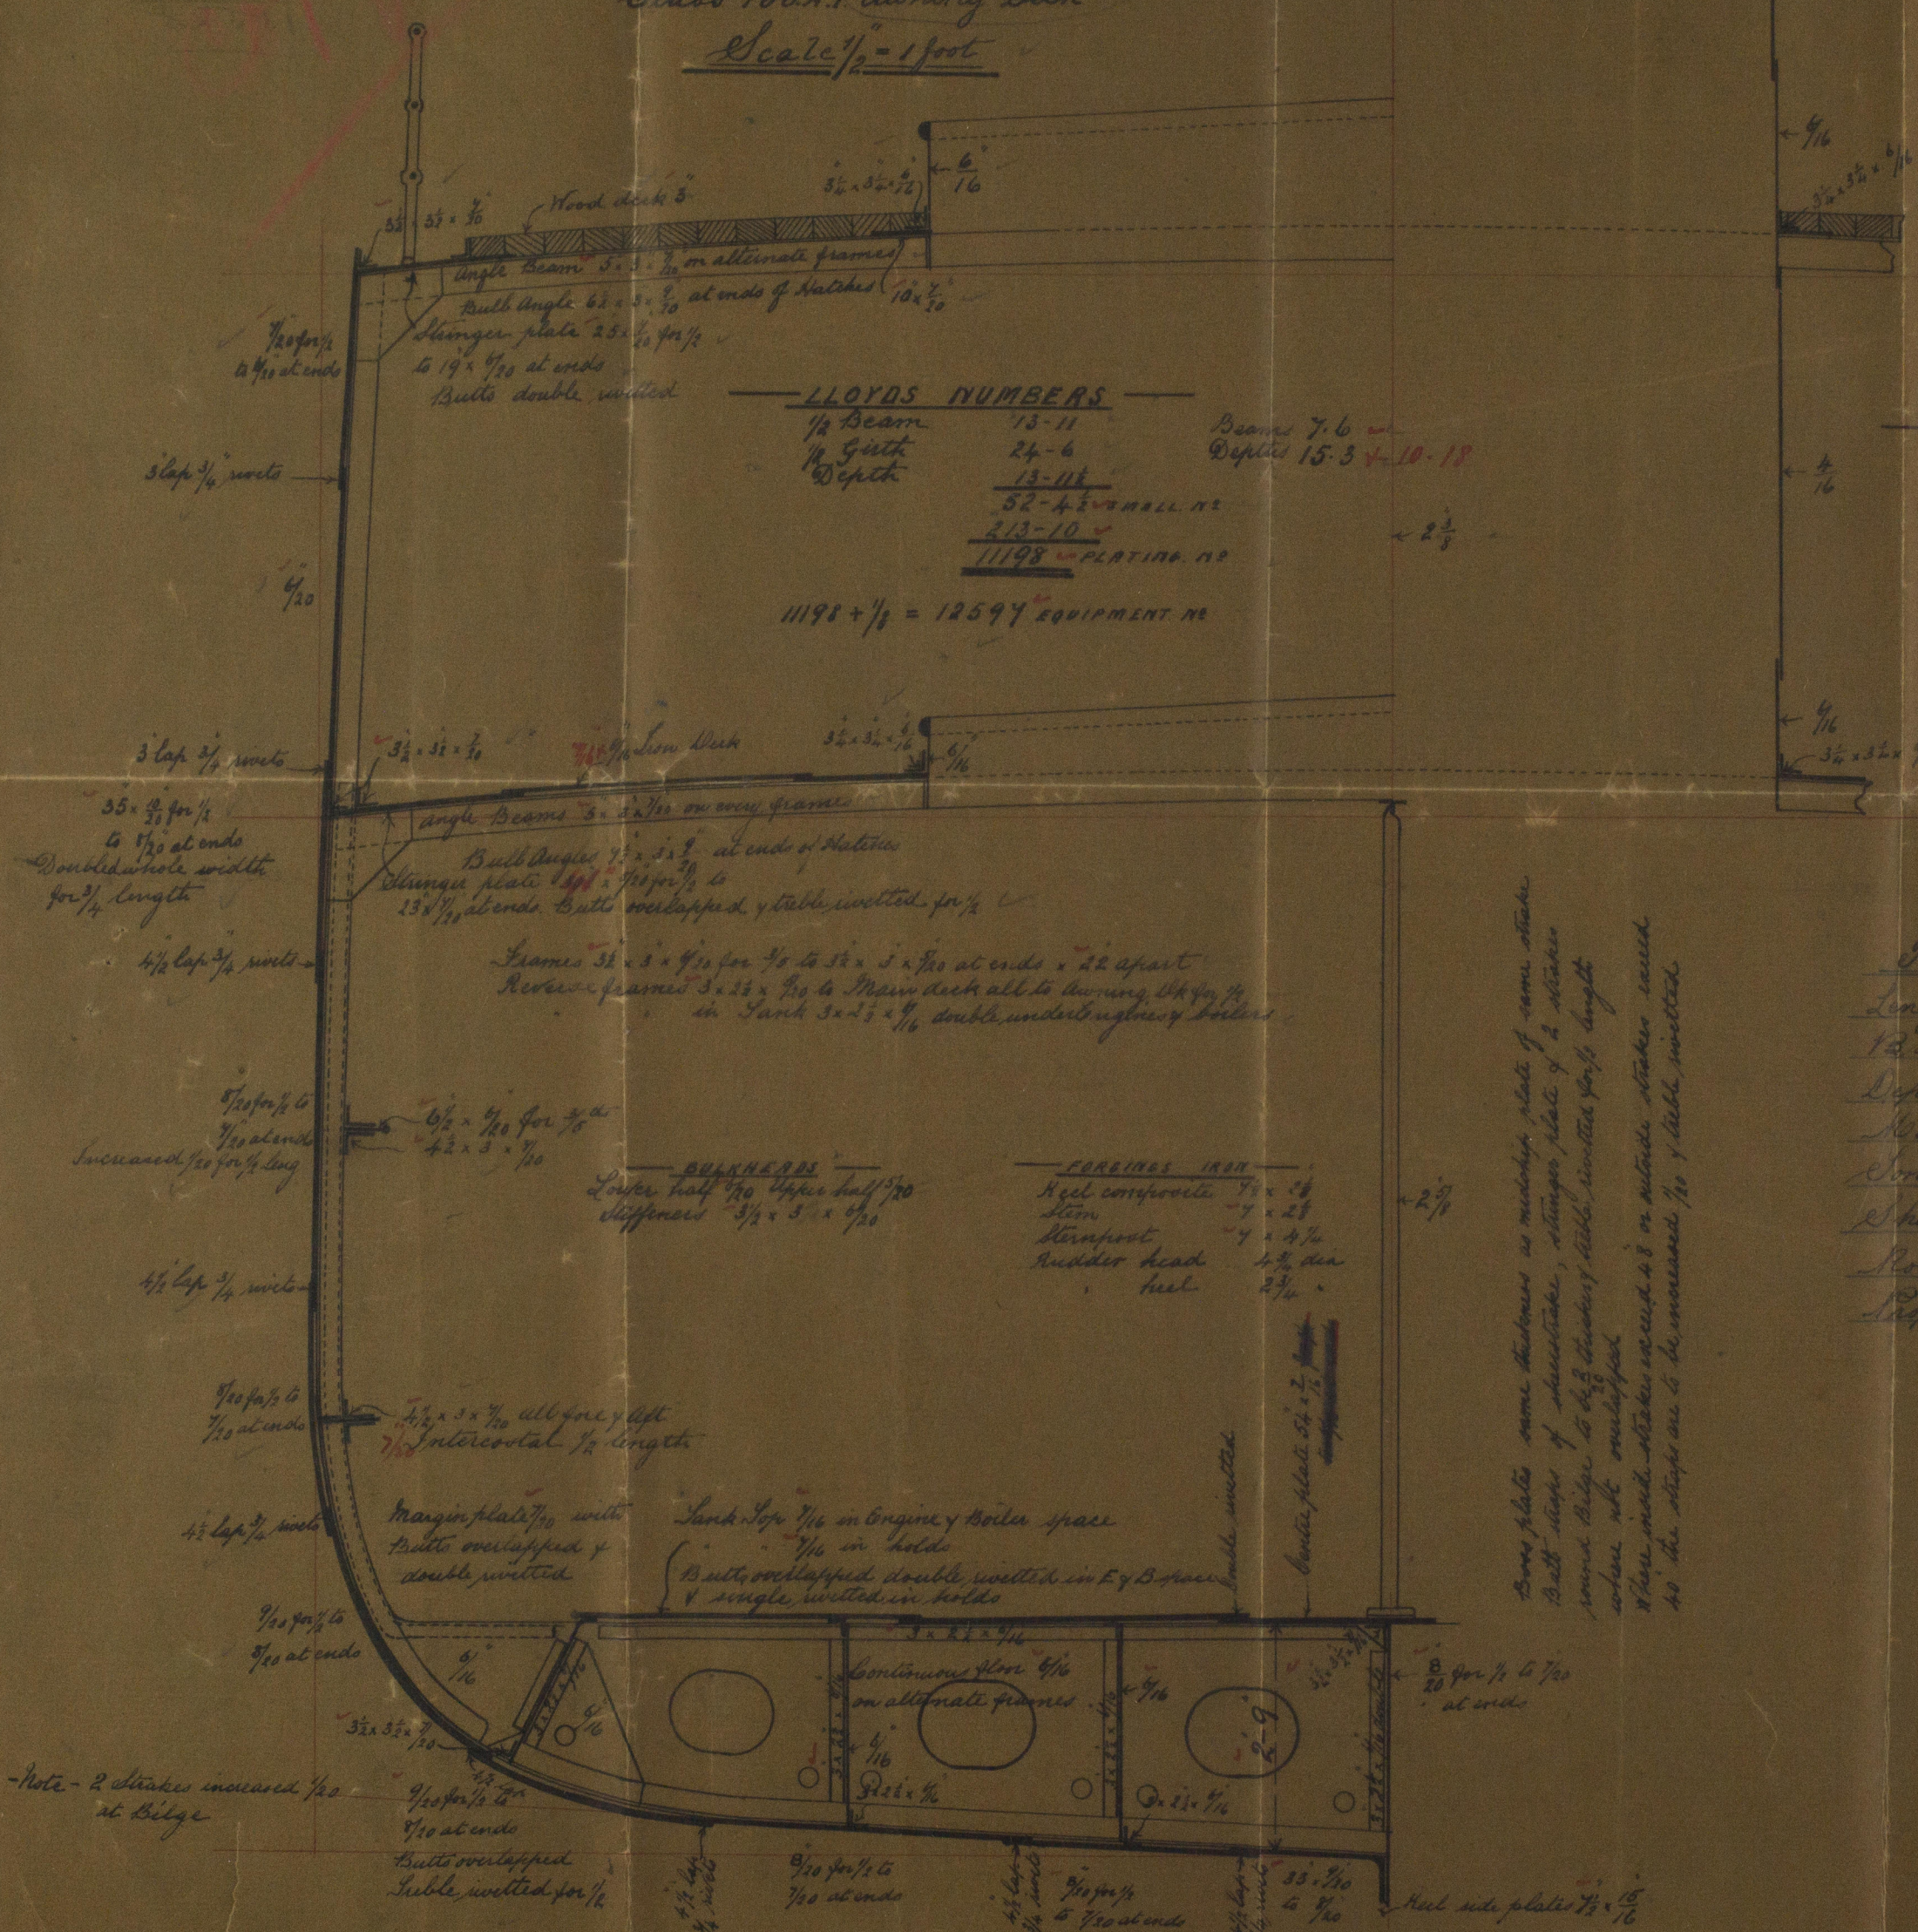

LLOYD'S NUMBERS
1/2 Beam 13-11
1/2 Girth 24-6
Depth 13-11 1/2
52-4 1/2 x 11 1/2
213-10
11198 PLATING NO.
11198 + 1/8 = 12594 EQUIPMENT NO.

MONKEY FORECASTLE
Beams 4 x 3 x 1/4 on alternate frames
Shell 1/4
Stringer 18 x 1/4

Particulars of Freeboard
Length on load line 214-5
Breadth Extreme 28-0 1/5
Depth (Registered) 11-2
Moulded Depth 13-5
Sonnage under deck 485 (861)
Clear Forward 5-0 aft 2-0
Round of Beam 62
Proposed Freeboard Winter 1-3
Summer 1-1

Beams plates same thickness as midship plate of same strake
Bull plates of same thickness, stringer plate of 2 strakes
same plates as the 3 strakes, ribs, riveted for 1/4 length
where not overlapped
When inside strakes are up 1/8 or outside strakes raised
so the strakes are to be increased 1/8, 1/16, riveted

Note - 2 strakes increased 1/8 at Bilge

"Okus"
Yard No 87

Strand Shipping
Company
Limited

Sunderland

15528

520969-0262



© 2020

Lloyd's Register
Foundation