


Scale  $\frac{1}{8}" = 1$  Foot

James Laing  
Dixford Yards  
Sunderland

SL0973-0056






SLD973 - 6056

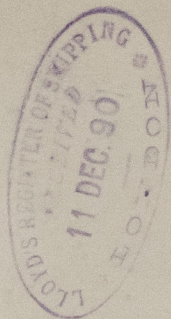

*Wm. Laming's S.S. No. 506*


*Profile app. with amendments  
28/4/90*

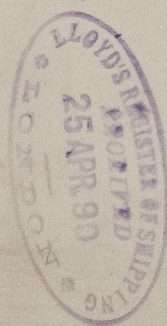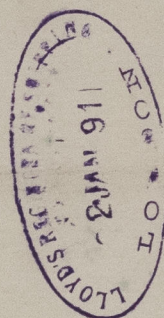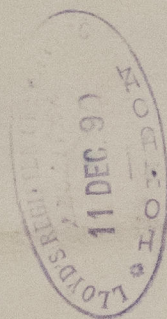

© 2021

Lloyd's Register  
Foundation



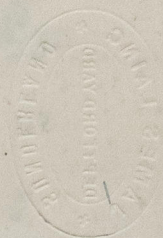

0056

"Almona"  
Sld. 15875

thru



© 2021

Lloyd's Register  
Foundation