
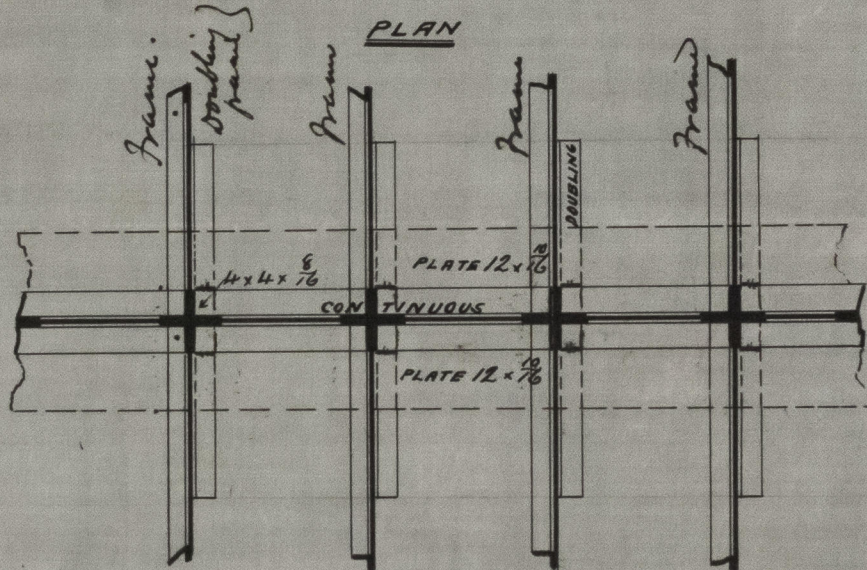


S. S. N° 506  
 Scale 1/2 in = One Foot.


May 7.  
 1890.

SAT 10 MAY 9.

ELEVATION.

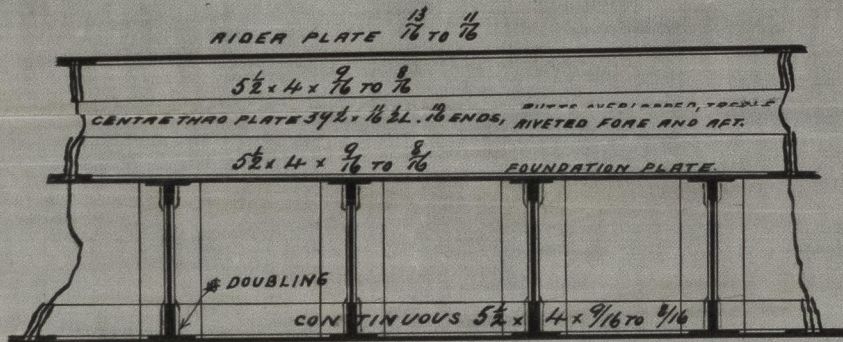

SECTION

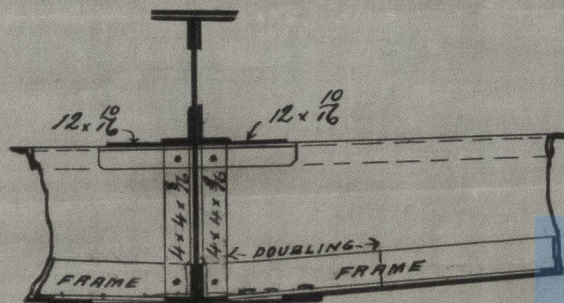

© 2021 Lloyd's Register Foundation  
 9/5/90 SKD 973-0057