




TUE 13 MAY 27



S.S.N°506
AFTER TANK
SCALE 1/4"=ONE FOOT

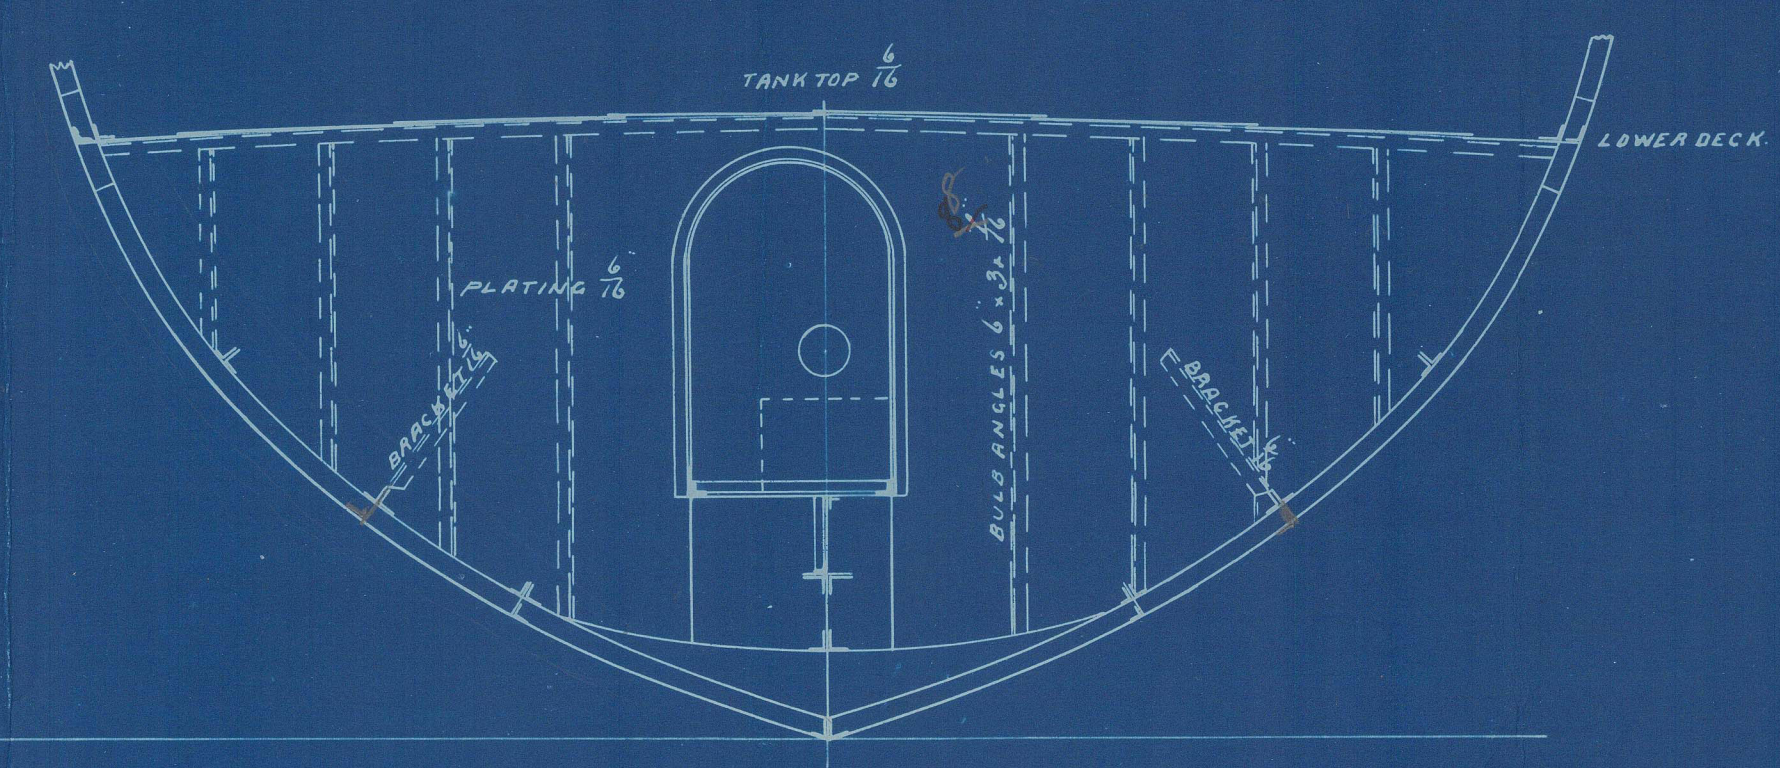

SECTION AT FRAME 23
LOOKING AFT

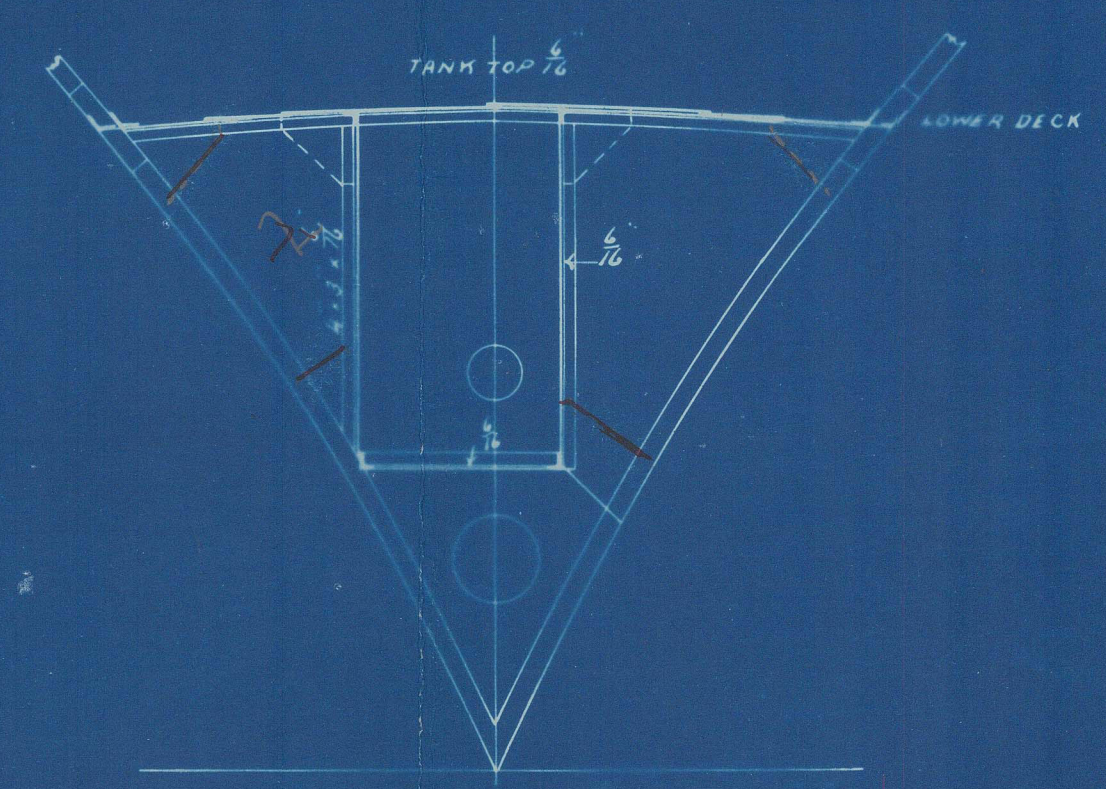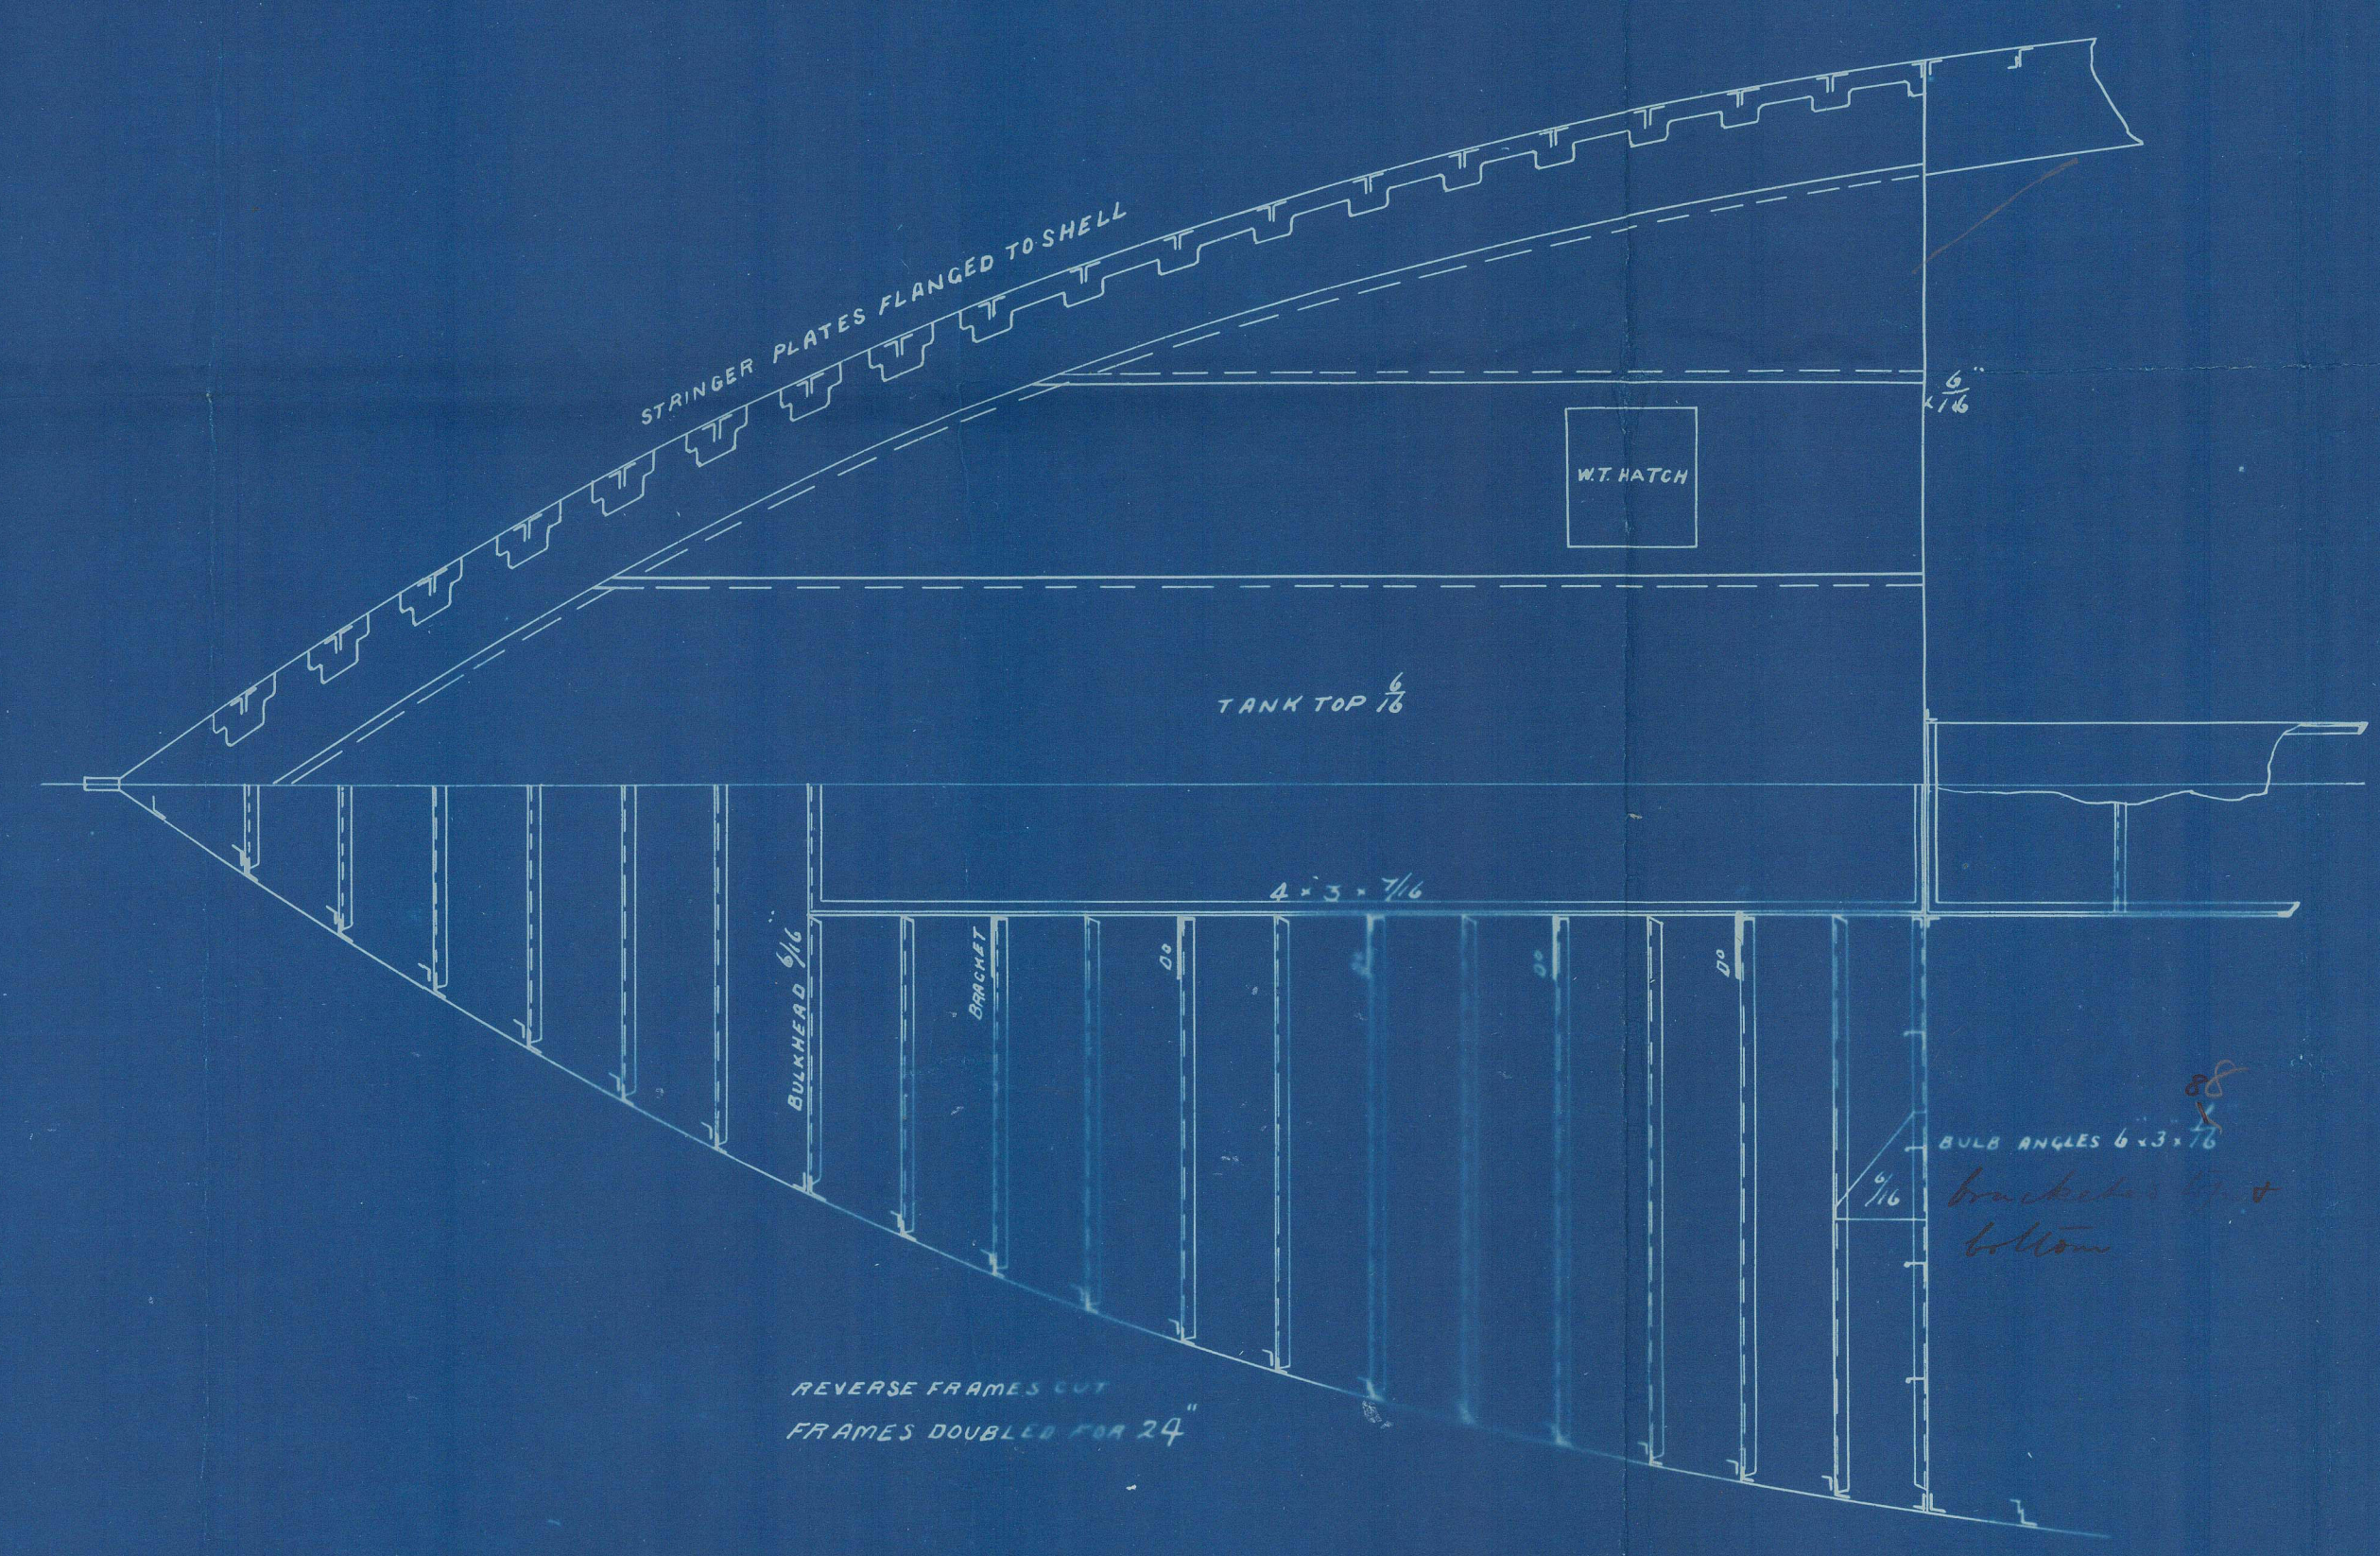

SECTION AT FRAME 11
LOOKING AFT

SLD 973-6059

St. Umona

SL 76° 15845.

Mr. J. Lamps

20. No 506

after Dec Tank



© 2021

Lloyd's Register
Foundation