

Lloyd's Register of British and Foreign Shipping.

(Report on Vessel No. _____ Port _____)

Sund

No. 1671A

SHIP FORGINGS OR CASTINGS.

I have to report that the undermentioned Iron or Steel Forgings or Castings, manufactured by

The Sund Forge Co. & Iron Forge Co. of Pallion

for the Vessel No. *508*, being built by *Mr James Raing*

of *Sunderland* have been inspected by me as set forth below, and found

to be, so far as can be seen, *sound*

The words FORGINGS or CASTINGS, IRON or STEEL, should be struck out as may be required.

Mark on Forgings.

Lloyd's
No. 1671A
S.C.


Hugh Cannon

Sunderland

4.10.90
Iron Forge Co.
STEM.

	STERN FRAME.	RUDDER FRAME.	STEM.
Material*	<i>Scrap iron</i>	<i>Scrap iron</i>	<i>Scrap iron</i>
How made	<i>Forged</i>	<i>Forged</i>	<i>Forged</i>
Dimensions	<i>9" x 5 1/2"</i>	<i>7" x 3 1/2"</i>	<i>9" x 2 1/2"</i>
Progress on Inspection	<i>Forged & Limited</i>	<i>Forged Limited</i>	<i>Forged</i>
Dates when Inspected	<i>June 3-6-10-13-21-24</i> <i>July 1-8-10/90</i>	<i>July 25 Aug 2-7-16 Sept 5</i> <i>11-12-25-26/90</i>	<i>July 21/90</i>

SKETCHES OF FRAMES SHEWING POSITION AND DESCRIPTION OF WELDS OF FORGINGS, OR PARTICULARS OF TESTS APPLIED TO CASTINGS.

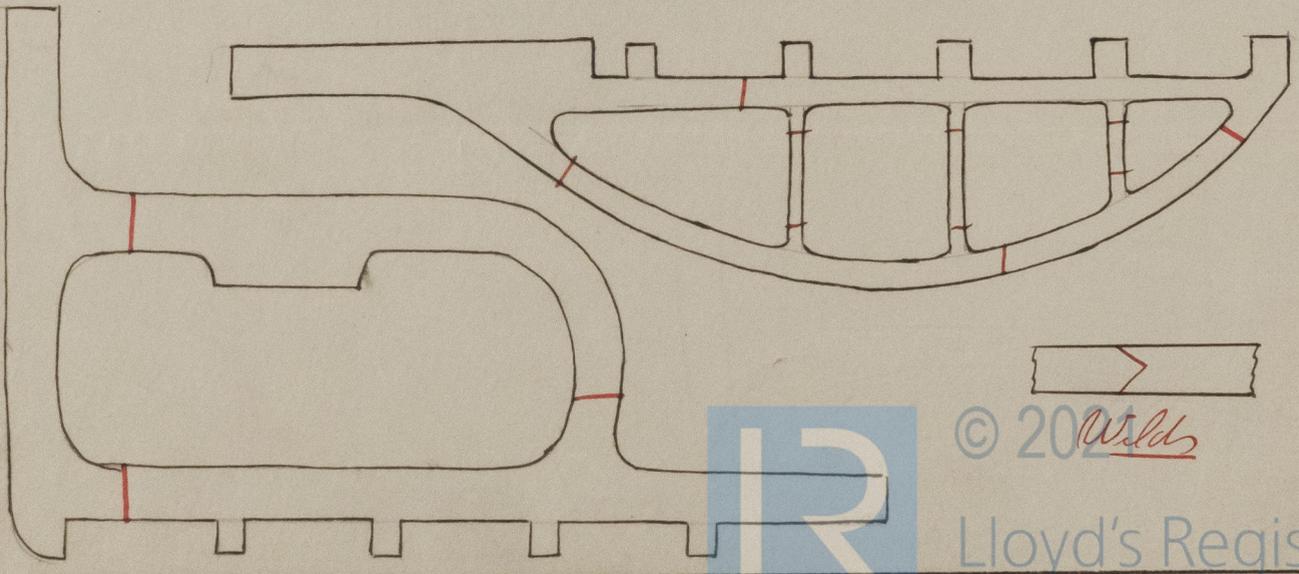

© 2011 *Welds*

Lloyd's Register
Foundation

* If of Iron, state whether scrap or puddled Iron.

Sl. Rept. no 15875

"
S. S. Umona
(J. Laing's no 586)

Forging Certificate



© 2021

Lloyd's Register
Foundation