

Virginia Perano

Received at

Office,

18

Lloyd's Register of British and Foreign Shipping.

(Report on Vessel No. 15752 Port Sed)

Sund

No. 1673a

SHIP FORGINGS OR CASTINGS.

The words FORGINGS or CASTINGS, IRON or STEEL, should be struck out as may be required.

I have to report that the undermentioned Iron or ~~Steel~~ Forgings or Castings, manufactured by the North Quay Forge Co. of Sunduland for the Vessel No. 102, being built by Messrs John Blumer Co. of Sunduland have been inspected by me as set forth below, and found to be, so far as can be seen, sound.


Mark on Forgings.

Lloyd's
No. 1673a
06.6

Hugh Cameron
Sunduland
25.11.90.

	STERN FRAME.	RUDDER FRAME.	STEM.
Material*	<u>Scrap iron</u>	<u>Scrap iron</u>	<u>Scrap iron</u>
How made	<u>Forged</u>	<u>Forged</u>	<u>Forged</u>
Dimensions	<u>9' x 5 1/2"</u>	<u>7 1/4" - 3 1/2"</u>	<u>9' x 2 1/2"</u>
Progress on Inspection	<u>Forged & Smithed</u>	<u>Forged & Smithed</u>	<u>Forged</u>
Dates when Inspected	<u>July 8-12-24-31 Aug 7-18</u> <u>23-27 Sept 11-20-24 Oct 2-14-30/90</u>	<u>Sept 25 Oct 2-14-30 Nov 11/90</u>	<u>Nov 11/90</u>

SKETCHES OF FRAMES SHEWING POSITION AND DESCRIPTION OF WELDS OF FORGINGS, OR PARTICULARS OF TESTS APPLIED TO CASTINGS.

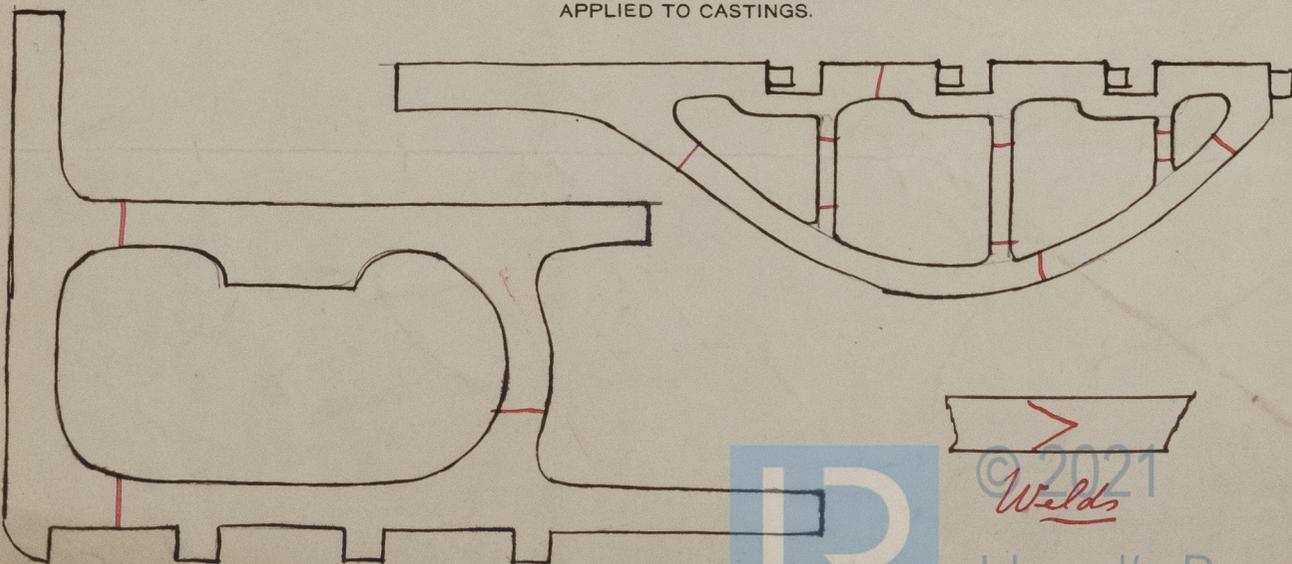

Welds



Lloyd's Register
Foundation

* If of Iron, state whether scrap or puddled Iron.

1673