

# S.S. N<sup>os</sup> 102 *Part covering deck & vessel C.P. & 'B'*

## MIDSHIP SECTION

LENGTH B.P. ... 275.0  
BREADTH EXTREME 38.0  
DEPTH TO TANK 18.0

CLASS 100A1 STEEL RAISED QUARTERS

*1<sup>st</sup> No 2<sup>nd</sup> No 3<sup>rd</sup> No 23865*  
 $\frac{1}{2}$  BIRTH 36.0 +  $\frac{1}{2}$  BEAM 18.90 + DEPTH 21.04 = 75.94 x 273.5 = 20769.59. 23158.08.  
DEPTH TO LENGTH 12.9 BREADTH TO LENGTH 7.2

SCALE  $\frac{1}{2}$  INCH = 1 FOOT.


### RAISED DECK.

### BRIDGE DECK

### MAIN DECK.


#### EQUIPMENT

#### FREE BOARD

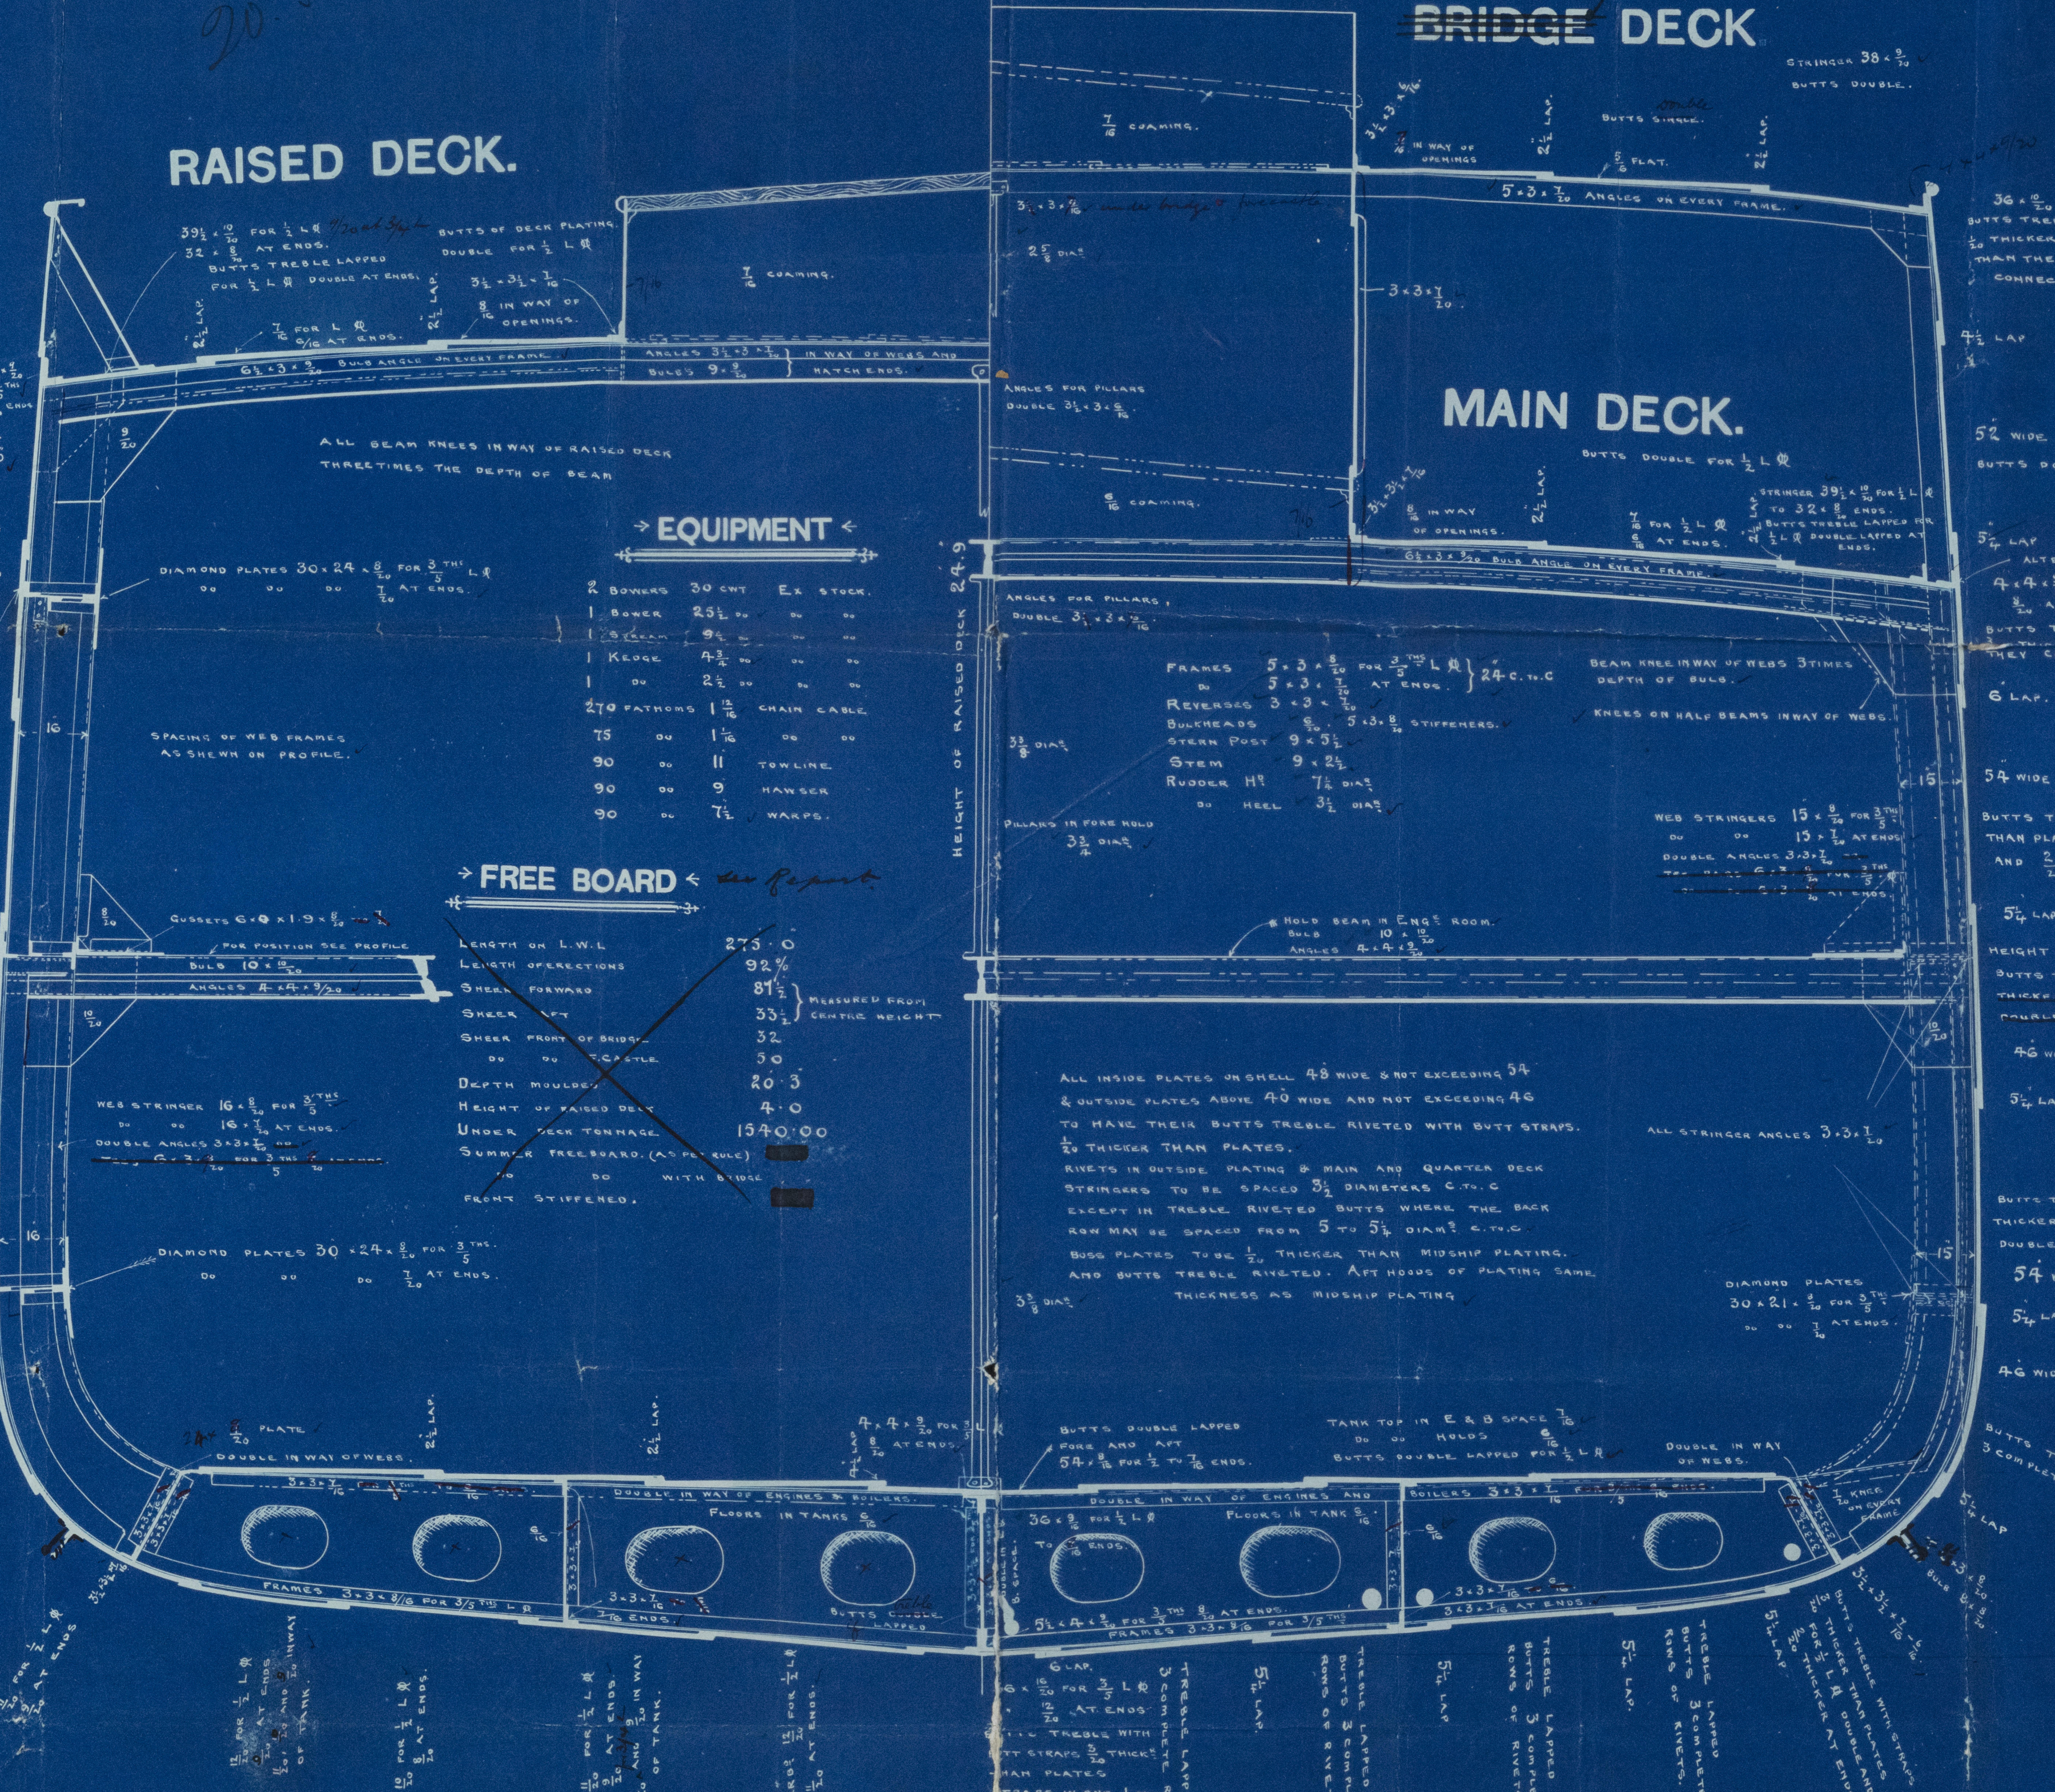

JOHN BLUMER & CO  
SHIPBUILDERS,  
(NORTH DOCK)  
SUNDERLAND  
1890




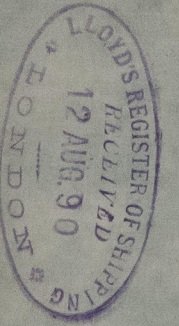

Messrs J. Blumenthal & Co.

A.S. No. 102

Midships section.

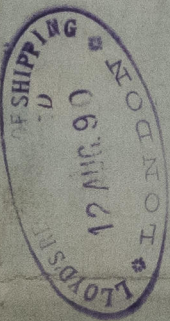

5LD976-0192



© 2021

Lloyd's Register  
Foundation



*St Virginia Perano*  
*Sld Report P. 16182*



© 2021

Lloyd's Register  
Foundation