


Lpr 26.9.90

— S.S.102 —

— PUMPING PLAN —
— SCALE $\frac{1}{8}$ " = 1 FOOT —

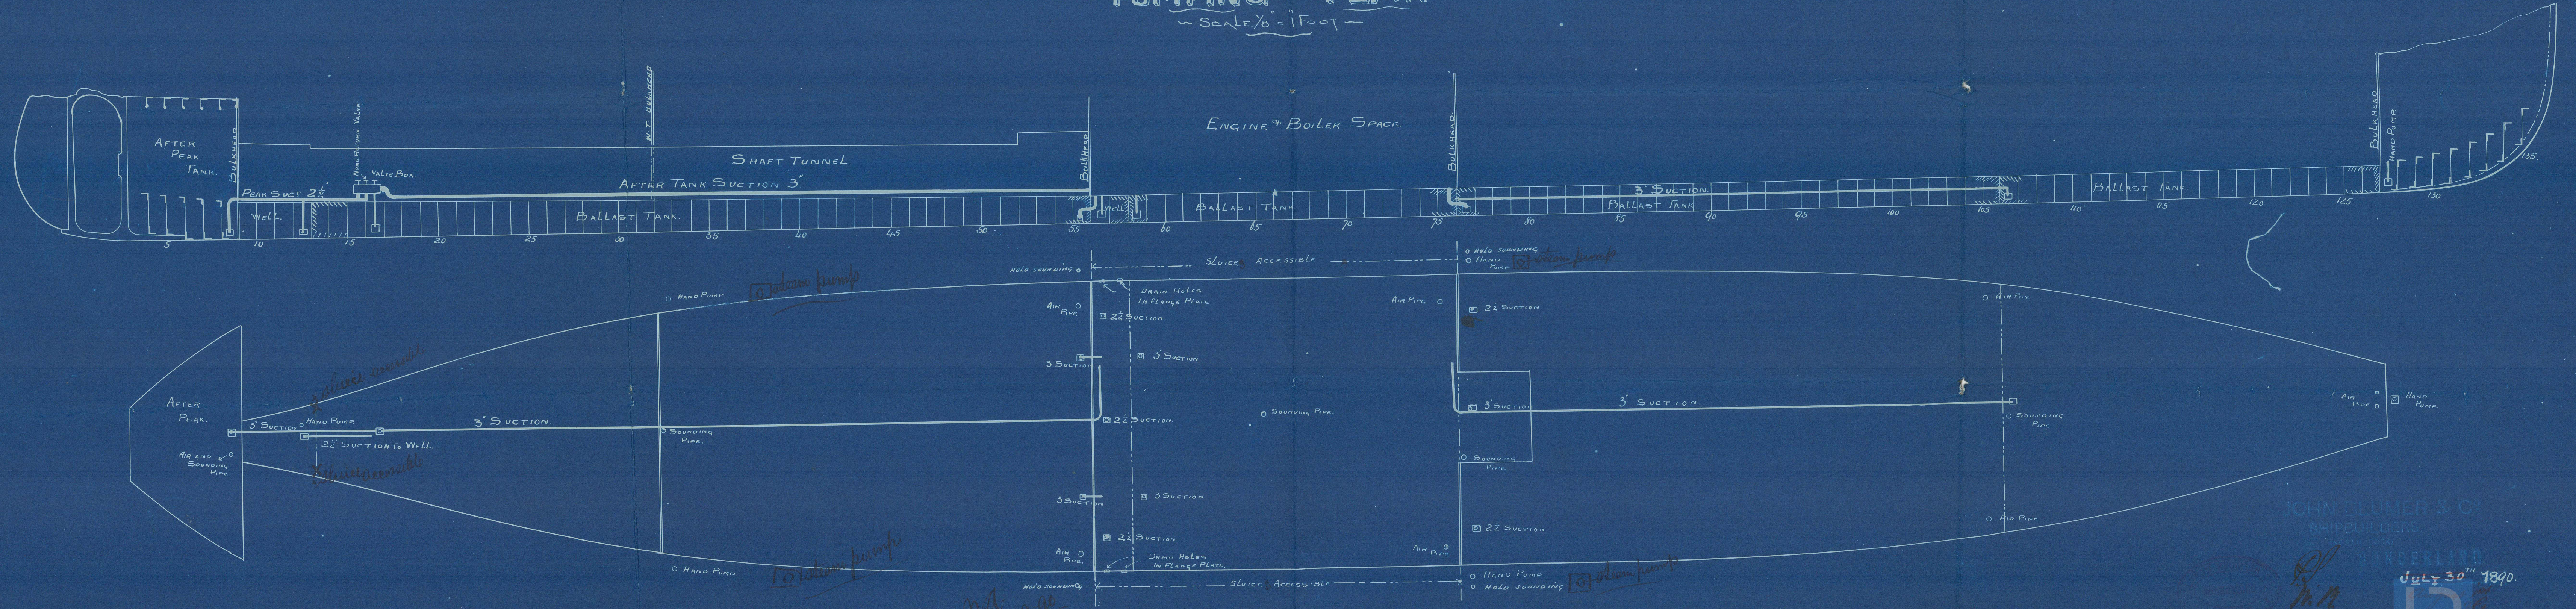

JOHN BLUMER & CO

SHIPBUILDERS


UNDERLAND

JULY 30th 1890.

J.D.

10 steam pump

sluice accessible

10 steam pump

sluice accessible

10 steam pump

sluice accessible

10 steam pump

sluice accessible

J Blumer & Co

No 102

Pumping Plan

Virginia Seirano

Sld 16152



© 2021

Lloyd's Register
Foundation

SLD 976-0196