
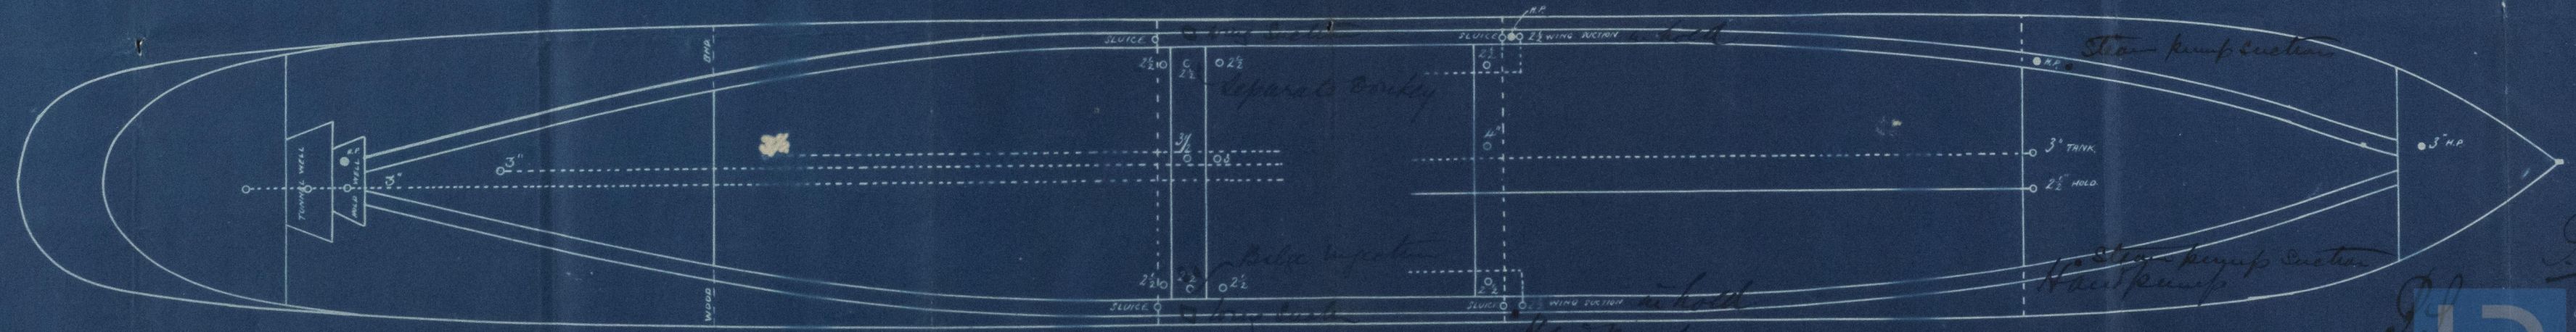


*Ltr. to Hld. 17.10.91*

S. S. N<sup>o</sup> 514, 515 & 516.

SCALE 1/16 INCH = ONE FOOT.

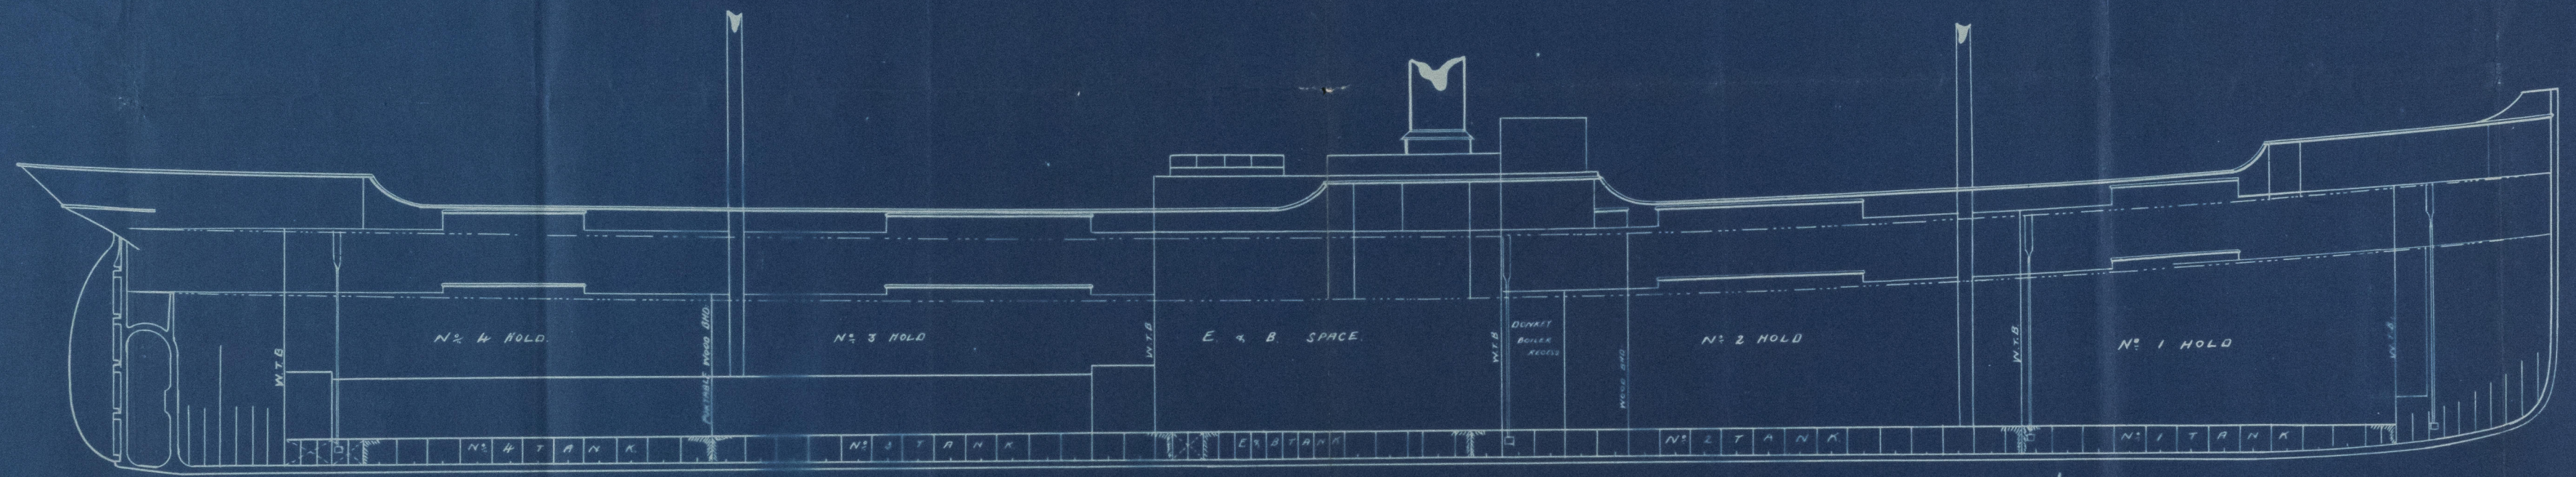








SL0980-0193

S. Lamps 514-15-16  
Approved Pumping  
Plan

S.S. "BASUTO"  
REPORT N<sup>o</sup> 16514

S.S. "BLOEMFONTEIN"  
- REPORT N<sup>o</sup> 16561 -



© 2021

Lloyd's Register  
Foundation