

Lloyd's Register of British and Foreign Shipping.

(Report on Vessel No. 16531. Port SUNDERLAND.)Sunder
No. 2158a

SHIP FORGINGS OR CASTINGS.

I have to report that the undermentioned Iron or Steel Forgings or Castings, manufactured by

The Sunderland Forge Co. of Pallion
for the Vessel No. 174, being built by Messrs R Thompson Sons
of Sunderland have been inspected by me as set forth below, and found
to be, so far as can be seen, sound.

Mark on Forgings.


Lloyd's

No. 2158a
Co.

Wm J Cannon
Sunderland
16. 2. 92

	STERN FRAME.	RUDDER FRAME.	STEM.
Material*	<u>Scrap iron</u>	<u>Scrap iron</u>	
How made	<u>Forged</u>	<u>Forged</u>	
Dimensions	<u>10' x 6"</u>	<u>7 3/4' - 3 3/4"</u>	
Progress on Inspection	<u>Smithed</u>	<u>Forged Smithed</u>	
Dates when Inspected	<u>Nov 20 Dec 7/91</u>	<u>Jan 13 Feb 6/92</u>	

SKETCHES OF FRAMES SHEWING POSITION AND DESCRIPTION OF WELDS OF FORGINGS, OR PARTICULARS OF TESTS APPLIED TO CASTINGS.

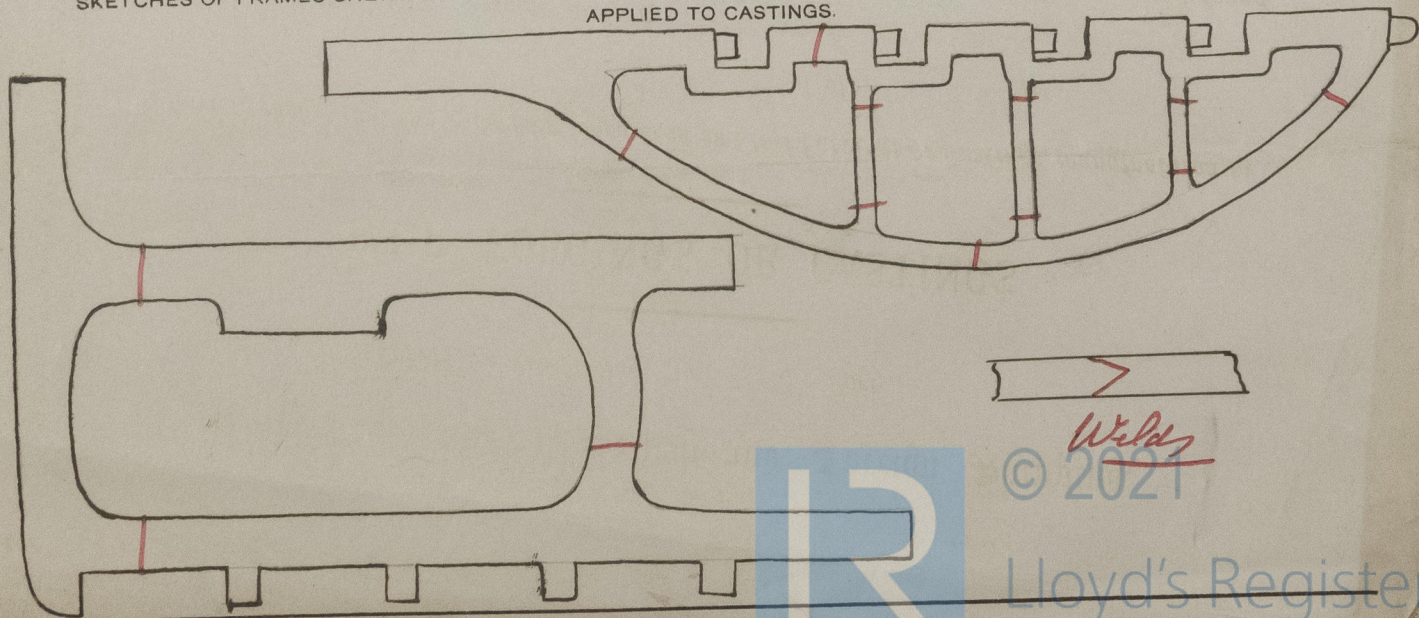

* If of Iron, state whether scrap or puddled Iron.