



171.21
 2-3 ft small
 see letter 10/5/92 22/5/92
 10/5/92

B.H.38

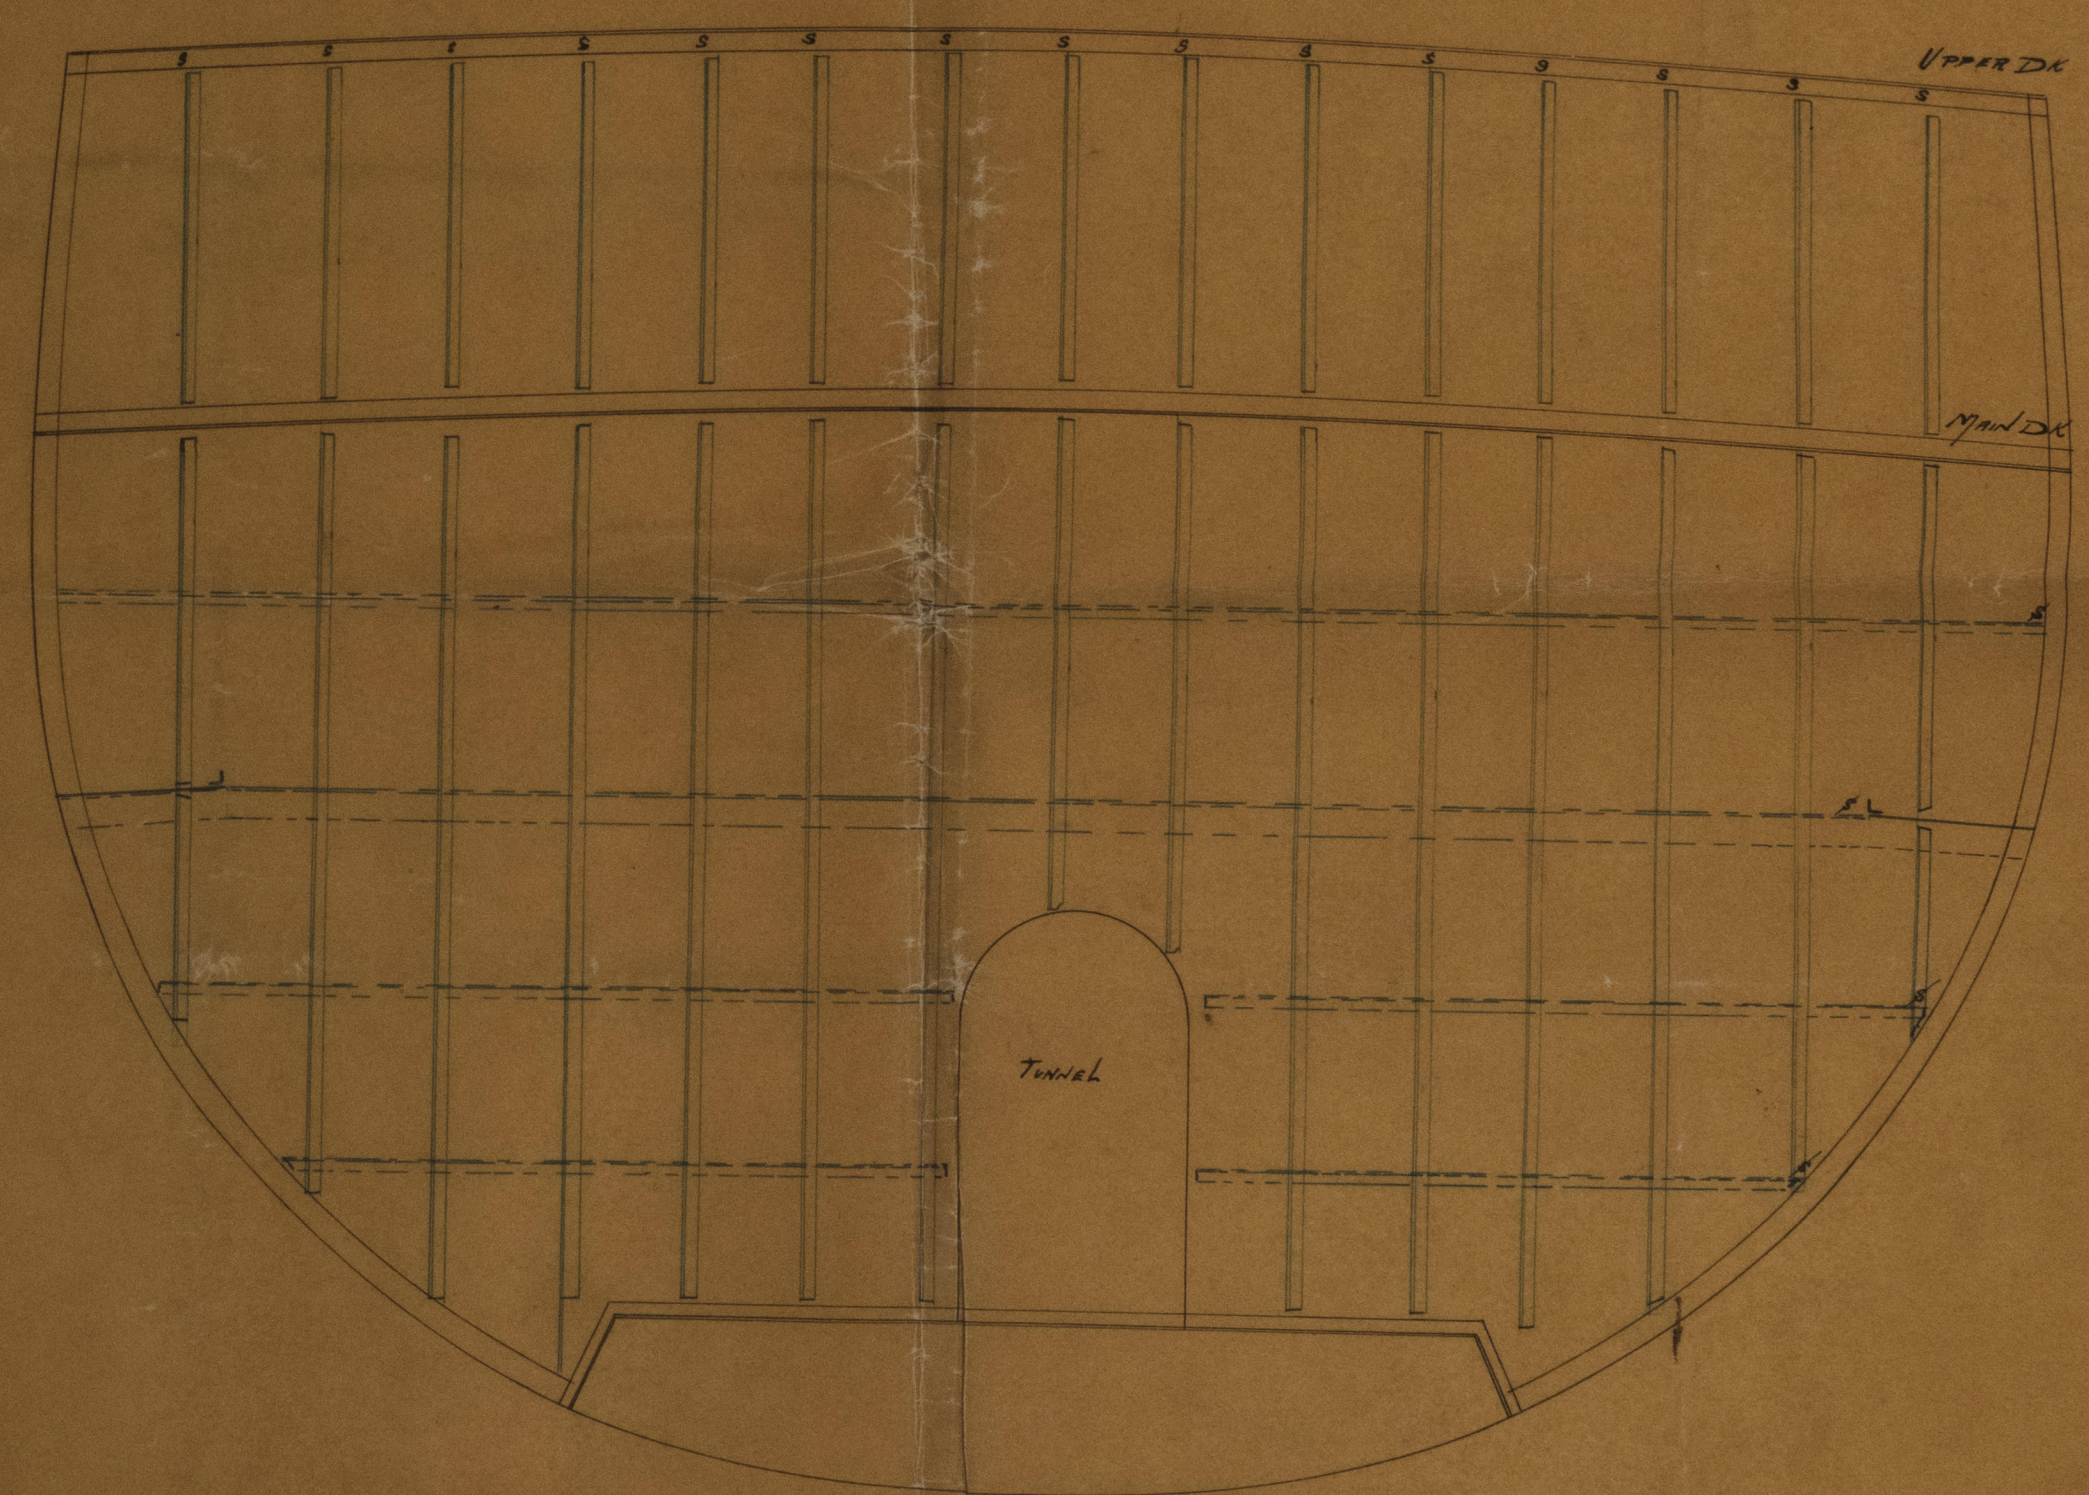


B.H.70.

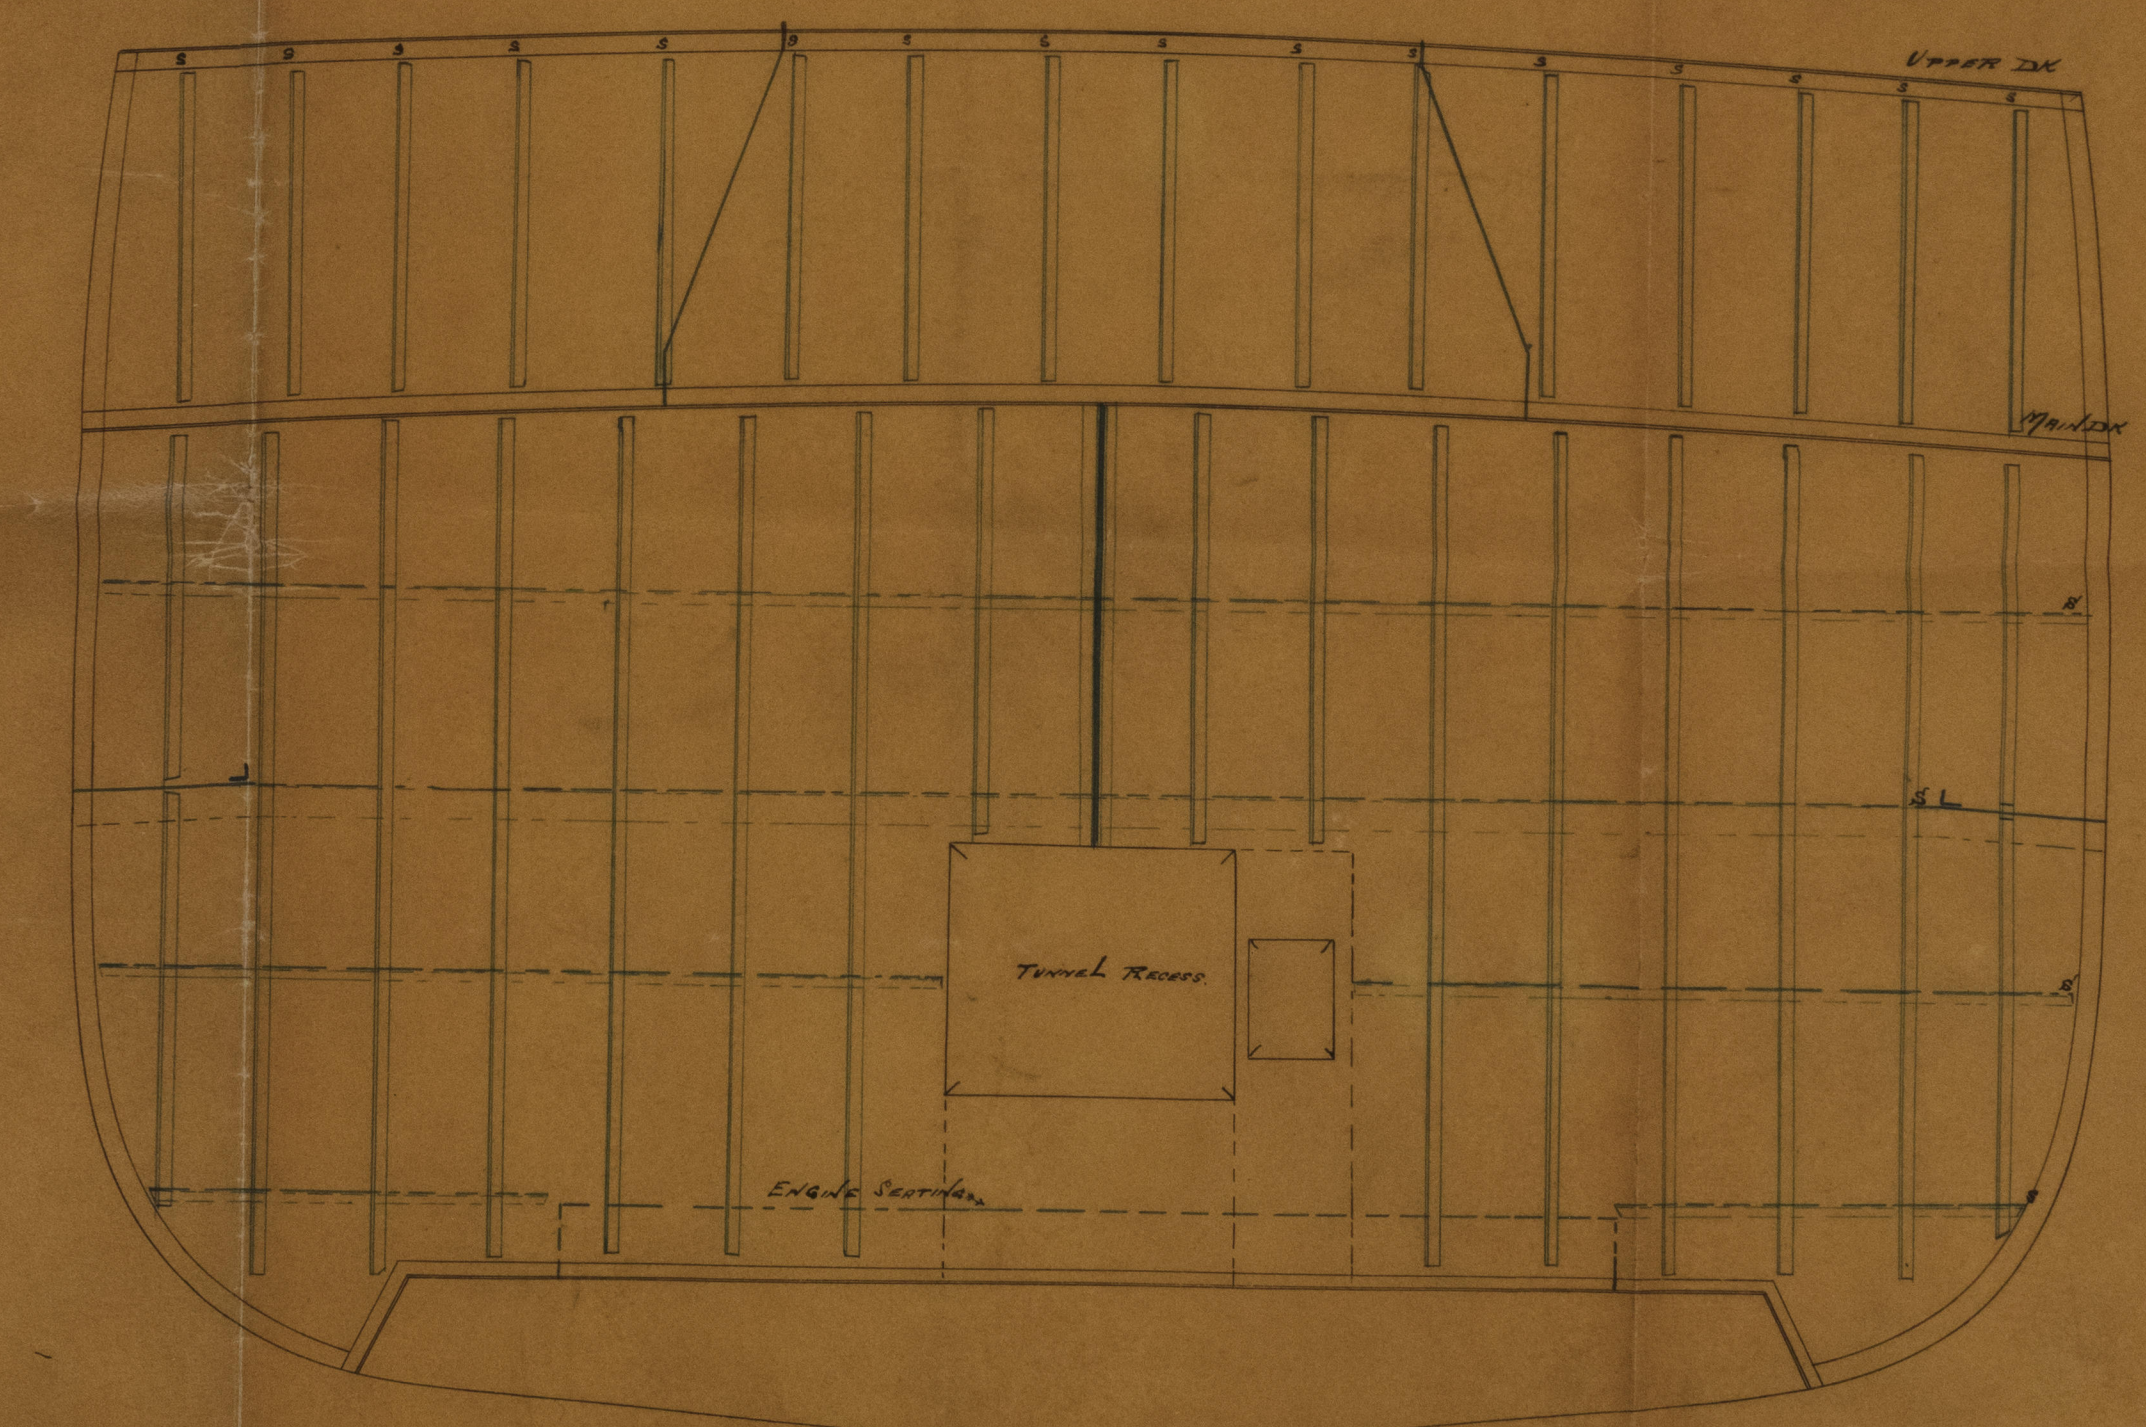


"Harrington"
 Plans Report No. 16646.
 PLAN OF BULKHEADS SHOWING STIFFENING


No 173
 Scale 1/2" = 1'

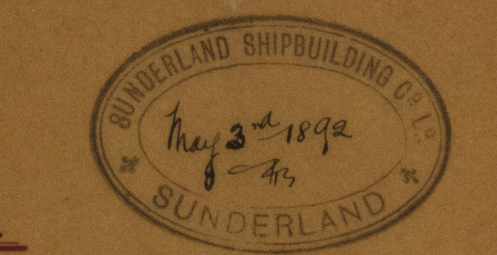


B.H.102.

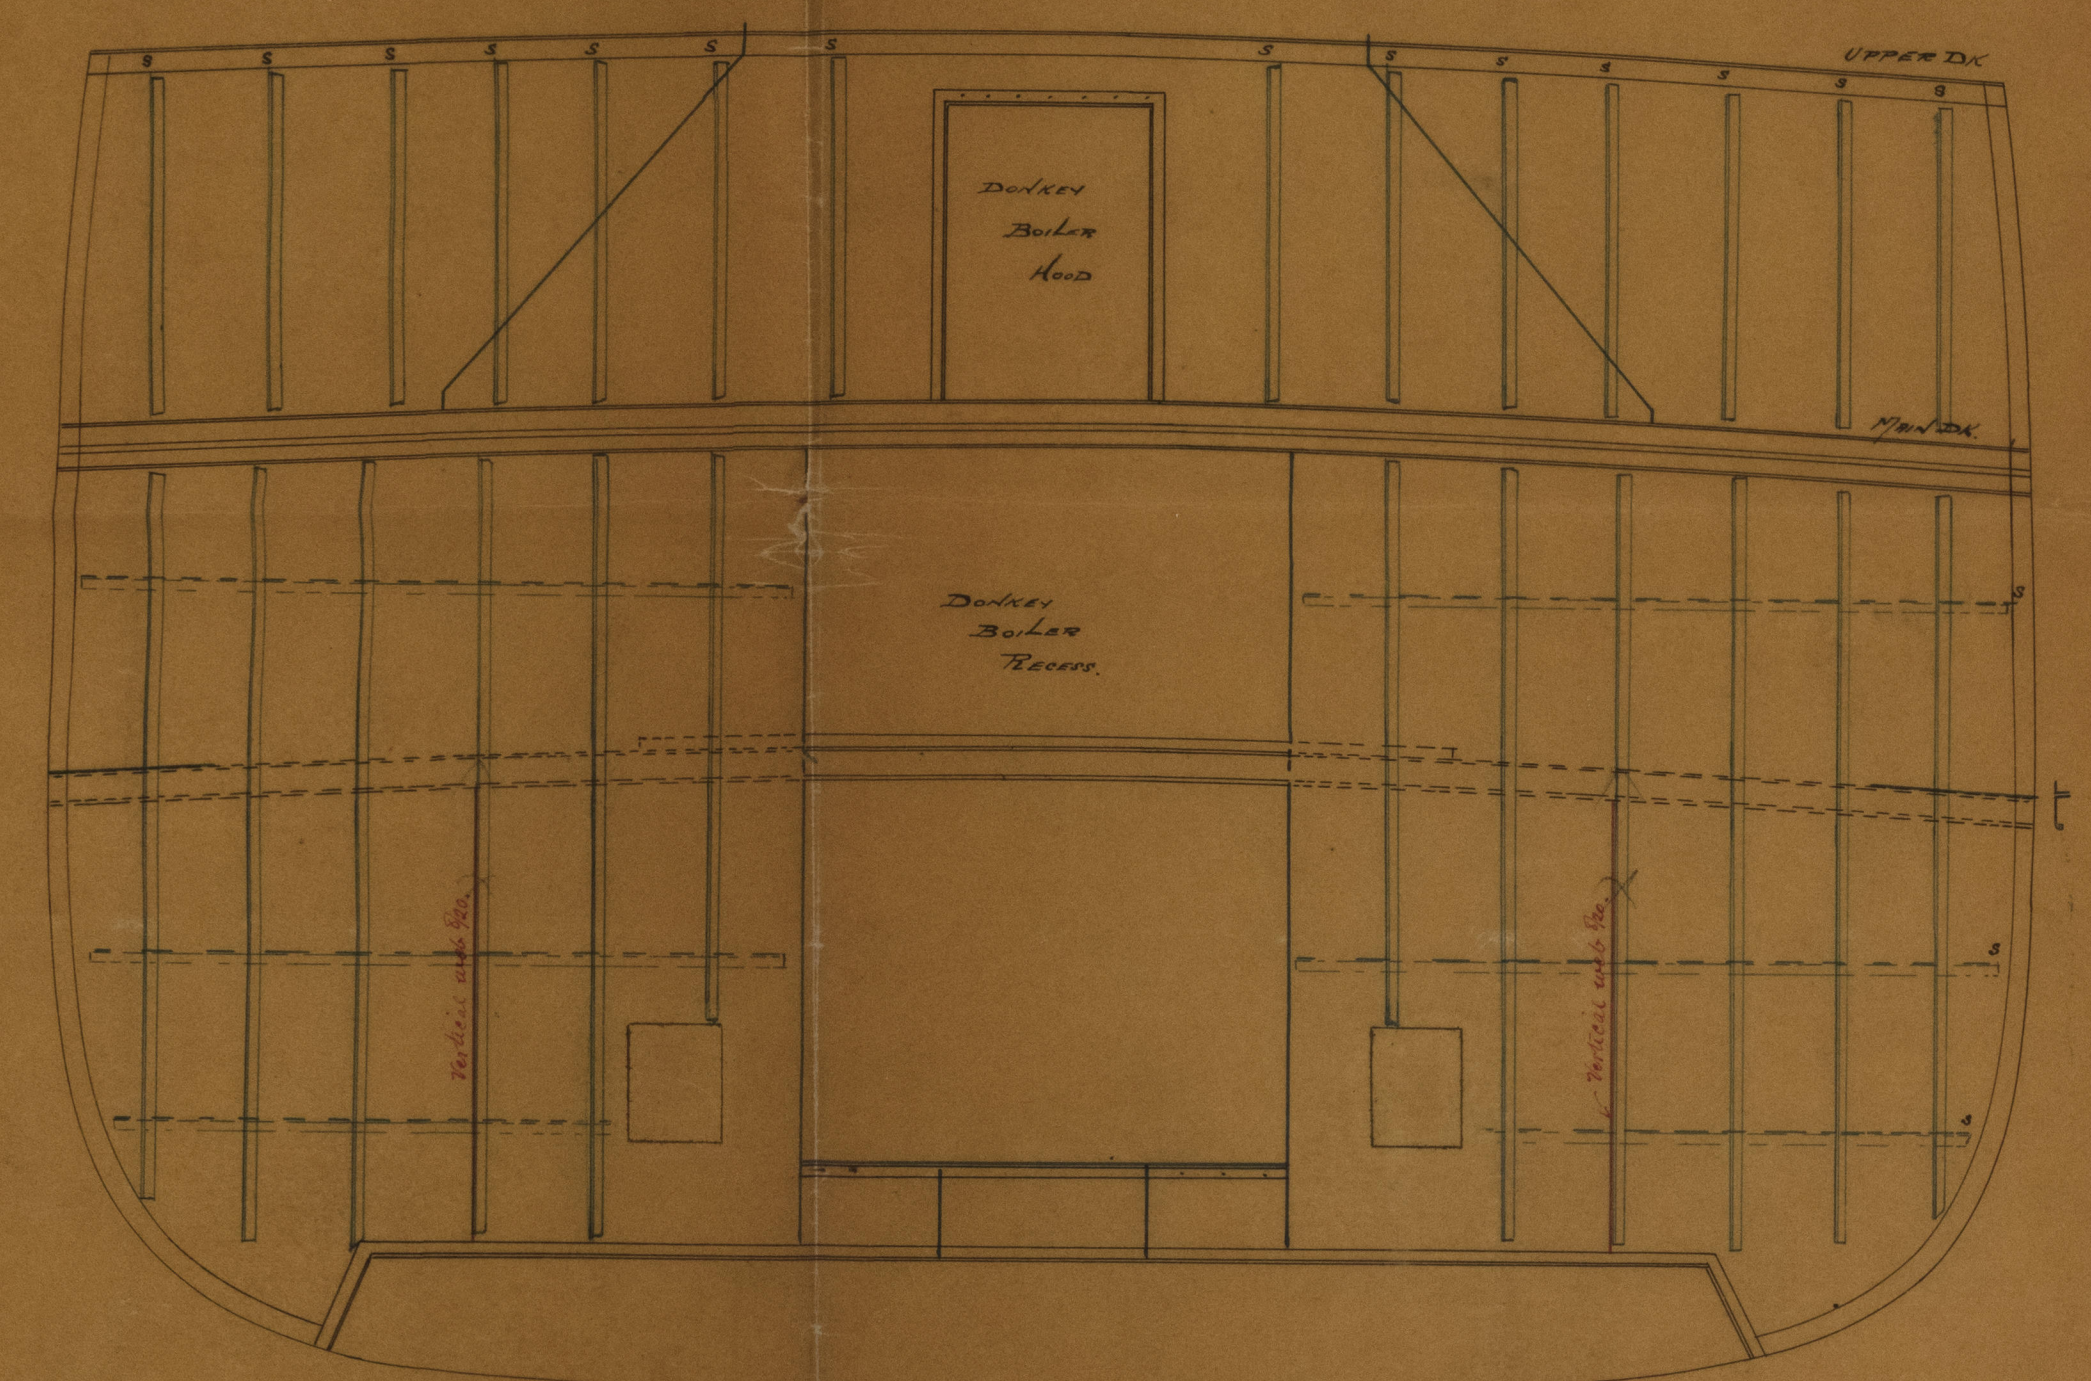

B.H.144.

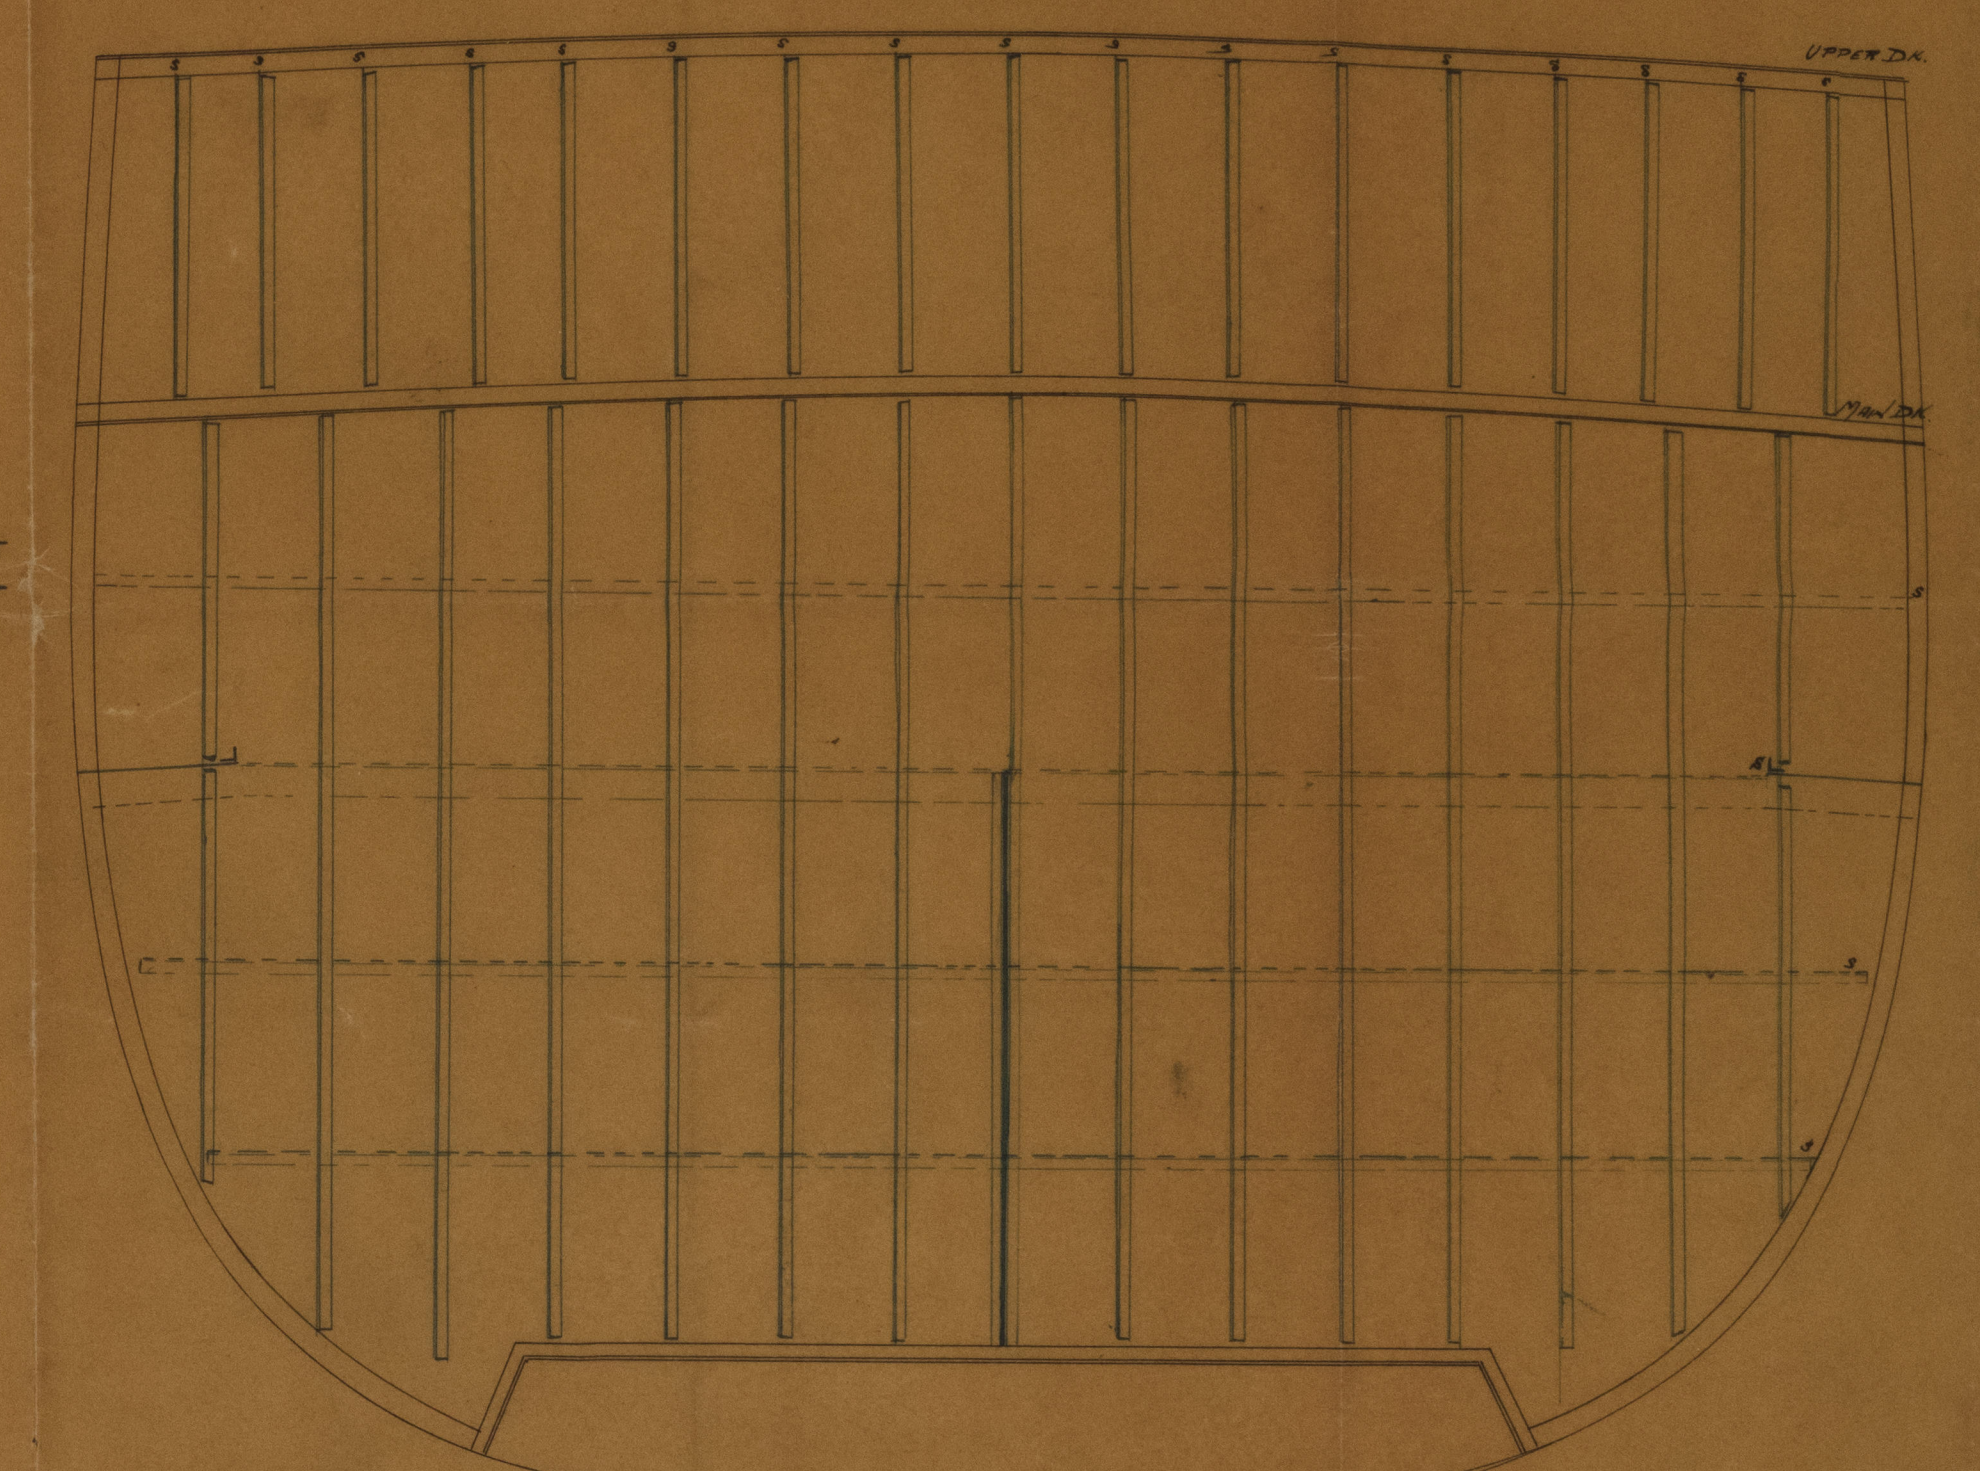

B.H.168

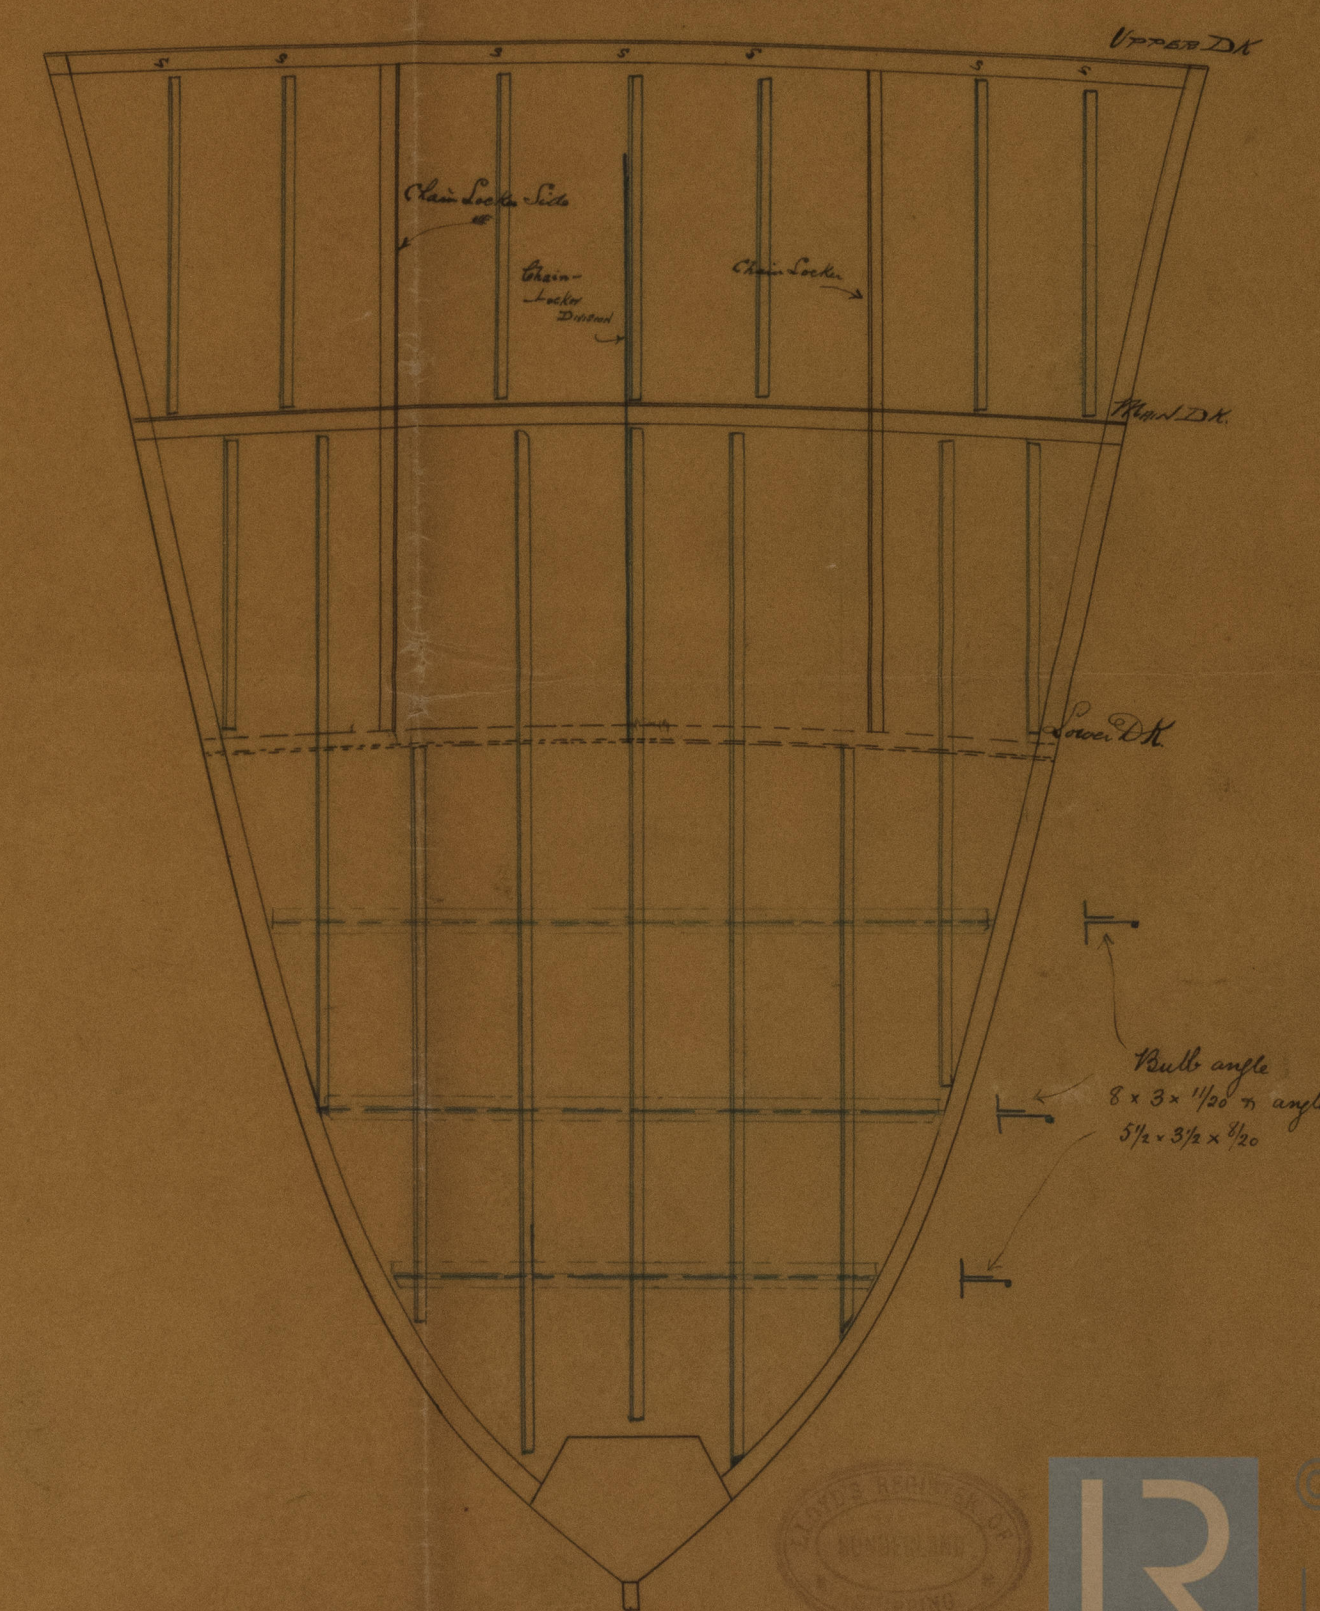

✓ p/2/c/s & shell ed
✓ p/2/p/01

Mannenberg

No. 173

Staud Shipb² Co.

Shipping &
Bulkheads



© 2021

Lloyd's Register
Foundation

SLD982 - 0049

SLV7DL-0017

5006