


"Warrenburg"
Flower Report No. 16646.

PROFILE SHOWING STIFFENING TO BULK HEADS

Nº 173 ⁵/₅

SCALE $\frac{1}{8}'' = 1 \text{ Foot.}$

Proposals in Red ink

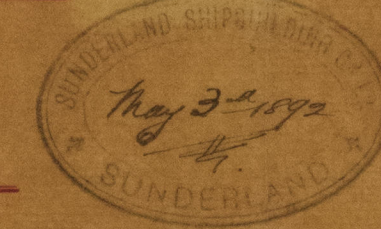

*No. 171

THIS BULKHEAD HAS
IRON PLAT 4T AND
SIDE OF IT AS ABOVE.

This bulkhead is supported on fore side by the engine seatings on the after side by tunnel recess & centre vertical web to main deck.

B.H. 70.

This bulkhead is supported on fore side of the donkey boiler
necess.

The bulkhead is
when stiffened by
the double horizontal
bars & is also supported
on fore side from fore peak
bulk tops to upper deck by
iron chain blocks.
B.H. 168.

Warrumbourne

No. 173







22.11.18



© 2021

SLD982

Lloyd's Register
Foundation