

Warrnambool  
Plans Report No. 16646.

4/11/91




Oct 15/91

— CAST STEEL RUDDER —

Nº 173 <sup>9/5</sup>

— SCALE  $\frac{1}{2}$ " = 1 FOOT —

— SKETCH OF COUPLING —  
— SCALE 1" = 1 FOOT —

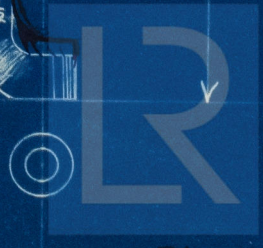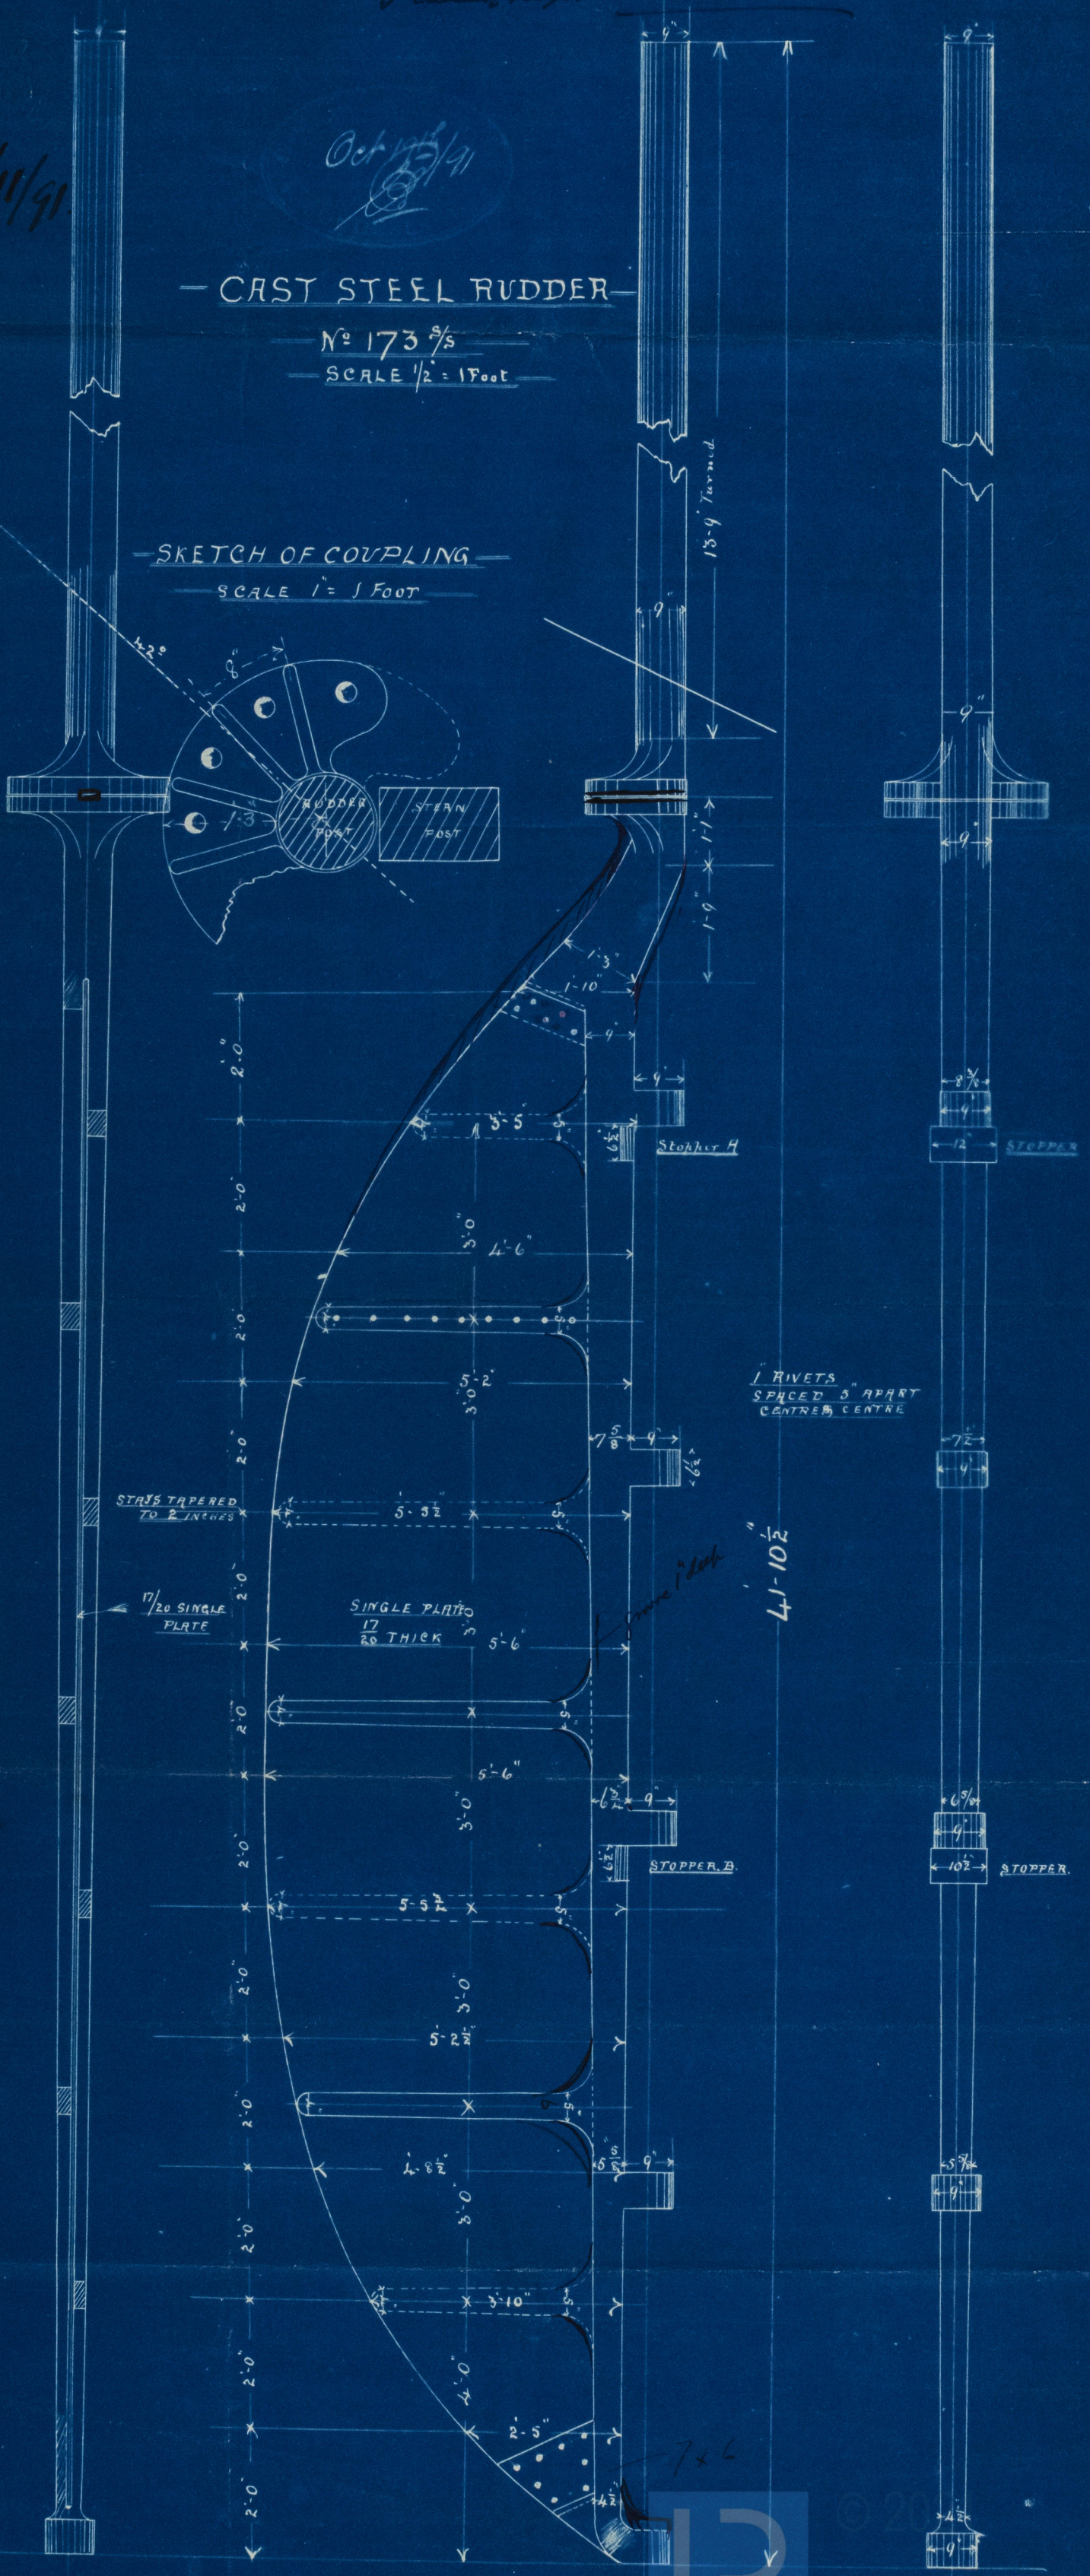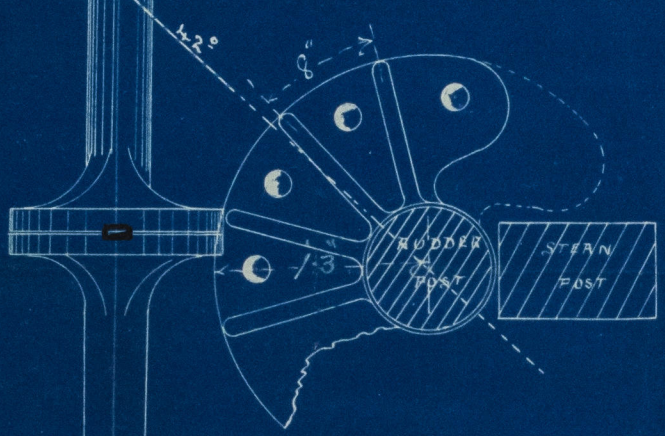

© 20 Lloyd's Register Foundation

SLD982-0052




*"Warrnambool"*

No. 173

Slane  
Sheep  
Co. (22)

East. Sheep Pudding

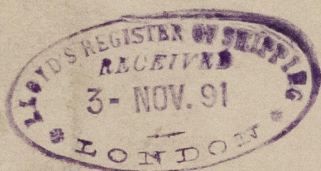

© 2021

Lloyd's Register  
Foundation

SLD982-0052