

Lloyd's Register of British and Foreign Shipping.

(Report on Vessel No. 16.625 Port SUNDERLAND.)

No 1199 SHIP FORGINGS OR CASTINGS.

I have to report that the undermentioned Iron ~~or Steel~~ Forgings ~~or Castings~~, manufactured by

Messrs Hawthorn Leslie & Co of Hebburn
for the Vessel No. 44, being built by Messrs J Priestman & Co
of Sunderland have been inspected by me as set forth below, and found
to be, so far as can be seen, sound

The words FORGINGS or CASTINGS, IRON or STEEL, should be struck out as may be required.


Mark on Forgings.

Lloyd's
No. 411B
96

John C Craig
Newcastle
13/2/92

	STERN FRAME.	RUDDER FRAME.	STEM.
Material*	<u>Scrap Iron</u>	<u>Scrap Iron</u>	<u>Scrap Iron</u>
How made	<u>Forged</u>	<u>Forged</u>	<u>Forged</u>
Dimensions	<u>10 - 6</u>	<u>8 - 4</u>	<u>10 - 2 3/4</u>
Progress on Inspection	<u>Forged & Smithed</u>	<u>Forged & Smithed</u>	<u>Smithed</u>
Dates when Inspected	<u>Feb 2-11-22-29</u> <u>March 3-8/92</u>	<u>May 29-17-20 June</u> <u>15-30 July 2/92</u>	<u>February 29/92</u>

SKETCHES OF FRAMES SHEWING POSITION AND DESCRIPTION OF WELDS OF FORGINGS, OR PARTICULARS OF TESTS APPLIED TO CASTINGS.

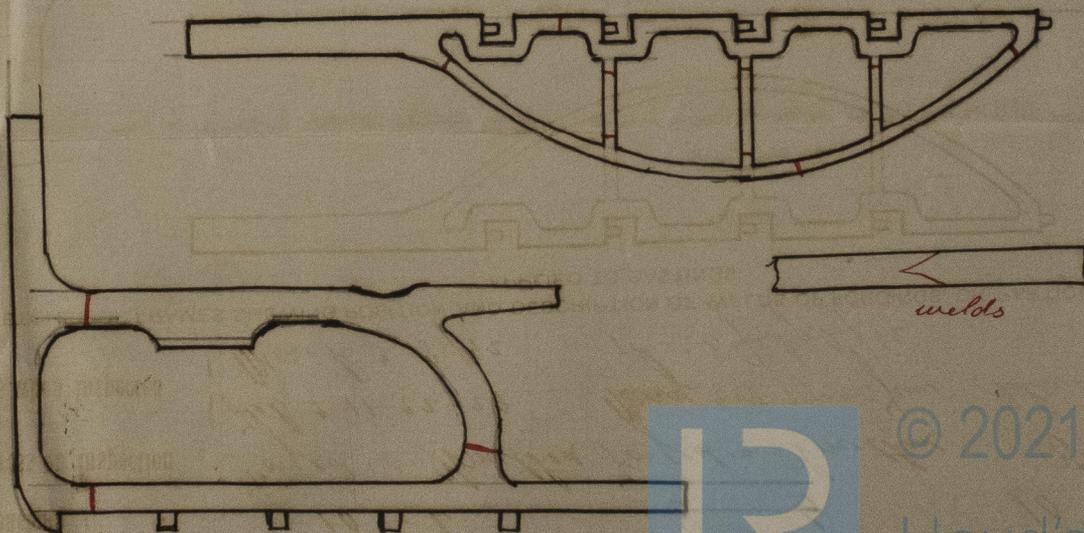

© 2021
Lloyd's Register
Foundation

* If of Iron, state whether scrap or puddled Iron.

led







© 2021

Lloyd's Register
Foundation