

Lloyd's Register of British and Foreign Shipping.

Land(Report on Vessel No. *16766* Port *SUNDERLAND.*)No. *2163.A*

SHIP FORGINGS OR CASTINGS.

The words FORGINGS or CASTINGS, IRON or STEEL, should be struck out as may be required.

I have to report that the undermentioned Iron or Steel Forgings or Castings, manufactured by *Mr Tho Ray* of *Pallion* for the Vessel No. *218*, being built by *Wm Port Borthus* of *Sunderland* have been inspected by me as set forth below, and found to be, so far as can be seen, *sound*.

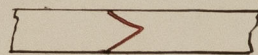
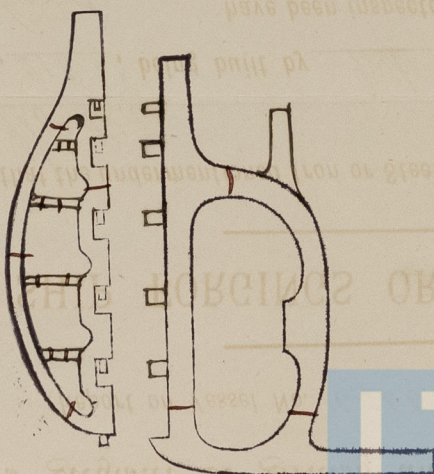
Mark on Forgings.

Lloyd's

No. *2163.A**Th. G.**Wm Port Borthus**Sunderland**11. 4. 92*

	STERN FRAME.	RUDDER FRAME.	STEM.
Material* - - -	<i>Scrap iron</i>	<i>Scrap iron</i>	<i>Scrap iron</i>
How made - - -	<i>Fused</i>	<i>Fused</i>	<i>Fused</i>
Dimensions - - -	<i>11' x 6 1/2"</i>	<i>8 1/2" - 4 1/4"</i>	<i>11' x 2 3/4"</i>
Progress on Inspection -	<i>Fused Limited</i>	<i>Fused Limited</i>	<i>Fused</i>
Dates when Inspected {	<i>July 13th & March 10th 92</i>	<i>May 3rd to July 8th 92</i>	<i>Feb 8th 92</i>

SKETCHES OF FRAMES SHEWING POSITION AND DESCRIPTION OF WELDS OF FORGINGS, OR PARTICULARS OF TESTS APPLIED TO CASTINGS.

*Welds*

© 2021

Lloyd's Register
Foundation