


3. 92

PLAN OF DECK PLATING S.S. N° 218
SCALE $\frac{1}{4}$ " = 1 FOOT

PLATING TINTED RED WHERE INCREASED IN THICKNESS.

 


SLD984-0069



SHORT BROS

S.S. N° 218

DECK PLAN

S. S. CONSTANCE

REPORT N° 16766

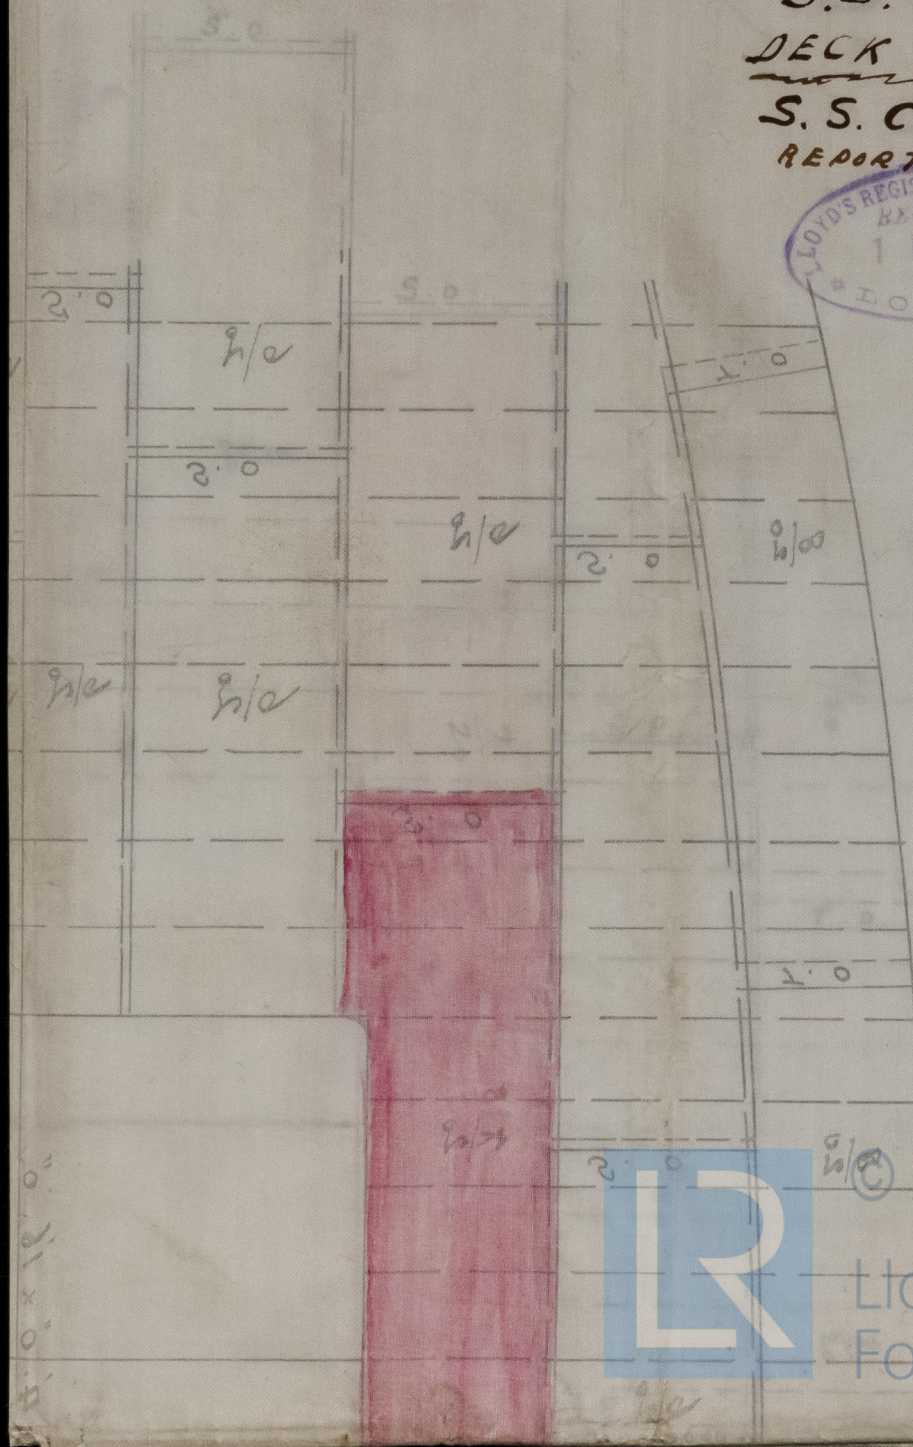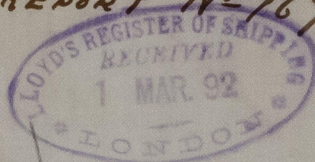

© 2021

Lloyd's Register
Foundation