


Dr. 27.4.92
 25.92

Lons 3840 Gross Reg.
 S.S. N° 218

PUMPING ARRANGEMENT
 S.S. N° 218

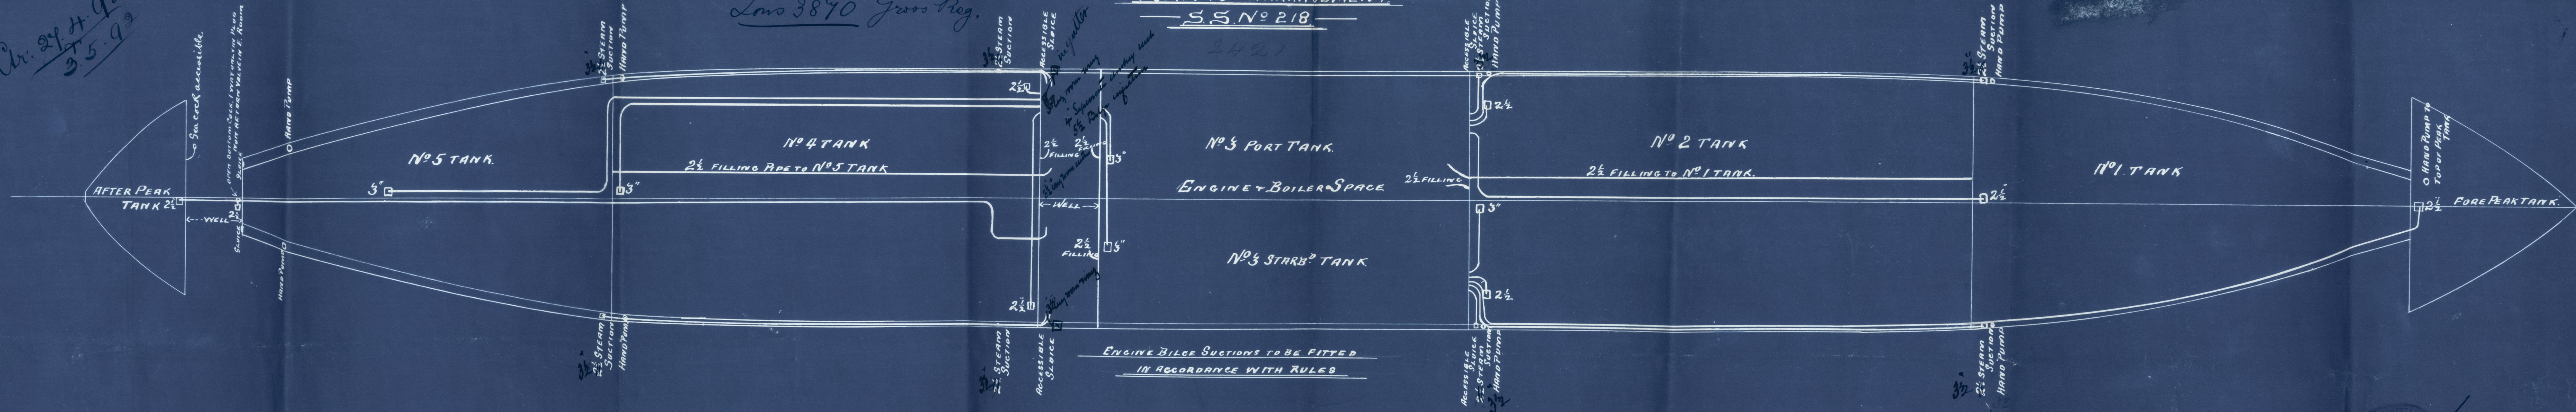

W.A.
 27.4.92
 25.92. hold suction 3rd



SHORT BROTHERS
 SHIPBUILDERS

SUNDERRY

SHORT. BROS

S/s N^o 218.

PUMPING ARRANGEMENTS

S. S. "CONSTANCE"

- REPORT N^o 16766 -



© 2021

Lloyd's Register
Foundation

SLD984-0070