

12.8.92  
14.5.92


# PLAN OF DECK PLATING

— RAISED QUARTER DECK —

SS N° 223.

SCALE  $\frac{1}{4}$ " = 1 FOOT.

— MAIN DECK. —

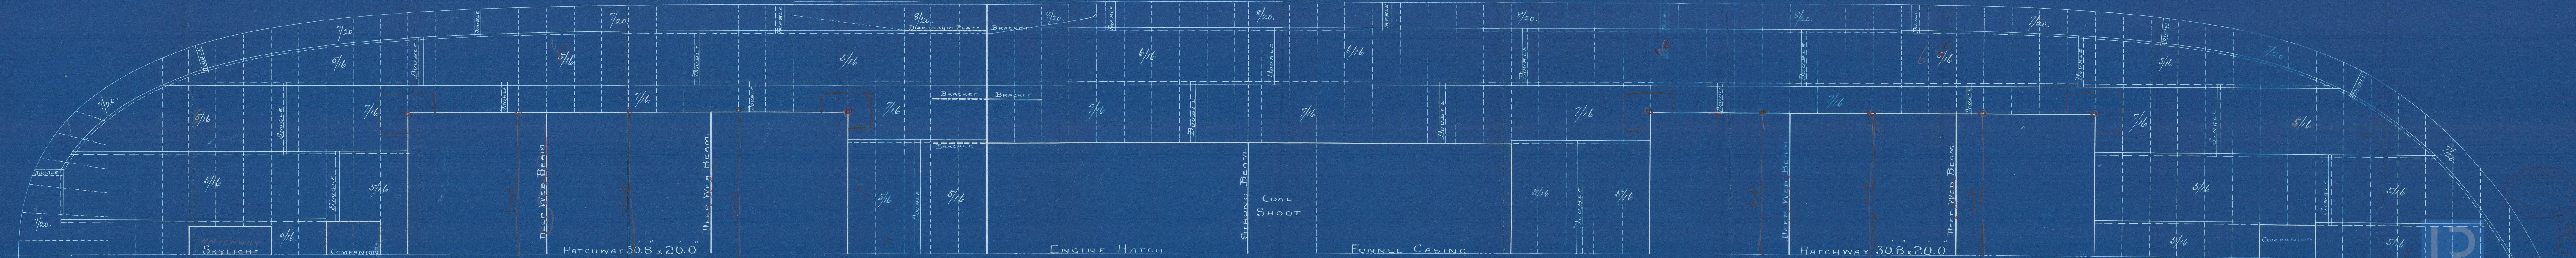

SL0985-0001

SHORT BROTHERS  
SHIPBUILDERS  
SUNDERLAND  
9/18/92  
9/18/92



SHORT BROS.

STEEL S.S. № 223

- DECK PLAN -

"Ratcliff"

- Report № 16799.

112 AUG. 92

LONDON

SLD985-0001



© 2021

Lloyd's Register  
Foundation