

MIDSHIP SECTION
S.S. No 223
DIMENSIONS

LENGTH PER RULE	168.10
BREADTH D°	35.10
DEPTH OF HOLD TO TANK TOP	13.11 ^L / ₂
DEPTH MOULDED	16.0
CLASSIFICATION	100 A1 "STEEL"

$\frac{1}{2}$ GIRTH 32.06
 $\frac{1}{2}$ BREADTH 17.91
 DEPTH 16.70
 $66.67 \times 168.83 = 11.255$
 10.10 DEPTHS IN LENGTH
 4.7 BREADTHS "




SHORT BROTHERS
SHIPBUILDERS

of Ratcliff report 16499
SHORT BROS.

S.S. 223

MID. SECTION

SUNDERLAND

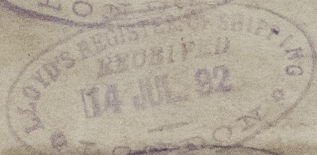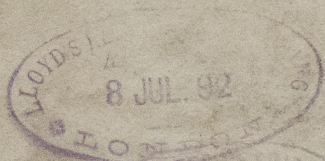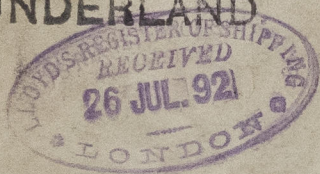

SLD985-0002



© 2021

Lloyd's Register
Foundation