


27-10-92

PUMPING ARRANGEMENT.

SS No 223.

SCALE $\frac{1}{8}$ = ONE FOOT.

From Lomax under 1000

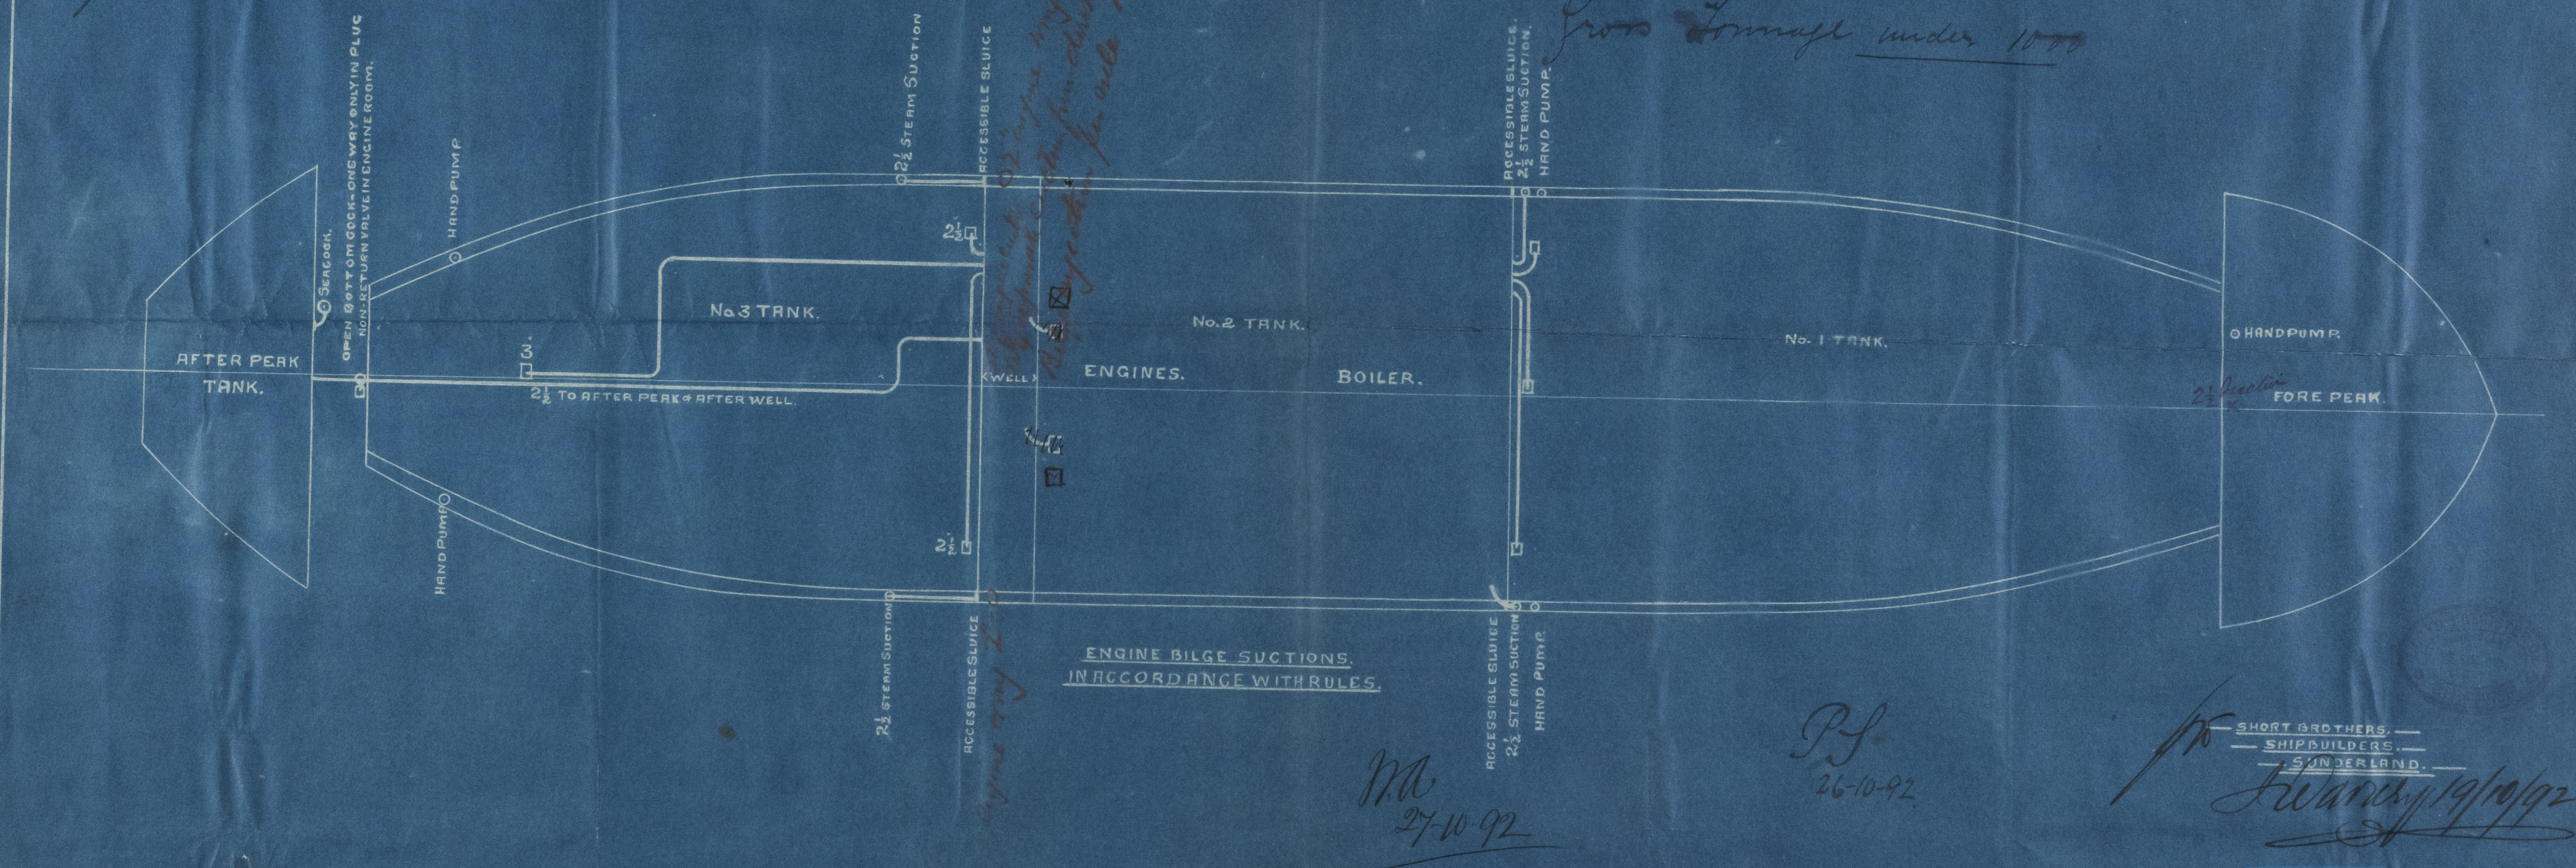

ENGINE BILGE SUCTIONS.
IN ACCORDANCE WITH RULES.

MA
27-10-92


P.S.
26-10-92.

SHORT BROTHERS,
SHIPBUILDERS,
SUNDERLAND.

W. H. H. H.
19/10/92



Lloyd's Register
Foundation

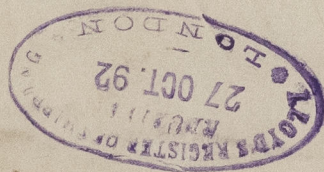

Thos Bros 223
Pumping plan
"Ratchiff"
NR. No. 16799

SLD985 - 0003



© 2021

Lloyd's Register
Foundation