
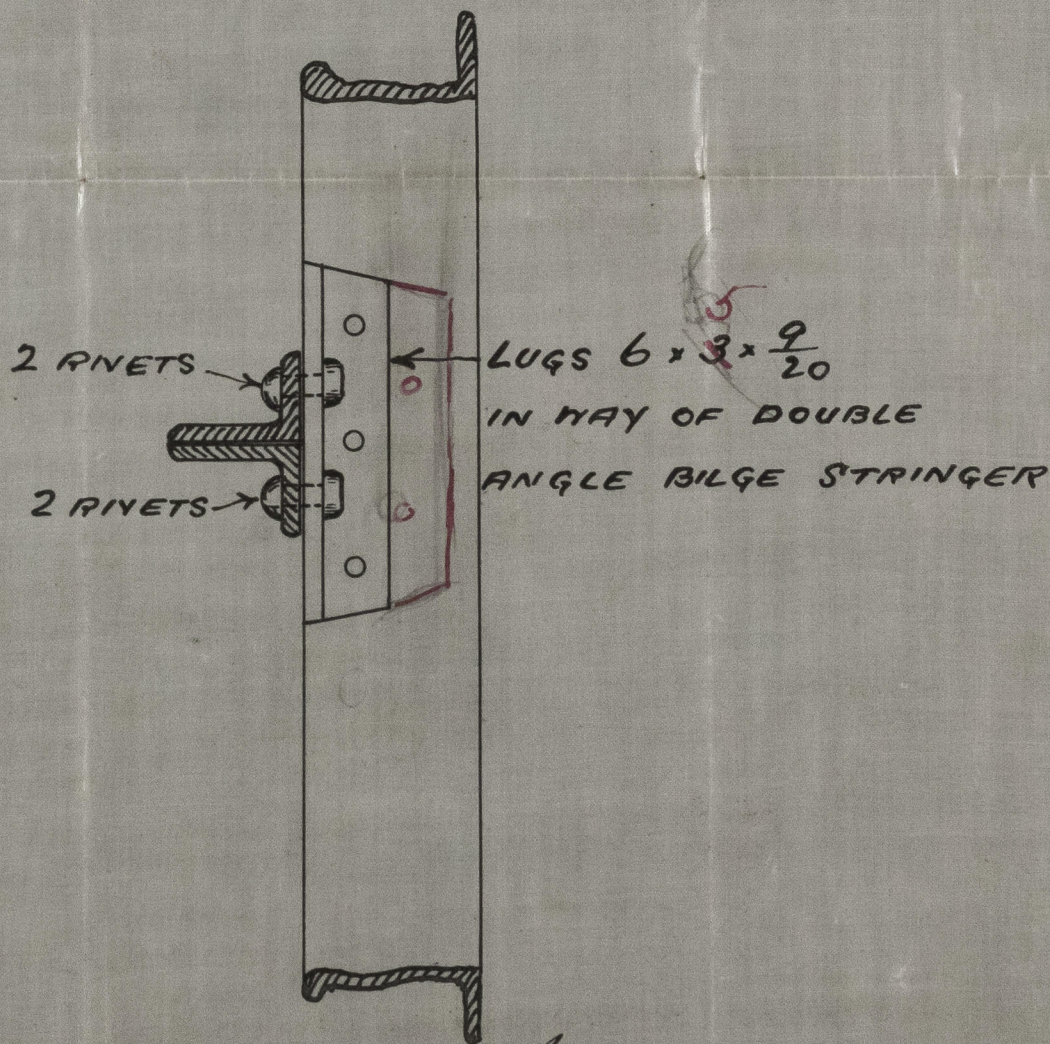


Dr. 19.7.92
18.8.92

Nº 223

SKETCH SHEWING CONNECTION OF DOUBLE
ANGLE BILGE STRINGER TO BULB ANGLE FRAMES.

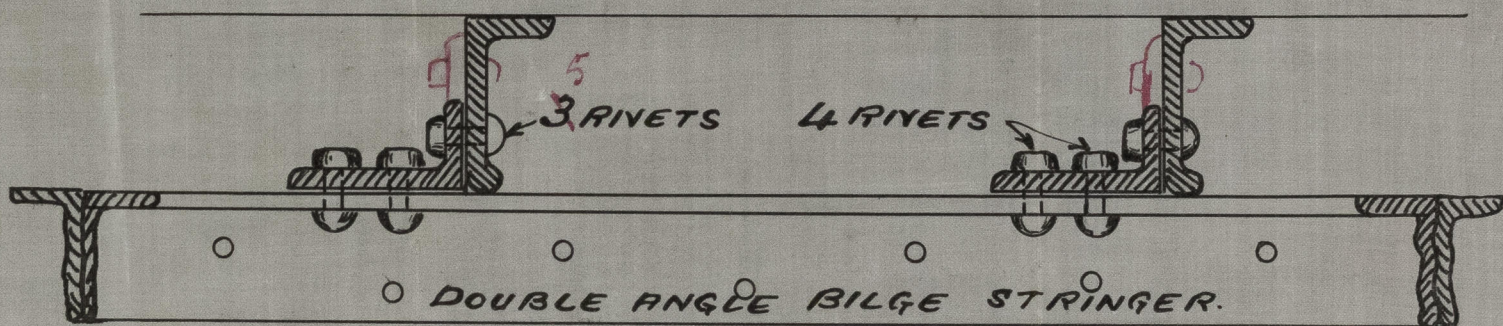

SHORT BROTHERS
SHIPBUILDERS

SUNDERLAND.

Waney 16-7-92



Lloyd's Register
Foundation


SLD985-0004

SL0985-0004


Double angle Struier
RATCHIFF
-Report No 16799-

50.7.01
50.8.01

Sketch showing connection of double
angle steel struier to angle frames.

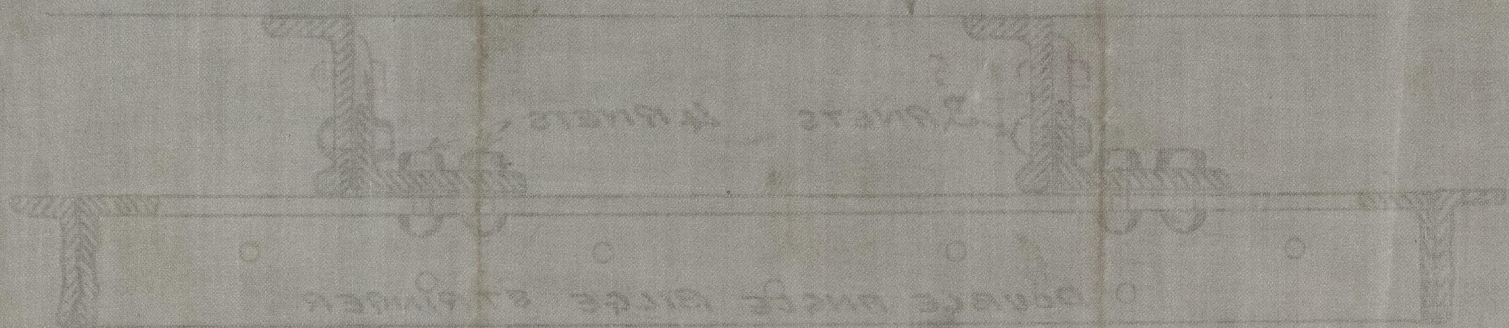

Sketch showing
in plan of double
angle steel struier

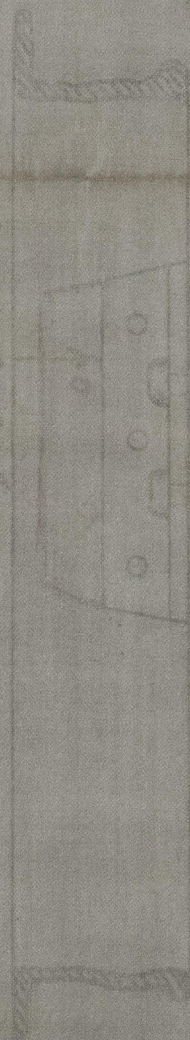

Sketch showing
in plan of double
angle steel struier




© 2021

Lloyd's Register
Foundation