

## Lloyd's Register of British and Foreign Shipping.

(Report on Vessel No. 16799 Port 8 **SUNDERLAND.**)No. 1334

## SHIP FORGINGS OR CASTINGS.

The words FORGINGS or CASTINGS, IRON or STEEL, should be struck out as may be required.

I have to report that the undermentioned Iron ~~or Steel~~ Forgings ~~or Castings~~, manufactuerd by

Messrs Hawthorn Leslie & Co of Hebburn  
 for the Vessel No. 223, being built by Messrs Short Brothers  
 of Sunderland have been inspected by me as set forth below, and found  
 to be, so far as can be seen, sound

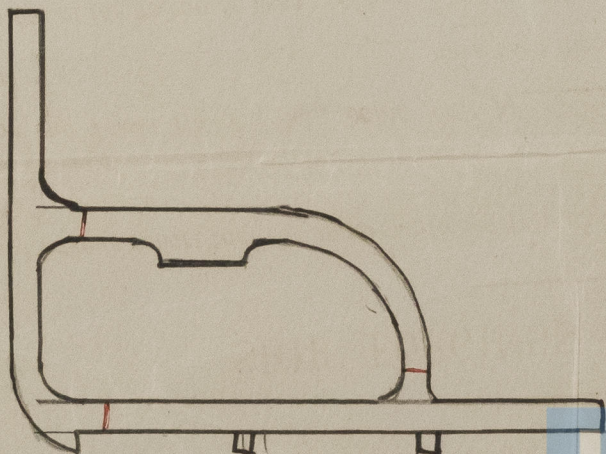
Mark on Forgings.

Lloyd's

No 1926B96John C CraigNewcastle7/11/92

	STERN FRAME.	RUDDER FRAME.	STEM.
Material* . . . .	<u>Scrap Iron</u>	/	
How made . . . .	<u>Forged</u>		
Dimensions . . . .	<u>7 - 4 1/4</u>		
Progress on Inspection .	<u>Forged &amp; Smoothed</u>		
Dates when Inspected	<u>July 29 August 8</u> <u>15/92</u>		

SKETCHES OF FRAMES SHEWING POSITION AND DESCRIPTION OF WELDS OF FORGINGS, OR PARTICULARS OF TESTS  
 APPLIED TO CASTINGS.

welds