

dia length  
**STEEL BOILER 9'0" x 10'0"**

Scale 1" = 1 Foot

LLOYDS & B.O. TRADE 80 LBS <sup>W.P.</sup>



(SUNDERLAND SHIP-BUILDING CO. LTD)  
177 S.S.

700 <sup>H</sup> HEATING SURFACE

**THOS SUDRON & CO LTD**  
IMPERIAL BOILER WORKS  
STOCKTON-ON-TEES




Note: Each ring of shell in two plates in circumference

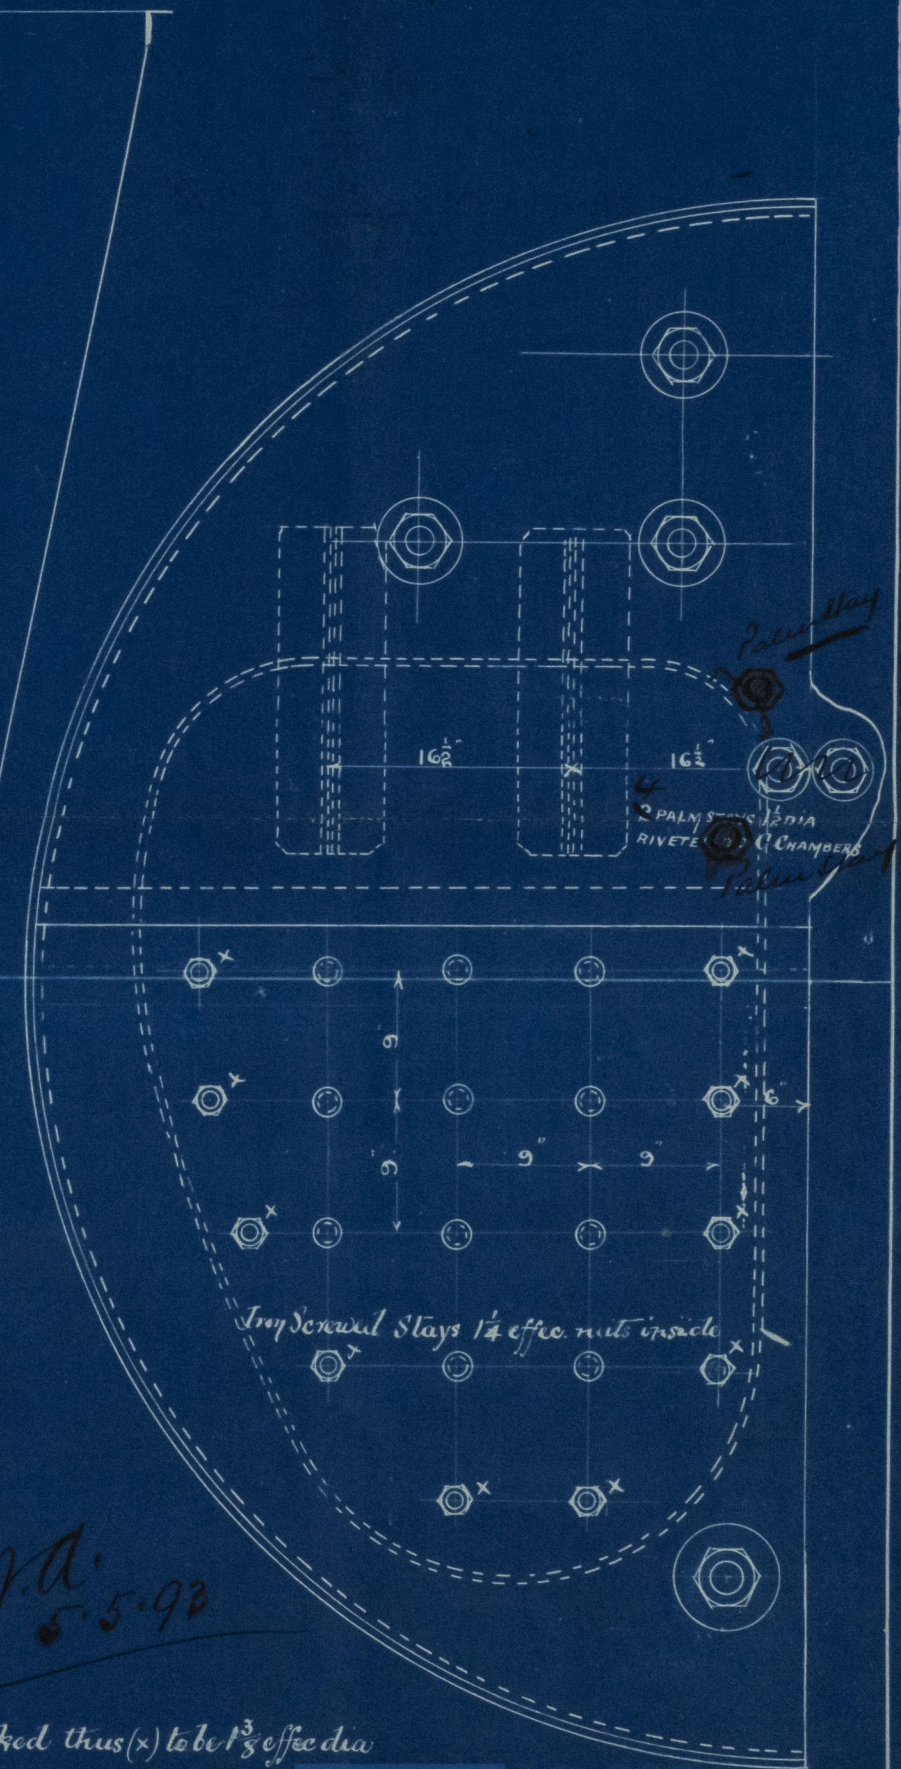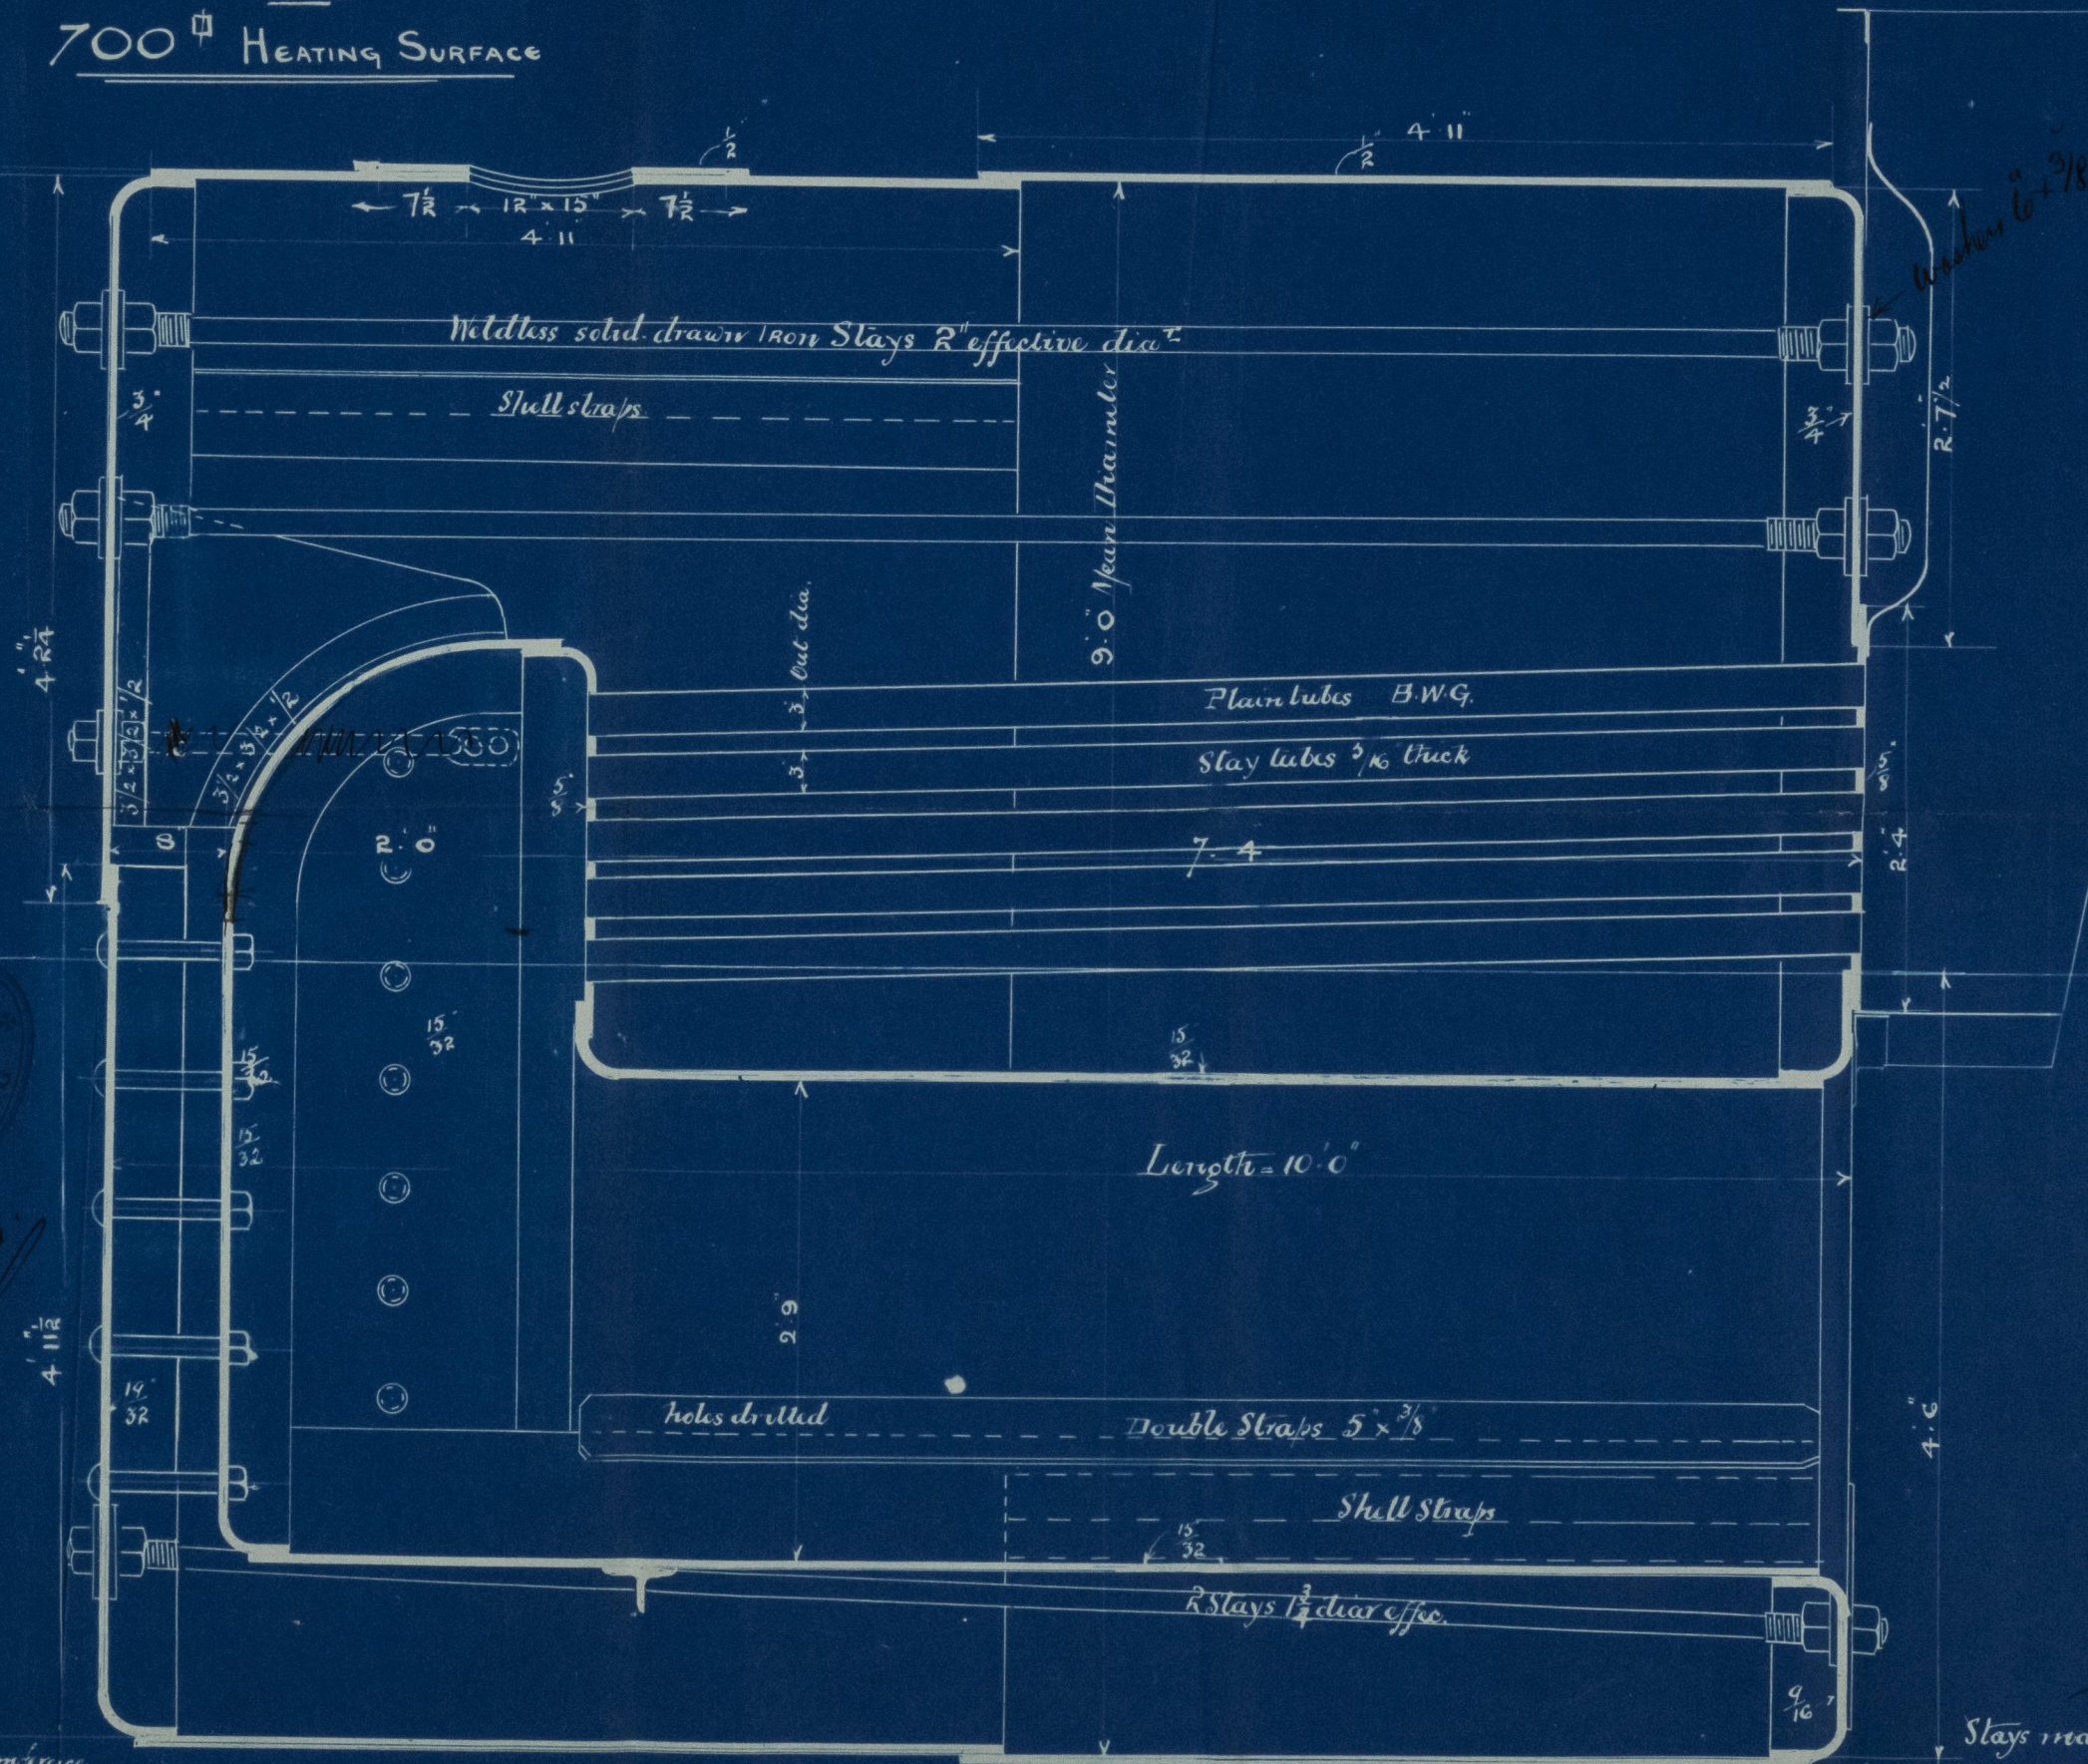

Stays marked thus (x) to be 1 3/8 eff dia  
nutted inside vent.



Donkey boiler  
by  
J. Sudron & Co<sup>ies</sup>  
for  
Sunderland Shipg<sup>y</sup> Co<sup>ies</sup>

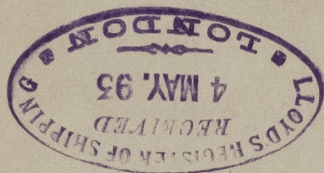

s/s Harrigal  
N<sup>o</sup>. 28,961

SK0987-0124



© 2021

Lloyd's Register  
Foundation