

88 No 525

class. 100 K1 at Lloyds Spar Decked

Scale $\frac{1}{2}$ inch = to 1 Foot

Proportions

11.93 Depths in length to Spar dk ✓
16.57 Depths in length to Mann dk ✓
7.45 Breadths in length ✓

1/2 Girth	---	34.08
1/2 Breadth	---	20.00
Depth	---	<u>18.00</u>

$$72.08 \times 298.33 = 21503 \checkmark$$







Equipment

1/2 length 41.08
1/2 Breadth 20.00
Depth 25.00
86.08 x 298.33
= 25680

Poop 50 } 1162
 Bridge 58 } 26842

James Laing
Deptford Yards
Sunderland

J. LAING'S
- S.S. N^o 525 -
MIDSHIP SECTION
S.S. UMFULI

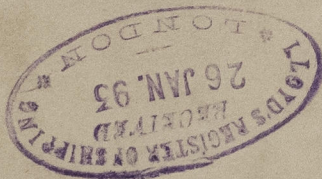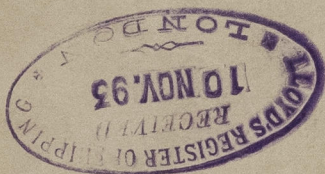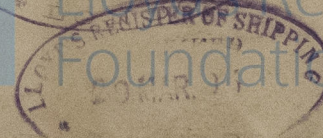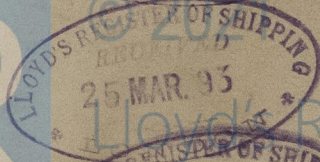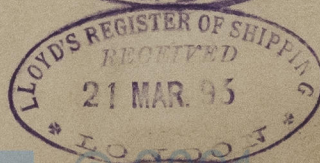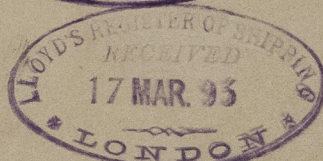

SLD988-0182



Lloyd's Register
Foundation