


22-2-93
14.8.93

S.S. N^o 525

Scale $\frac{1}{8}$ " = one foot.

*See corrected plan enclosed
W.L.S.*
*J. S. Kempster
Sunderland Report No 7/112*

SHIPPING
16-2-93
SUNDERLAND

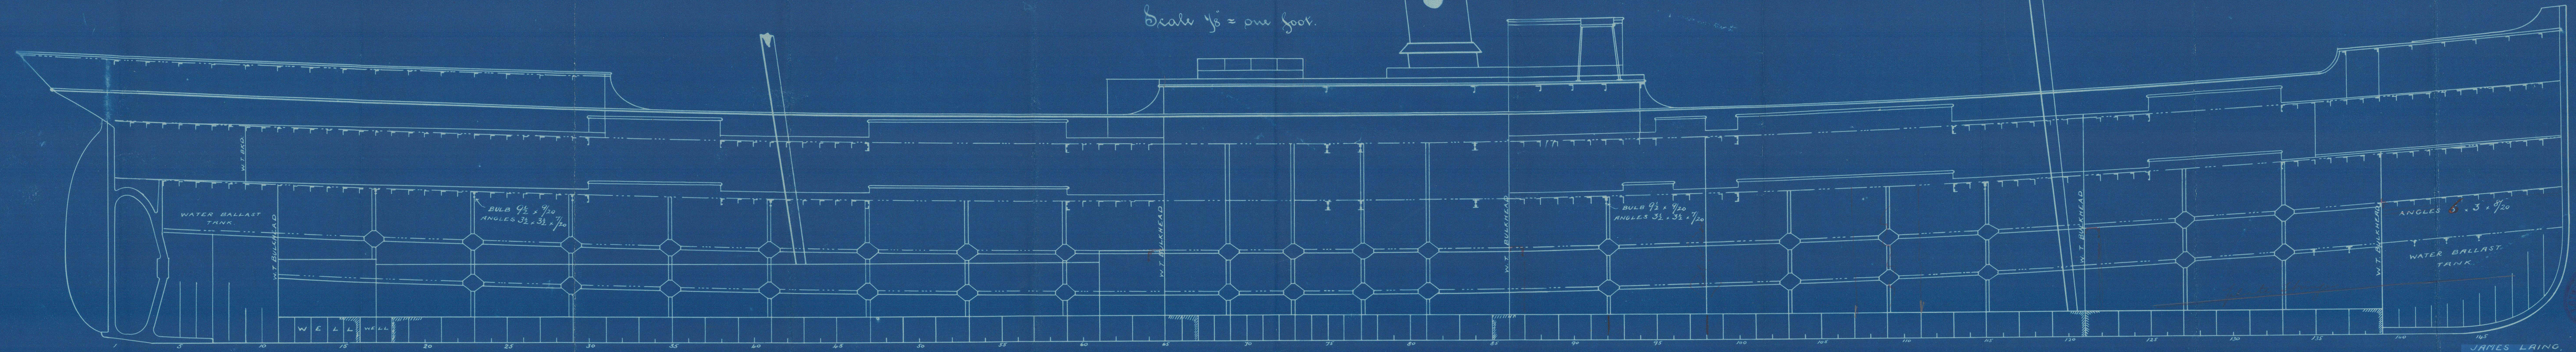




JAMES LAING,
DEPTFORD YARDS,
SUNDERLAND.

Lloyd's Register
50988-0184

J. LAING'S
- S.S. No 525 -

1 PROFILE

J. S. Umfeli
See corrected profile
as before

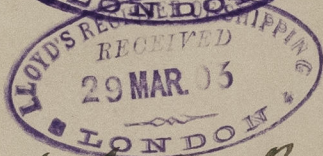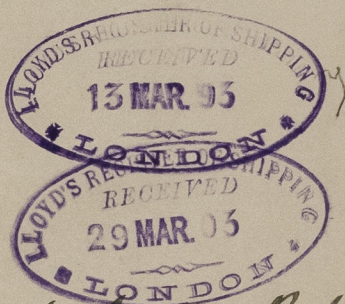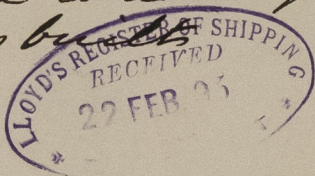

Sunderland Report
No. 17162.



© 2021

Lloyd's Register
Foundation

SLD 988-0184