

14.3.93
22.3.93

S.S. Unifali
Sunderland Report No 17162


S.S. No 525

SCALE $\frac{1}{4}$ " = 1 FOOT

Rule size of Stringer $4\frac{1}{2}$ " x $10\frac{1}{2}$ "
now made 52 inches

Quadruple
rivetted


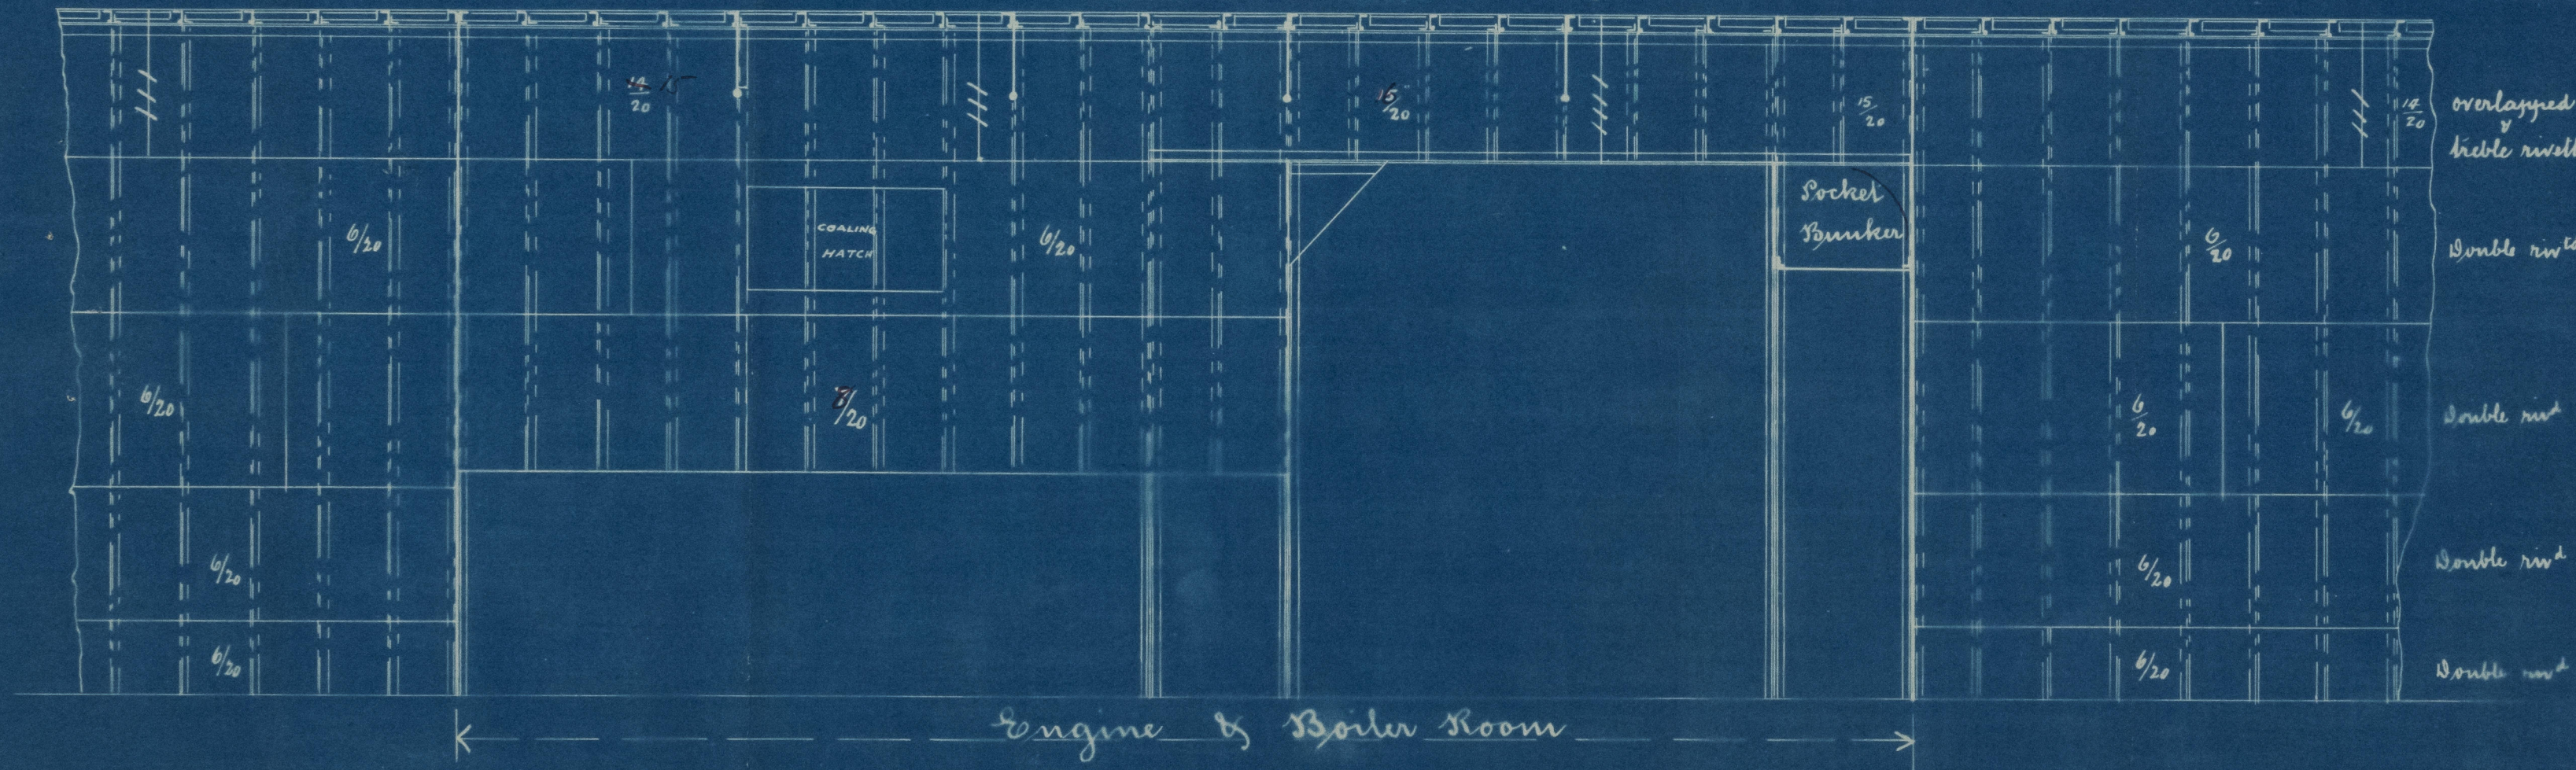

Arrangement of Main Deck Plating
abreast Engine & Boiler Room



Lloyd's Register
Foundation

SLP988-0185

Lamps 525

Deck Plate

J. S. Humphreys



Sunderland Report
No 17162



© 2021

Lloyd's Register
Foundation

SLD988-6185